

ELECTRICAL & CONST.

CONSTRUCTION SUMMARY - PARTIAL ONLY
Mountainview Heights 3 (G) - Russell Gardens Building Ltd.

PURCHASERS: Moneer Abdelwahid and Mona Hameid TEL:

LOT NUMBER	PHASE	HOUSE TYPE	REG. PLAN #		
513	4	Valleycreek Three Elev 3	62M-1266		

INV#	QTY	EXTRA / CHANGE
------	-----	----------------

Offer	Note:
-------	-------

ELECTRICAL

25,842 22Jul21	1 - 200 AMP ELECTRICAL SERVICE Note:
26,866 16Mar22	1 - PLUG - ELECTRICAL PLUG WITH GFI AND SWITCH - FOR FESTIVE LIGHTING Note:
26,866 16Mar22	12 - POT LIGHT - LED - FIRST FLOOR INSTALLATION - SEE SKETCH Note:
26,866 16Mar22	1 - PLUG - ELECTRICAL PLUG - TO BE INSTALLED OVER FIREPLACE Note:
26,866 16Mar22	1 - PLUG - ELECTRICAL PLUG WITH GFI AND SWITCH - FOR FESTIVE LIGHTING Note:
26,866 16Mar22	7 - POT LIGHT - EXTERIOR - SOFFIT MOUNT - REGULAR VOLTAGE Note: SKETCH UPDATED - SEE ATTACHED
26,866 16Mar22	2 - SWITCH - DIMMER SWITCH IN LIEU OF EXISTING SWITCH - PRICE IS EACH NoteDINING ROOM-AND FAMILY ROOM-
26,866 16Mar22	1 - BUILT IN OVEN AND COOKTOP PROVISION - PROVISION ONLY - ELECTRICAL ONLY Note:




This Document is Extremely Time Sensitive - Printed 12 Apr 23 at 9:14



ELEVATION 2 • 2,773 sq.ft.

Lot 513 Russell Gardens

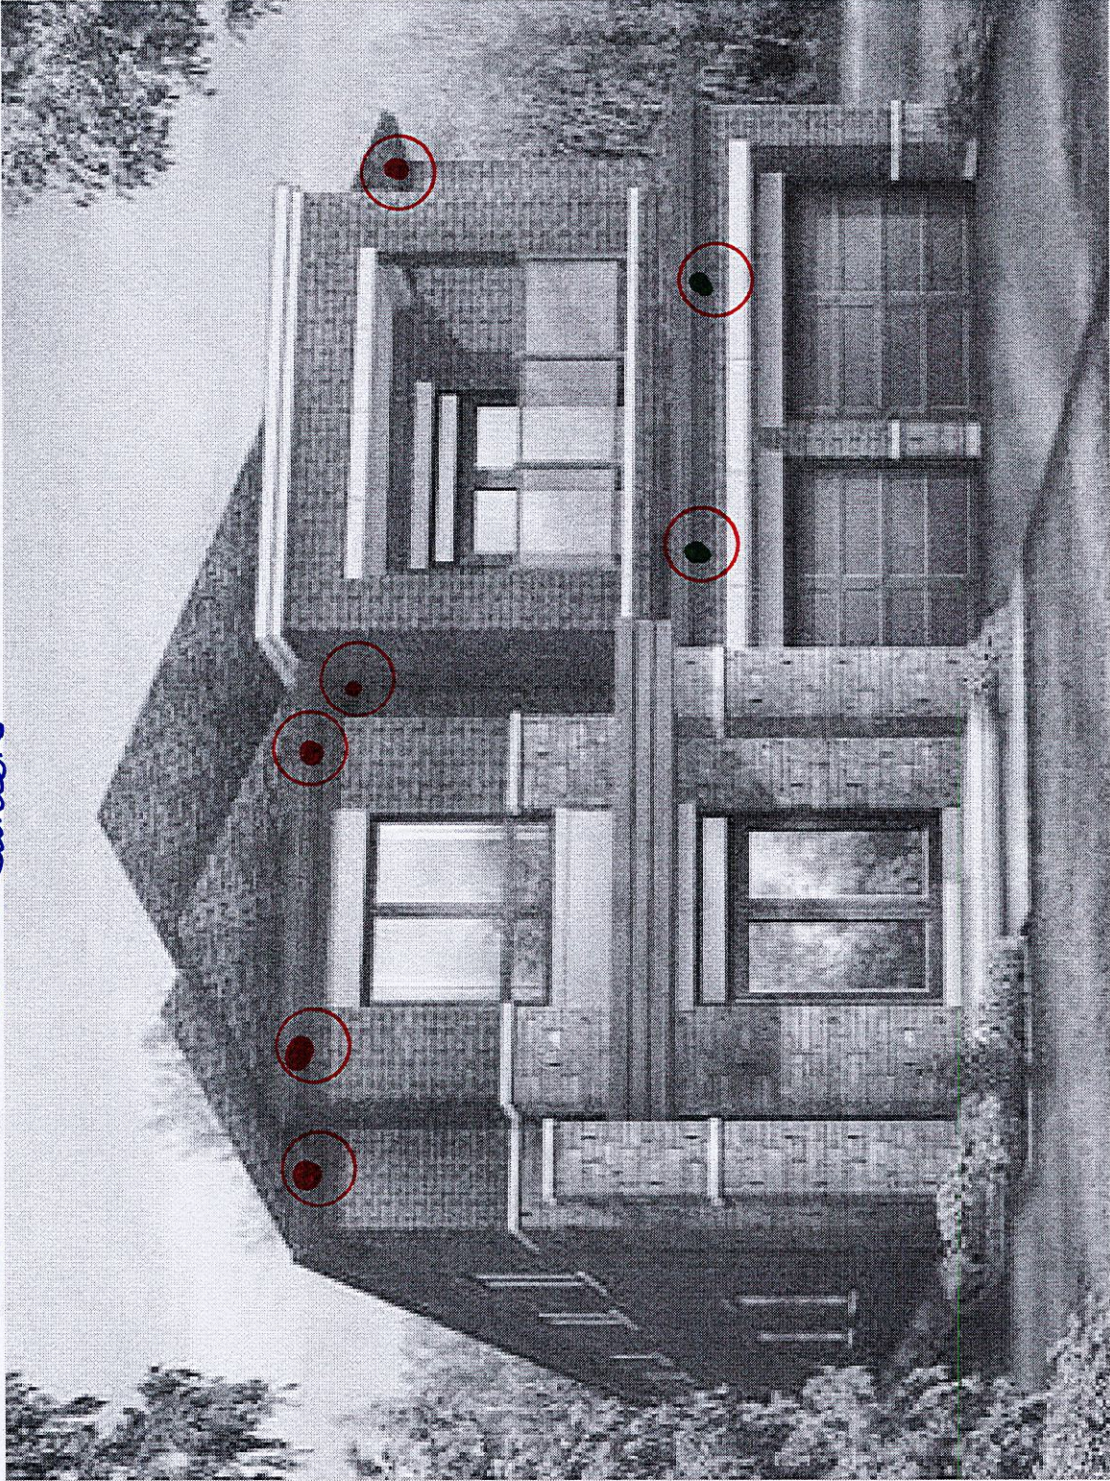

ELEVATION 3 • 2,758 sq.ft.

APRIL 12/23