

CONSTRUCTION SUMMARY

Hazel Glenn - Barlassina Construction Inc.

PURCHASERS: Vijayant Singh ROPARIA and Nishu GODARA

TEL: RES.: 431-998-1234

LOT / PHASE Block 121 TH7 / 1	REG. PLAN #	HOUSE TYPE Cherry 3E Elev 1		
----------------------------------	-------------	--------------------------------	--	--

CONSTRUCTION

1 - SMOOTH CEILINGS FIRST FLOOR ONLY 11Apr23 Note:	
---	--

ELECTRICAL

1 - PLUG - ELECTRICAL PLUG - 5 FEET FROM FINISHED FLOOR FOR FUTURE WALL MOUNTED TV - SEE SKETCH 11Apr23 Note:	
1 - LIGHT AND SWITCH - NO FIXTURE INCLUDED - LIVING ROOM 11Apr23 Note:	
1 - ABOVE KITCHEN ISLAND - ADD LIGHT AND SWITCH - NO FIXTURE INCLUDED 11Apr23 Note:	

FIREPLACE AND ACCESSORIES

1 - GAS LINE ROUGH-IN FOR STOVE (INCLUDES ELECTRICAL OUTLET) - FIRST FLOOR 11Apr23 Note:	
---	--

PLUMBING


1 - WASHROOM - 3 PIECE ROUGH-IN IN BASEMENT 11Apr23 Note:	
1 - WATER LINE FOR FRIDGE - ROUGH-IN ONLY 11Apr23 Note:	

PROMOTIONAL

1 - PARTIAL REDEMPTION OF PROMOTIONAL PACKAGE \$6,170 BALANCE FORWARD \$3,830 TO BE USED AT A LATER DATE. ORIGINAL PROMOTIONAL PACKAGE OF \$10,000 AS PER SCHEDULE PE. 11Apr23 Note:	
---	--

This Document is Extremely Time Sensitive - Printed 11 Apr 23 at 10:29

Cherry 3E
ELEVATION 1 & 2 - 2,154 sq.ft.
Includes 14 sq.ft. of open area

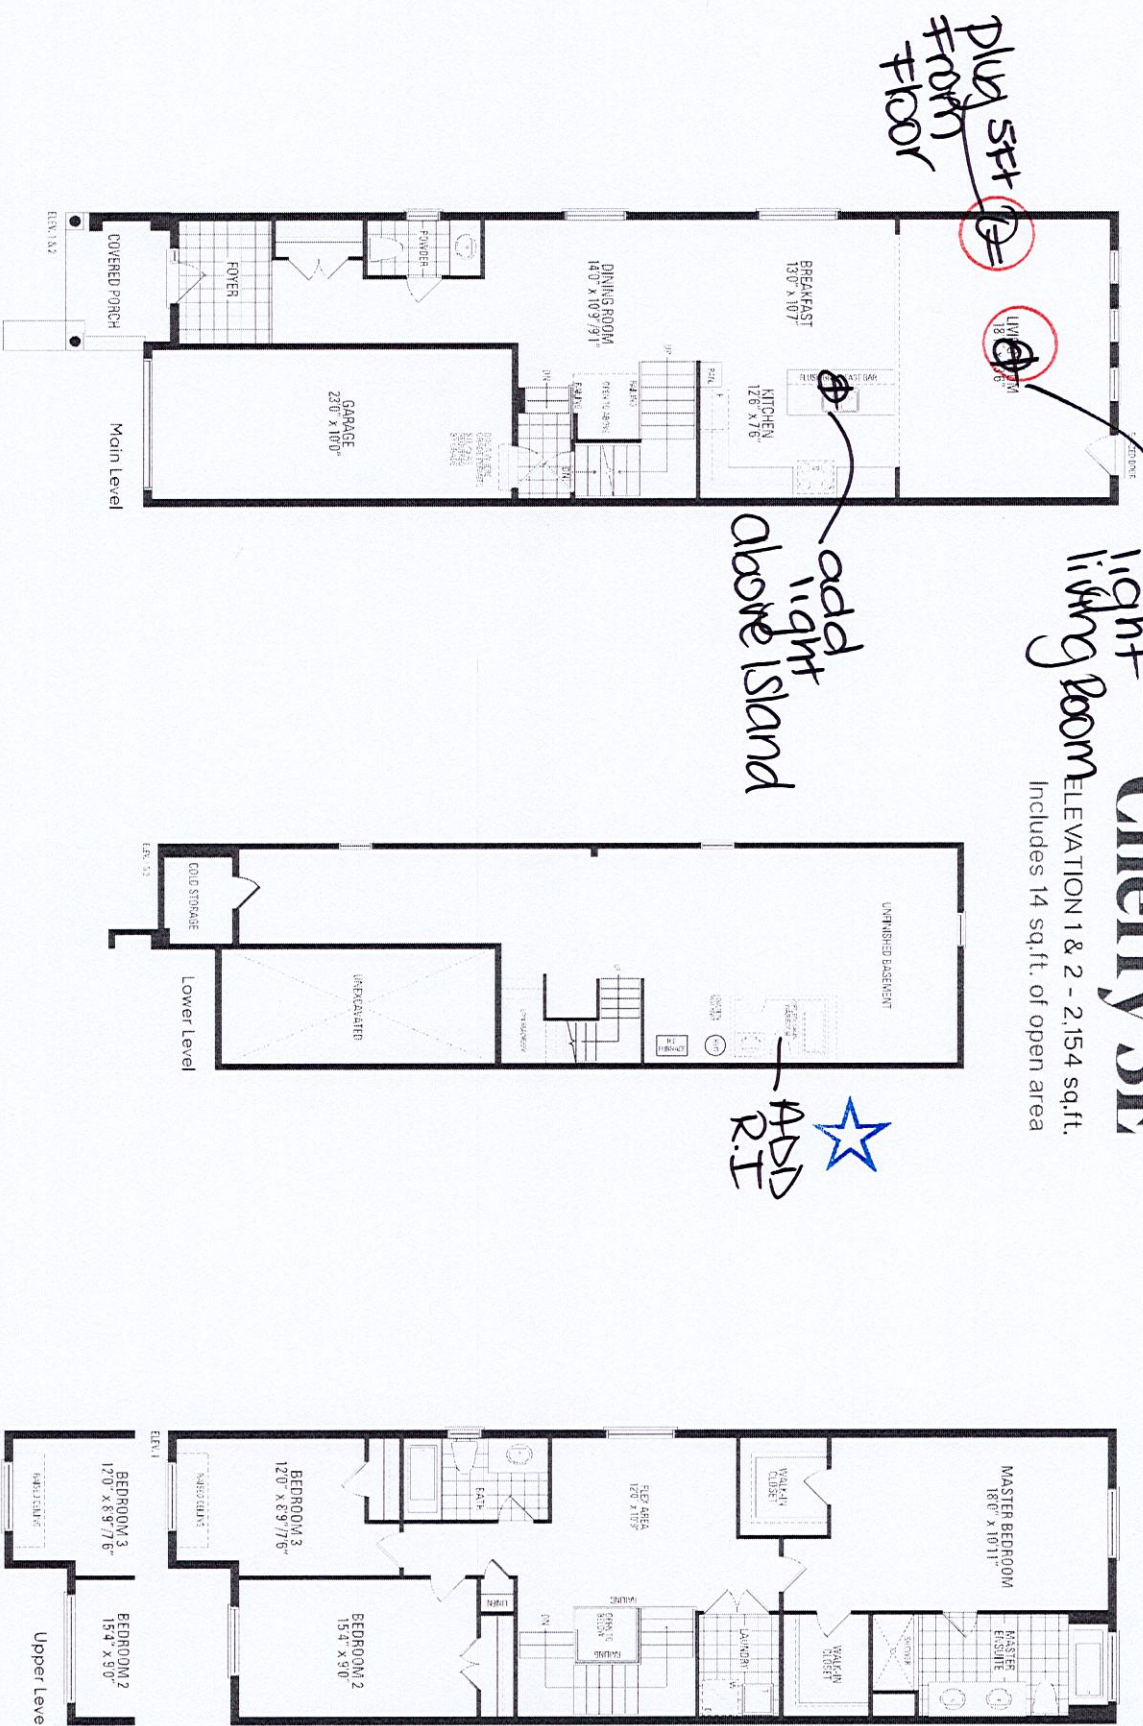

HAZEL
ALLEN
ARCHT.

Orientation of home may be reversed and purchaser agrees to accept the same. Steps and porches may vary at any exterior entrance ways due to grading variance. Actual usable floor space may vary from the stated floor areas. All renderings are artist's concept. Dimensions, specifications and architectural detailing subject to modifications. Roofline and adjoining model types may vary due to siting. E. & O.E. October 2022