

CONSTRUCTION SUMMARY RECEIVED				
Hazel Glenn - Barlassina Construction Inc. APR 19 2023 TEL: RES.: 647-628-4587				
PURCHASERS: Pardip Singh BRAR and Navneet K. LACHHAR				
LOT / PHASE Block 122 TH42 / 1	REG. PLAN #	HOUSE TYPE Willow 3E Elev 3		

CABINETRY

1 - CABINETRY PROVISION - PROVISION FOR PLUG ON ISLAND (PLUG EXTRA ORDERED SEPARATELY) 14Apr23 Note:	
---	--

CONSTRUCTION

1 - SMOOTH CEILING [REDACTED] FIRST FLOOR ONLY 13Apr23 Note:	
---	--

ELECTRICAL

1 - PLUG - ELECTRICAL PLUG - ADD TO ISLAND 13Apr23 Note:	
1 - POT LIGHT - TUB CEILING 13Apr23 Note:	
1 - PLUG - ELECTRICAL PLUG - 5 FEET FROM FINISHED FLOOR FOR FUTURE WALL MOUNTED TV - SEE SKETCH 13Apr23 Note:	
1 - LIGHT AND SWITCH - NO FIXTURE INCLUDED - LIVING ROOM 13Apr23 Note:	
1 - RELOCATE STANDARD KITCHEN LIGHT TO BE CENTERED OVER ISLAND 13Apr23 Note:	
1 - PLUG - ELECTRICAL PLUG WITH GFI AND SWITCH - FOR FESTIVE LIGHTING 13Apr23 Note:	

PLUMBING

1 - WATER LINE FOR FRIDGE - ROUGH-IN ONLY 13Apr23 Note:	
--	--

PROMOTIONAL

1 - PARTIAL REDEMPTION OF PROMOTIONAL PACKAGE \$5,450.00 BALANCE FORWARD \$4,550.00 TO BE USED AT A LATER DATE. ORIGINAL PROMOTIONAL PACKAGE OF \$10,000.00 AS PER SCHEDULE PE. 13Apr23 Note:	
--	--

This Document is Extremely Time Sensitive - Printed 14 Apr 23 at 14:56



BLK 122 TH42




5th Dining light

Electrical Plug → 5 ft from finished floor.

Add Light to Living Room

Willow 3E

ELEVATION 1 - 1,775 sq.ft. • ELEVATION 2 & 3 - 1,765 sq.ft.

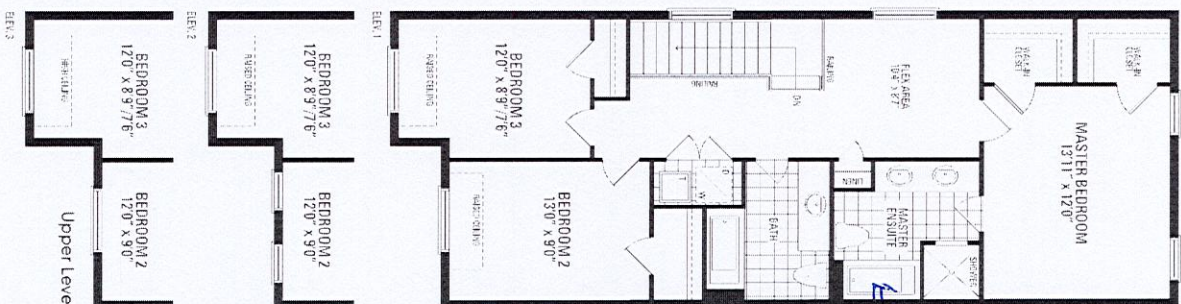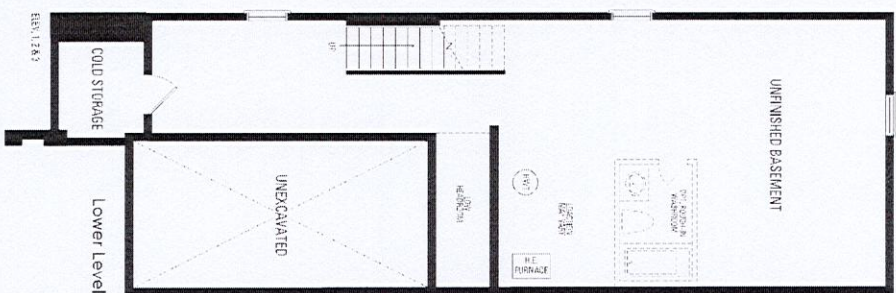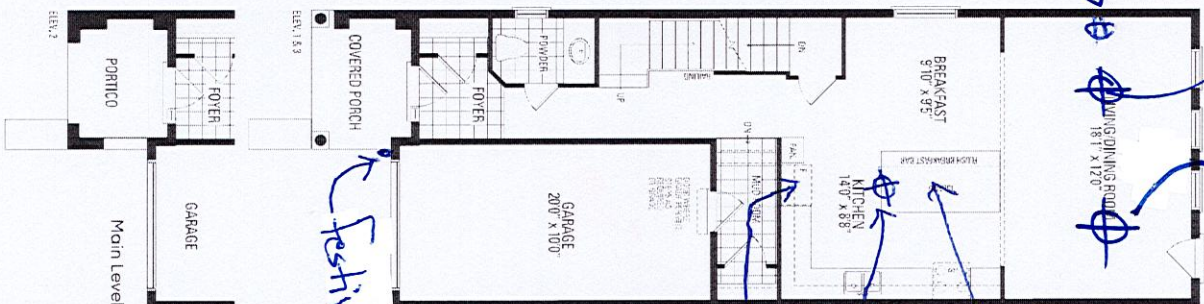

Orientation of home may be reversed and purchaser agrees to accept the same. Steps and porches may vary at any exterior entrance ways due to grading variance. Actual usable floor space may vary from the stated floor areas. All renderings are artist's concept. Dimensions, specifications and architectural detailing subject to modifications. Roofline and adjoining model types may vary due to siting. E. & O.E. October 2022