

CONSTRUCTION SUMMARY

Hazel Glenn - Barlassina Construction Inc. RECEIVED

PURCHASERS: Mayur GUPTA and KARAMJEET KAUR APR 13 2023 TEL: RES.: 647-573-5124

LOT / PHASE Block 122 TH37 / 1	REG. PLAN #	HOUSE TYPE Willow 12 Elev 3		
-----------------------------------	-------------	--------------------------------	--	--

CONSTRUCTION

1 - PRIMARY ENSUITE - PROVISION FOR SHAMPOO NICHE APPROX. 14" WIDE X 20" HIGH AS PER SKETCH – IF CONSTRUCTION PERMITS 13Apr23 Note:	
--	--

COUNTER TOP

1 - PRIMARY ENSUITE - SHAMPOO NICHE 14" WIDE X 20" HIGH AS PER SKETCH – MARBLE, GRANITE OR QUARTZ – IF CONSTRUCTION PERMITS - REQUIRES PROVISION FROM CONSTRUCTION 13Apr23 Note: SUPPLY & INSTALL	
--	--

ELECTRICAL

1 - LIGHT AND SWITCH - NO FIXTURE INCLUDED - LIVING ROOM 13Apr23 Note:	
1 - RELOCATE STANDARD KITCHEN LIGHT TO BE CENTERED OVER ISLAND 13Apr23 Note:	
1 - ABOVE KITCHEN ISLAND - ADD LIGHT AND SWITCH - NO FIXTURE INCLUDED 13Apr23 Note:	

PLUMBING

1 - WATER LINE FOR FRIDGE - ROUGH-IN ONLY 13Apr23 Note:	
1 - WASHROOM - 3 PIECE ROUGH-IN IN BASEMENT 13Apr23 Note:	

PROMOTIONAL

1 - PARTIAL REDEMPTION OF PROMOTIONAL PACKAGE \$3,465.00 BALANCE FORWARD \$6,535.00 TO BE USED AT A LATER DATE. ORIGINAL PROMOTIONAL PACKAGE OF \$10,000.00 AS PER SCHEDULE PE. 13Apr23 Note:	
--	--



This Document is Extremely Time Sensitive - Printed 18 Apr 23 at 8:50

Willow 12

ELEVATION 3 - 2,330 sq.ft.

HAZEL GLENN

WET!

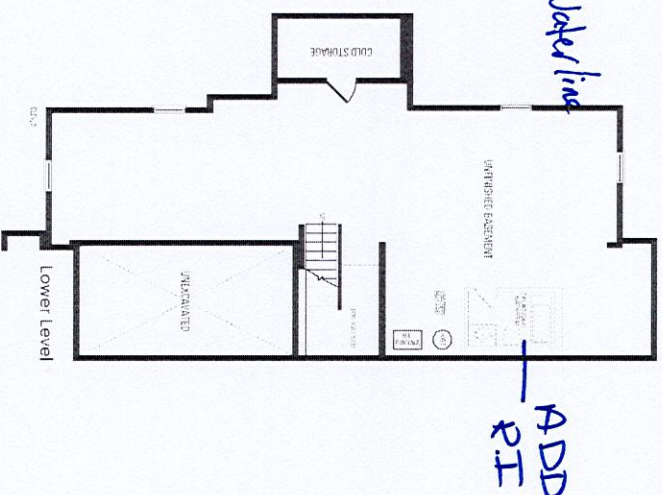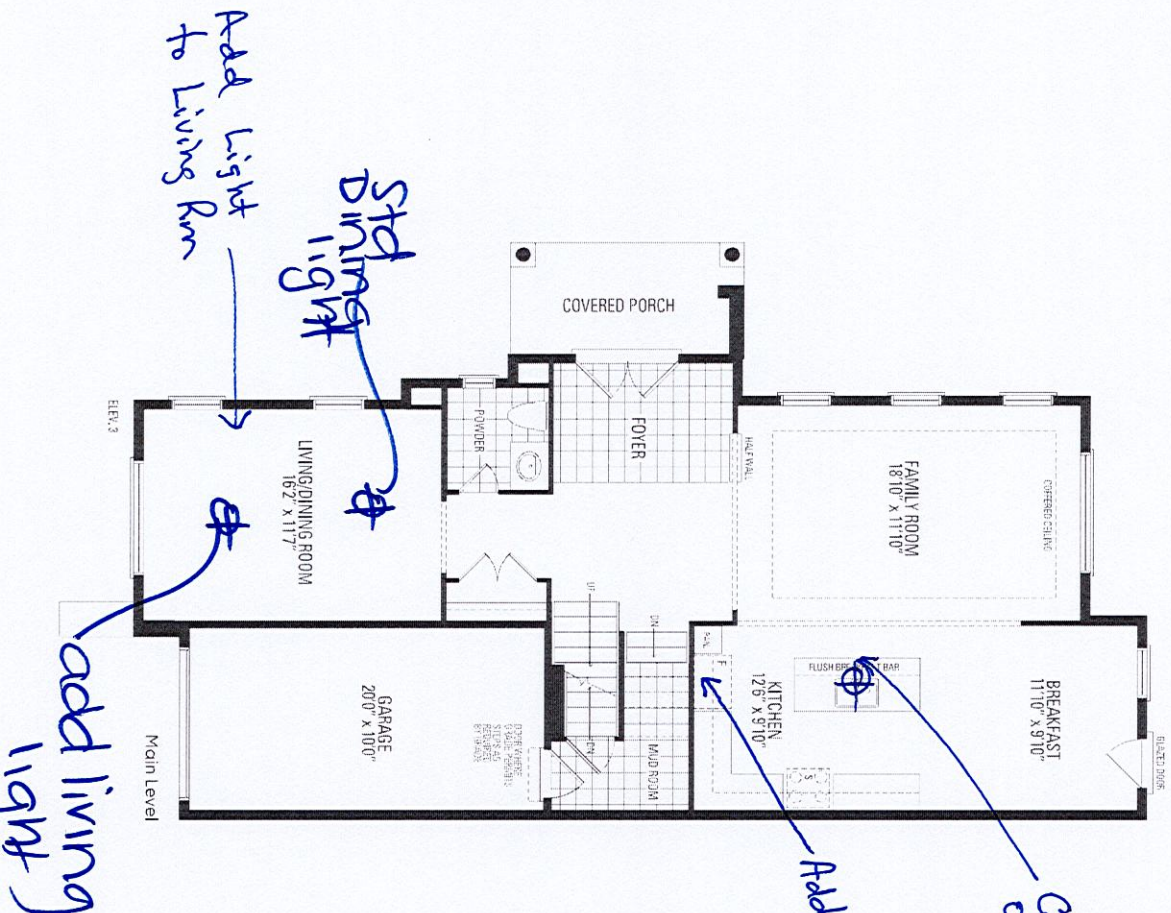

Orientation of home may be reversed and purchaser agrees to accept the same. Steps and porches may vary at any exterior entrance ways due to grading variance. Actual usable floor space may vary from the stated floor areas. All renderings are artist's concept. Dimensions, specifications and architectural detailing subject to modifications. Roofline and adjoining model types may vary due to siting. E. & O.E. October 2022