Greenpark.

"PRELIMINARY"

## **CONSTRUCTION SUMMARY**

Red Oaks - Roundel Homes Inc.

RECEIVED

PURCHASER: Chengjie LIANG

MAY - 2 2023 TEL: RES.: 647-868-2866

LOT / PHASE	REG. PLAN #	HOUSE TYPE	
62 / 2	65M-4737	Pinetree 3 Elev 3	

CONSTR	UCTION	
1 - PROVI	SION FOR SHAMPOO NICHE APPROX. 14" WIDE X 20" HIGH AS PER SKETCH – IF CONSTRUCTION PERMITS	
26Apr23	Note: MASTER ENSUITE	
	ELESS GLASS SHOWER ENCLOSURE PROVISION - REMOVE SIDE WALL AND REPLACE WITH GLASS TO	
ACCOMO. 26Apr23	DATE FRAMELESS GLASS SHOWER ENCLOSURE SEE SKETCH	
20Apr23	TVIC.	
COUNTE	R TOP	
1 - SHAMI	POO NICHE 14" WIDE X 20" HIGH AS PER SKETCH – MARBLE, GRANITE OR QUARTZ – IF CONSTRUCTION PERMITS -	
REQUIRE	S PROVISION FROM CONSTRUCTION	
26Apr23	Note: SUPPLY & INSTALL	
	MASTER ENSUITE	
	MASTER ENSUTTE	
ELECTRI	ICAL	
3 - FAN - I	BATHROOM EXHAUST FAN - ENERGY STAR 80 CFM - IN LIEU OF STANDARD FAN	
26Apr23	Note: MASTER ENSUITE	
	ENSUITE 2	
	ENSUITE 3/4	
1 - POT LI	GHT - SHOWER POT LIGHT	
26Apr23	Note: ENSUITE 3/4	
1		
1 - PLUG -	ELECTRICAL PLUG - TO BE INSTALLED OVER FIREPLACE	
26Apr23	Note:	
1 - LIGHT	AND SWITCH - NO FIXTURE INCLUDED - LIVING ROOM	
26Apr23	Note: SEE SKETCH FOR LOCATION	
1 - RELOC	CATE STANDARD KITCHEN LIGHT TO BE CENTERED OVER ISLAND	
26Apr23	Note:	
1 - PLUG -	ELECTRICAL PLUG WITH GFI AND SWITCH - FOR FESTIVE LIGHTING	
26Apr23	Note: @COVERED PORCH	
	RIC VEHICLE ROUGH-IN PROVISION ONLY FOR FUTURE ELECTRIC CAR (CONDUIT FROM BASEMENT INTO	
	N BOX IN GARAGE WITH PULL STRING, NO WIRE)	
26Apr23	Note:	
FIREPLA	CE AND ACCESSORIES	
	NE ROUGH-IN FOR BARBECUE - FIRST FLOOR	M in
26Apr23	Note:	
1 - GAS LI	NE ROUGH-IN FOR STOVE (INCLUDES ELECTRICAL OUTLET) - FIRST FLOOR	
26Apr23	Note:	

# HEATING AND AIR CONDITIONING 1 - HUMIDIFER

26Apr23 Note:

## MIRRORS AND GLASS

1 - MASTER ENSUITE – FRAMELESS GLASS SHOWER ENCLOSURE – INCLUDES CHROME KNOB AND HINGES 26Apr23 Note:

Greenpark.

## CONSTRUCTION SUMMARY

Red Oaks - Roundel Homes Inc.

PURCHASER: Chengjie LIANG

**TEL:** RES.: 647-868-2866

LOT / PHASE	REG. PLAN #	HOUSE TYPE	
62 / 2	65M-4737	Pinetree 3 Elev 3	

## **PLUMBING**

1 - MOEN CHATEAU POSI-TEMP TUB/SHOWER FAUCET WITH 3 FUNCTION TRANSFER VALVE/TRIM AND SLIDE BAR WITH	
HAND SHOWER – CHROME TL183EP/U361CI/UT2721/3669EP/A725/62320	
26Apr23 Note: PRICE INCLUDES TO TESTER	
MASTER ENSUITE	
1 - TOE TESTER - ADD TOE TESTER TO SHOWER	
26Apr23 Note: ENSUITE 2	
1 - HOSE BIB - EXTERIOR FROST FREE	
26Apr23 Note: 1 @ REAR OF HOUSE	
2014/25 TOWN TWINDING OF HOUSE	
1 - KITCHEN – POT FILLER – MOEN MODERN TWO HANDLE POT FILLER FAUCET WITH DUAL SHUT OFFS – #S665 CHROME	
26Apr23 Note:	
1 - WATER LINE FOR FRIDGE - ROUGH-IN ONLY	
26Apr23 Note:	

#### **PROMOTIONAL**

1 - LESS C	CREDIT FROM PURCHASER EXTRA SHEET IN OFFER	160
26Apr23	Note:	
		58


## **EXTRAS AS PER OFFER**

The Vendor agrees that notwithstanding any other term or provision in this Agreement included in the Purchase Price and in addition to those items detailed in Schedule GP to the Agreement of Purchase and Sale, the Purchaser is entitled to a credit of Ten Worksheet Note:

10 foot ceiling height on Main Floor. The Purchaser acknowledges that as a result of the increased ceiling height from the Vendor?s standard ceiling height, various modifications to the interior and exterior of the dwelling unit may be made, including *Worksheet* Note:

This Document is Extremely Time Sensitive - Printed 26 Apr 23 at 16:03

LOT # 62

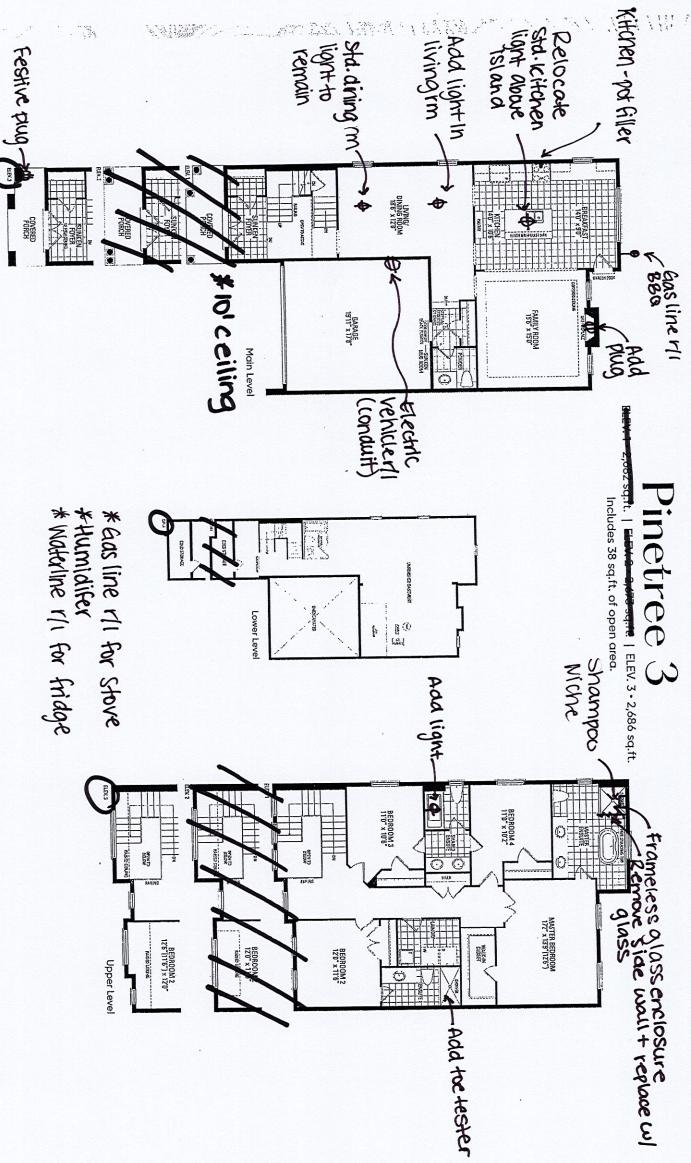

Orientation of home may be reversed and purchaser agrees to accept the same. Steps and porches may vary at any exterior entrance ways due to grading variance. Actual usable floor space may vary from the stated floor areas. All renderings are artist's concept. Dimensions, specifications and architectural detailing subject to modifications. Roofline and adjoining model types may vary due to siting. E. & O. E. June 2022