

CONSTRUCTION SUMMARY				
Red Oaks - Roundel Homes Inc.				
PURCHASERS: Belinda WU and Samuel WU		RECEIVED MAY - 2 2023		TEL: RES.: 905-922-8666
LOT / PHASE 47 / 2	REG. PLAN # 65M-4737	HOUSE TYPE Glenrowan 3 Elev 3		

ELECTRICAL

1 - RELOCATE STANDARD KITCHEN LIGHT TO BE CENTERED OVER ISLAND 26Apr23 Note:	
---	--

PLUMBING

1 - PRIMARY ENSUITE - MOEN 90 DEGREE POSI-TEMP SHOWER ONLY WITH 3 FUNCTION TRANSFER VALVE/TRIM AND SLIDE BAR WITH HAND SHOWER – CHROME #TS2712EP/U361CI/UTS4172/62320/S3879EP/A721 26Apr23 Note:	
---	--

EXTRAS AS PER OFFER


10 foot ceiling height on Main Floor. The Purchaser acknowledges that as a result of the increased ceiling height from the Vendor's standard ceiling height, various modifications to the interior and exterior of the dwelling unit may be made, including but not limited to: Worksheet Note:	
PURCHASER(S) ACKNOWLEDGES THAT THE PURCHASE PRICE IS INCLUSIVE OF ALL CREDITS AND PROMOTIONAL PACKAGES AVAILABLE AT TIME OF PURCHASE. Worksheet Note:	

This Document is Extremely Time Sensitive - Printed 26 Apr 23 at 15:11


Lot 47 Ph.2
Round 1

Glenrowan 3

ELEV. 2 & 3 • 2,932 sq.ft.
Includes 11 sq.ft. of open area.

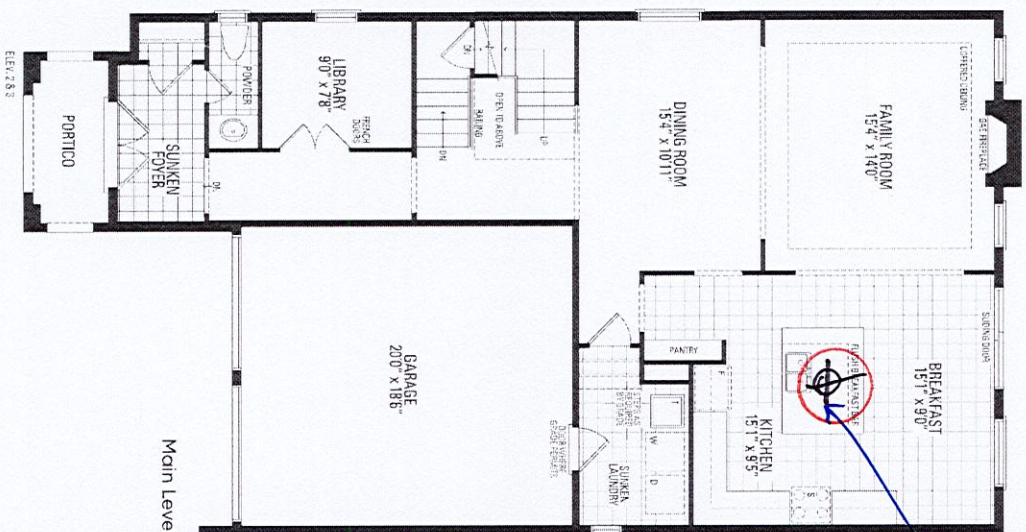

Center light
over island

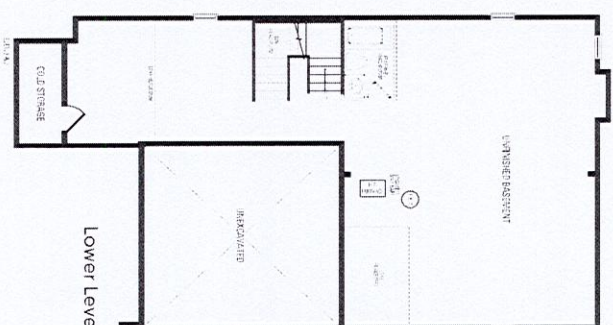

Orientation of home may be reversed and purchaser agrees to accept the same. Steps and porches may vary at any exterior entrance ways due to grading variance. Actual usable floor space may vary from the stated floor areas. All renderings are artist's concept. Dimensions, specifications and architectural detailing subject to modifications. Roofline and adjoining model types may vary due to siting. E. & O. E. June 2022