

CONSTRUCTION SUMMARY

Hazel Glenn - Barlassina Construction Inc.

PURCHASERS: Prabhdeep SINGH and NAVNEET KAUR

RECEIVED
MAY 12 2023

TEL: RES.: 647-979-1628

LOT / PHASE 118 / 1	REG. PLAN #	HOUSE TYPE Garden 9 Elev 1 (3 Bedroom)		
------------------------	-------------	---	--	--

ELECTRICAL


1 - STANDARD DINING ROOM LIGHT TO BE CENTERED BETWEEN LIVING AND DINING ROOM 11May23 Note:	
1 - RELOCATE STANDARD KITCHEN LIGHT TO BE CENTERED OVER ISLAND 11May23 Note:	

This Document is Extremely Time Sensitive - Printed 11 May 23 at 15:38

Garden 9

ELEVATION 1 - 2,490 sq.ft.

HAZEL GLENN
ARCHITECT

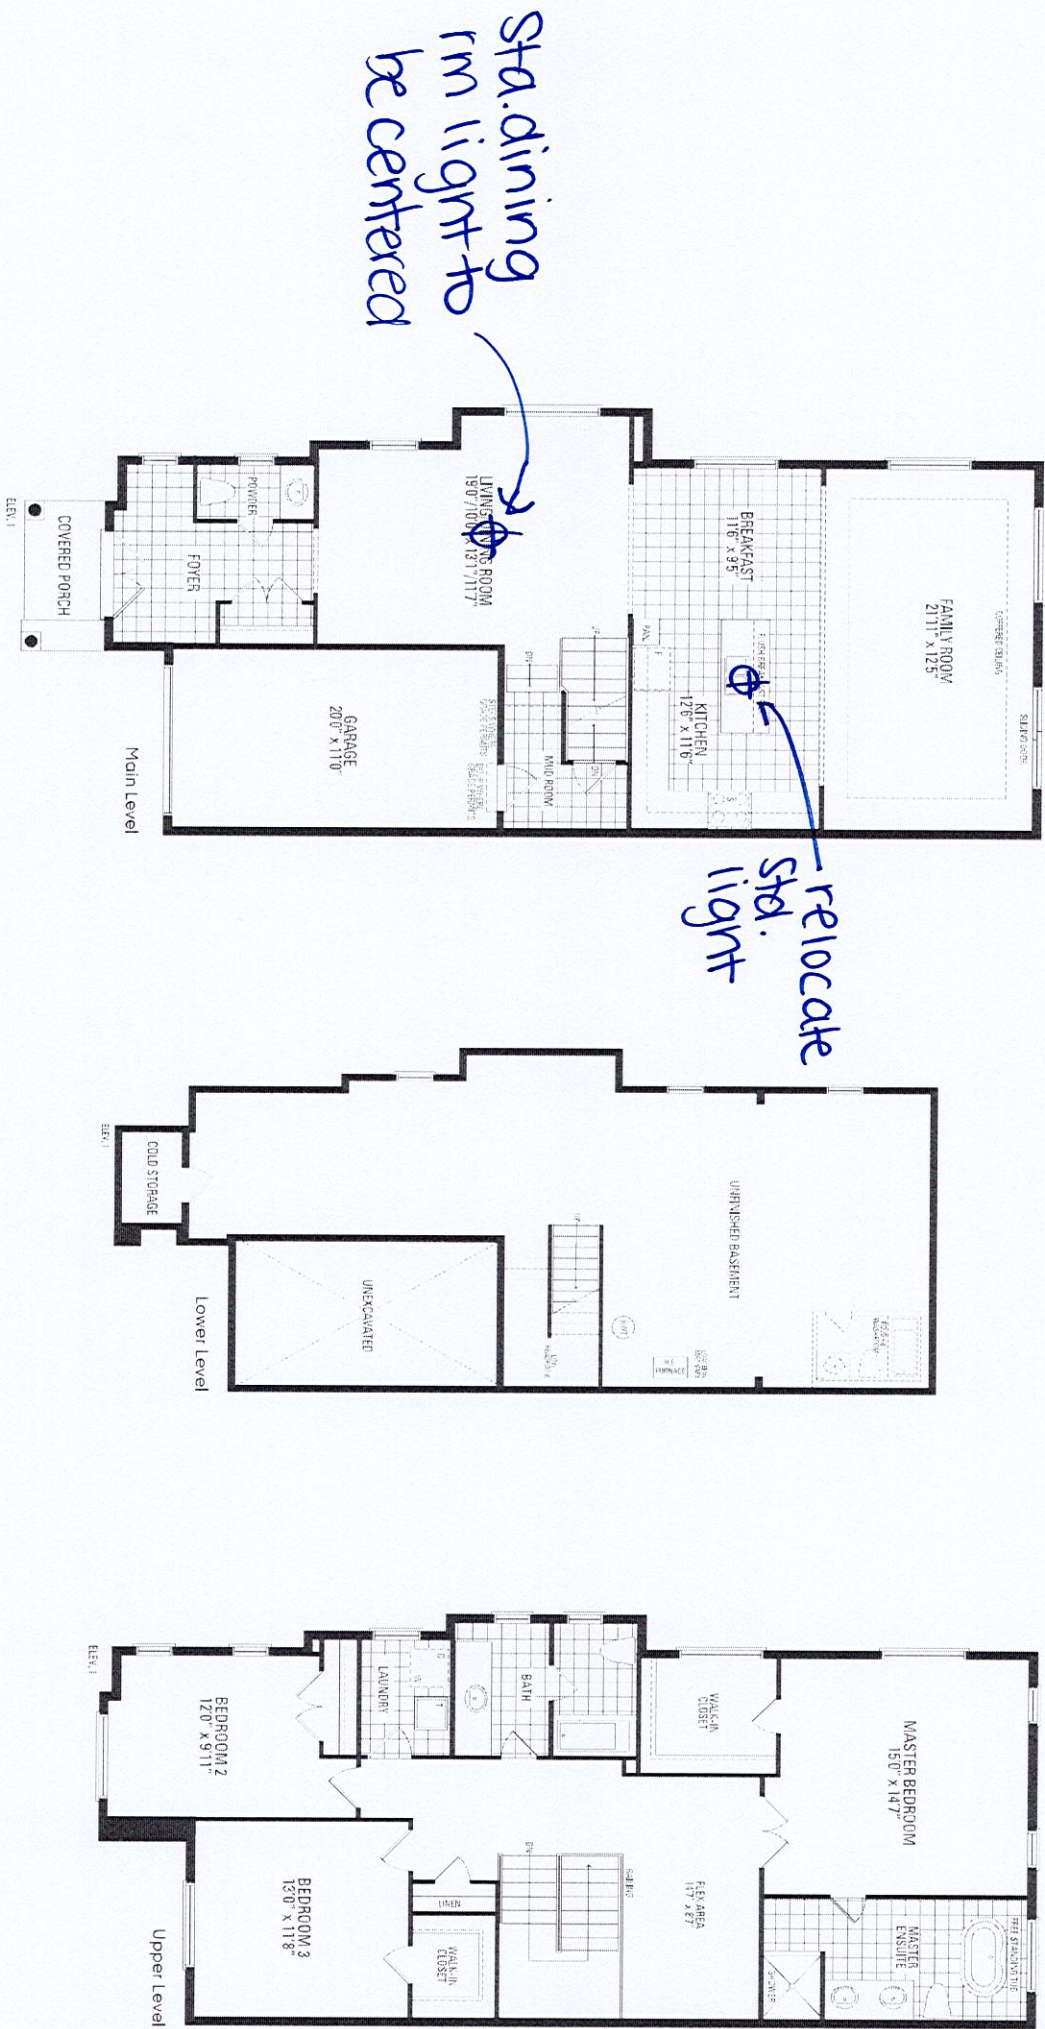

Orientation of home may be reversed and purchaser agrees to accept the same. Steps and porches may vary at any exterior entrance ways due to grading variance. Actual usable floor space may vary from the stated floor areas. All renderings are artist's concept. Dimensions, specifications and architectural detailing subject to modifications. Roofline and adjoining model types may vary due to siting. E. & O.E. October 2022