

CONSTRUCTION SUMMARY

Hazel Glenn - Barlassina Construction Inc.

RECEIVED

PURCHASERS: Gurinder S TATTER and 2642739 ONTARIO LTD

MAY 12 2023

TEL: RES.: 647-298-9060

LOT / PHASE	REG. PLAN #	HOUSE TYPE		
78 / 1		Garden 3 Elev 2 (4 Bedroom)		

ELECTRICAL

2 - FAN - BATHROOM EXHAUST FAN - ENERGY STAR 80 CFM - IN LIEU OF STANDARD FAN 11May23 Note: MAIN BATHROOM MASTER ENSUITE	
1 - PLUG - ELECTRICAL PLUG - 5 FEET FROM FINISHED FLOOR FOR FUTURE WALL MOUNTED TV - SEE SKETCH 11May23 Note: Family Room	
1 - LIGHT AND SWITCH - NO FIXTURE INCLUDED-LIVING ROOM 11May23 Note:	
1 - RELOCATE STANDARD KITCHEN LIGHT TO BE CENTERED OVER ISLAND 11May23 Note:	
1 - ELECTRIC VEHICLE ROUGH-IN PROVISION ONLY FOR FUTURE ELECTRIC CAR (CONDUIT FROM BASEMENT INTO JUNCTION BOX IN GARAGE WITH PULL STRING, NO WIRE) 11May23 Note:	

PLUMBING

1 - HOSE BIB - EXTERIOR FROST FREE 11May23 Note: 1 @ REAR OF HOUSE	
1 - TUB TO SHOWER CONVERSION - 5 FOOT SHOWER WITH SLIDING GLASS CHROME DOORS IN LIEU OF TUB INCLUDES SHOWER POT LIGHT 11May23 Note: MAIN BATHROOM	




PROMOTIONAL

1 - PARTIAL REDEMPTION OF PROMOTIONAL PACKAGE \$5,480.00.BALANCE FORWARD \$4,520.00 TO BE USED AT A LATER DATE. ORIGINAL PROMOTIONAL PACKAGE OF \$10,000.00 AS PER SCHEDULE PE. 11May23 Note:	
--	--

This Document is Extremely Time Sensitive - Printed 12 May 23 at 9:09

Garden 3

ELEVATION + & 2 - 2,400 sq.ft. • ~~ELEVATION 3 - 2,415 sq.ft.~~

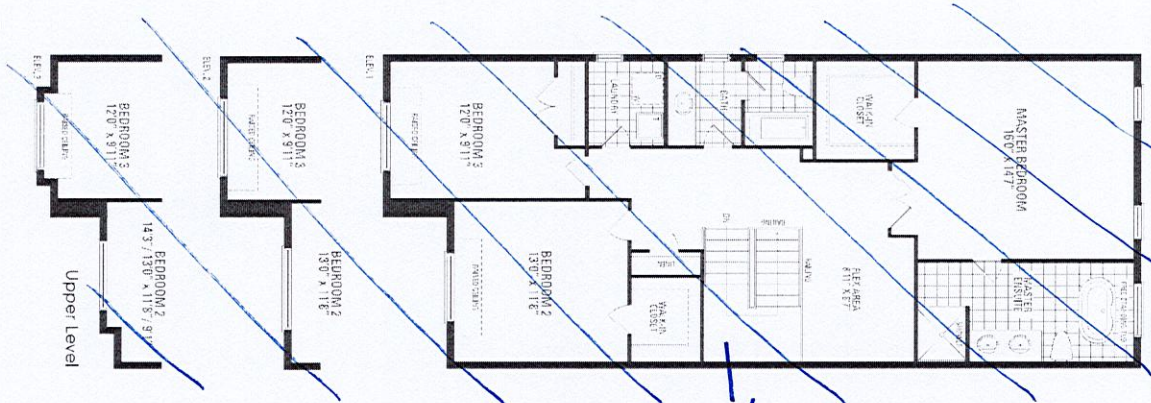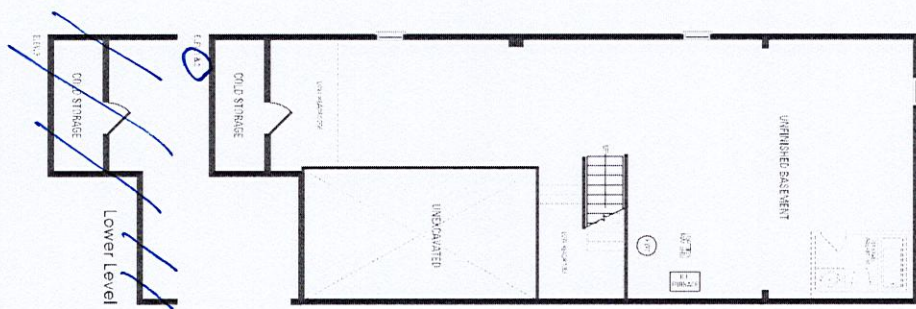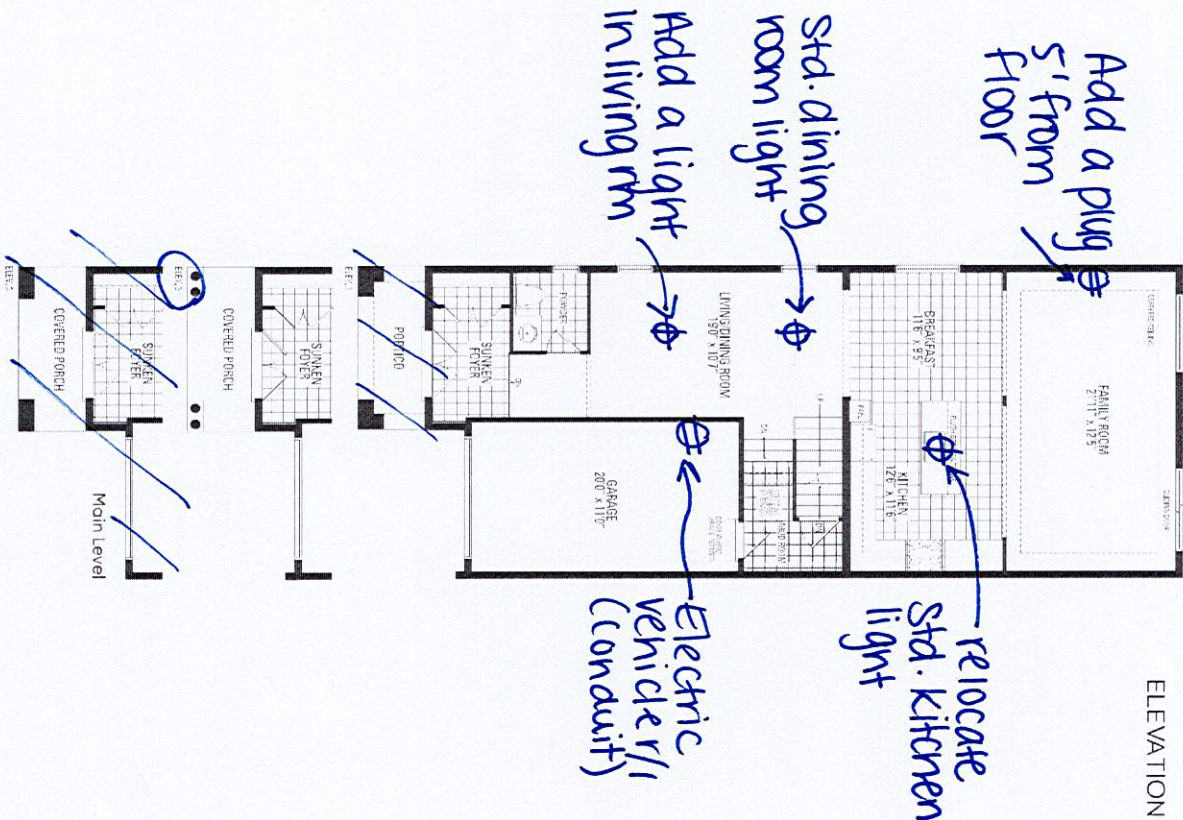

Orientation of home may be reversed and purchaser agrees to accept the same. Steps and porches may vary at any exterior entrance ways due to grading variance. Actual usable floor space may vary from the stated floor areas. All renderings are artist's concept. Dimensions, specifications and architectural detailing subject to modifications. Roofline and adjoining model types may vary due to siting. E. & O.E. October 2022


HAZEL
ANNETT

LOT #78

Garden 3

ELEVATION 1 & 2 - 2,400 sq.ft. · ~~ELEVATION 3 - 2,415 sq.ft.~~

Convert tub
to Shower

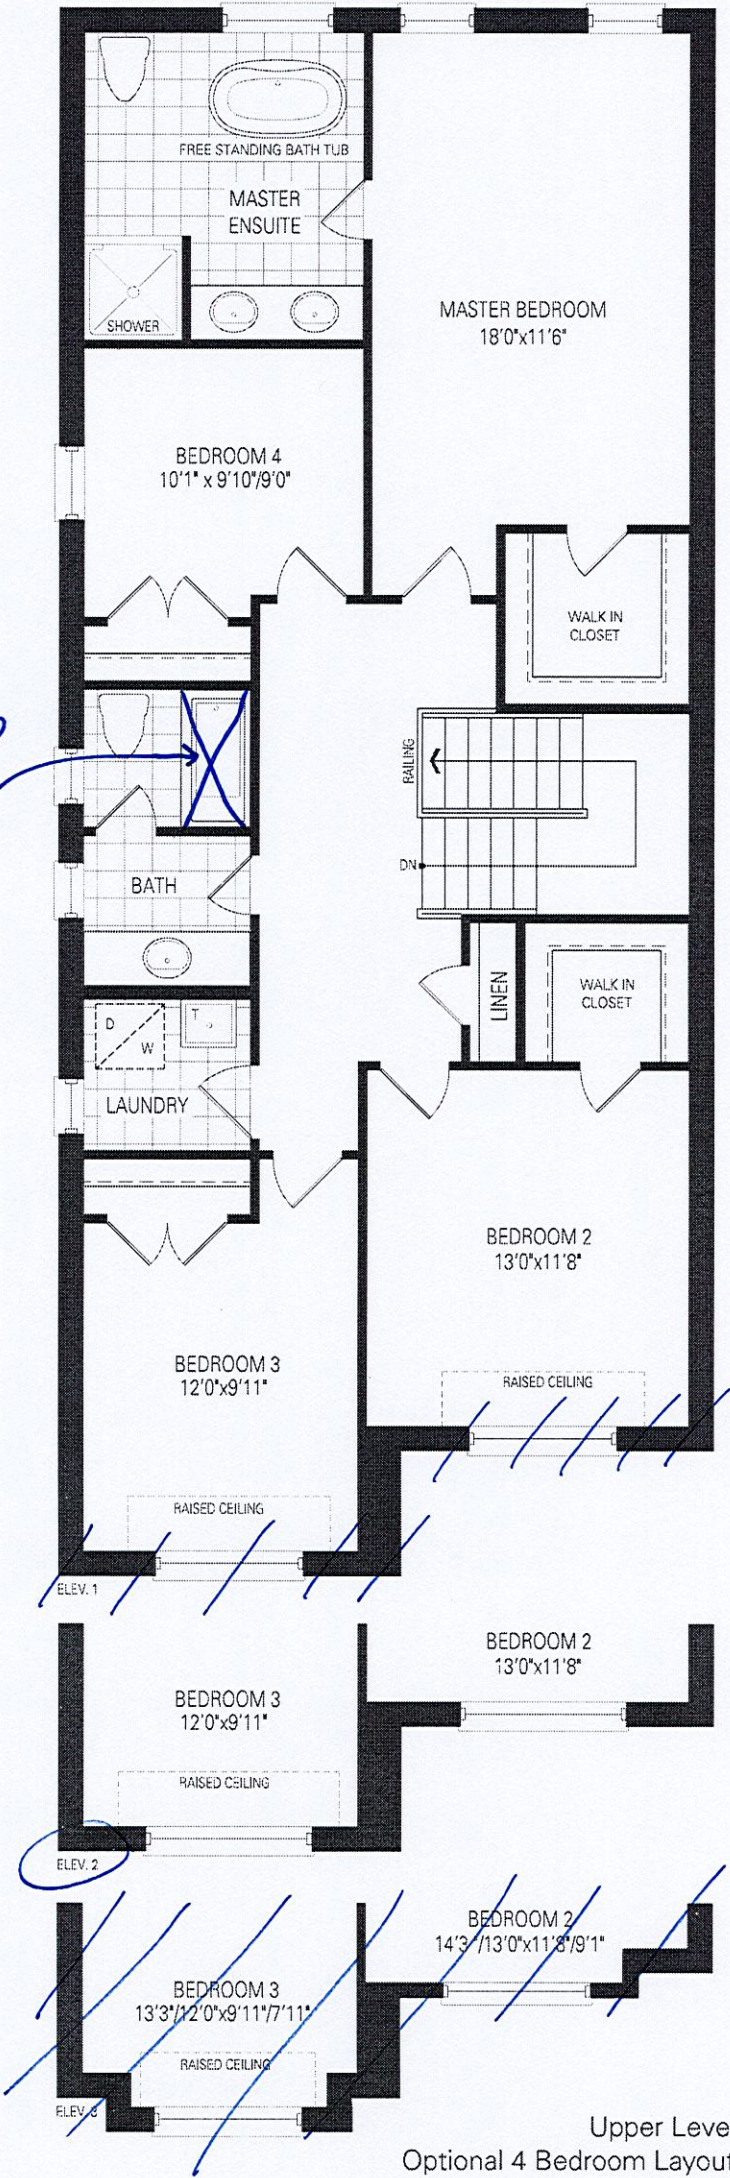

Orientation of home may be reversed and purchaser agrees to accept the same. Steps and porches may vary at any exterior entrance ways due to grading variance. Actual usable floor space may vary from the stated floor areas. All renderings are artist's concept. Dimensions, specifications and architectural detailing subject to modifications. Roofline and adjoining model types may vary due to siting. E. & O.E. October 2022