

CONSTRUCTION SUMMARY
Hazel Glenn - Barlassina Construction Inc.

RECEIVED

MAY 17 2023

TEL: RES.: 416-876-2011

PURCHASERS: Mustafa Radhwan M Ali M ALI and Ghadah Bassam Ibrahim ALOMARI

LOT / PHASE 116 / 1	REG. PLAN #	HOUSE TYPE Garden 4 Elev 3		
------------------------	-------------	-------------------------------	--	--

ELECTRICAL

1 - STANDARD DINING ROOM LIGHT TO BE CENTERED BETWEEN LIVING AND DINING ROOM 17May23 Note:	
12 - POT LIGHT - LED - FIRST FLOOR INSTALLATION 17May23 Note: SEE SKETCH	
1 - PLUG - ELECTRICAL PLUG 5' FROM FLOOR FOR FUTURE WALL MOUTED TV 17May23 Note: SEE SKETCH	
1 - RELOCATE STANDARD KITCHEN LIGHT TO BE CENTERED OVER ISLAND 17May23 Note:	

MISCELLANEOUS

1 - GARAGE DOOR OPENER – LIFEMASTER 8155 WITH BELT DRIVE – INLCUDES 1 HANDHELD CONTROL - PRICE IS PER GARAGE DOOR 17May23 Note: KEYPAD & EXTRA HANDHELD CONTROL SOLD SEPARATELY	
--	--


PROMOTIONAL

1 - PARTIAL REDEMPTION OF PROMOTIONAL PACKAGE \$5,315.00. BALANCE FORWARD \$4,685.00 TO BE USED AT A LATER DATE. ORIGINAL PROMOTIONAL PACKAGE OF \$10,000.00 AS PER SCHEDULE PE. 17May23 Note:	
---	--

This Document is Extremely Time Sensitive - Printed 17 May 23 at 9:59



LOT 116

MA - EHA

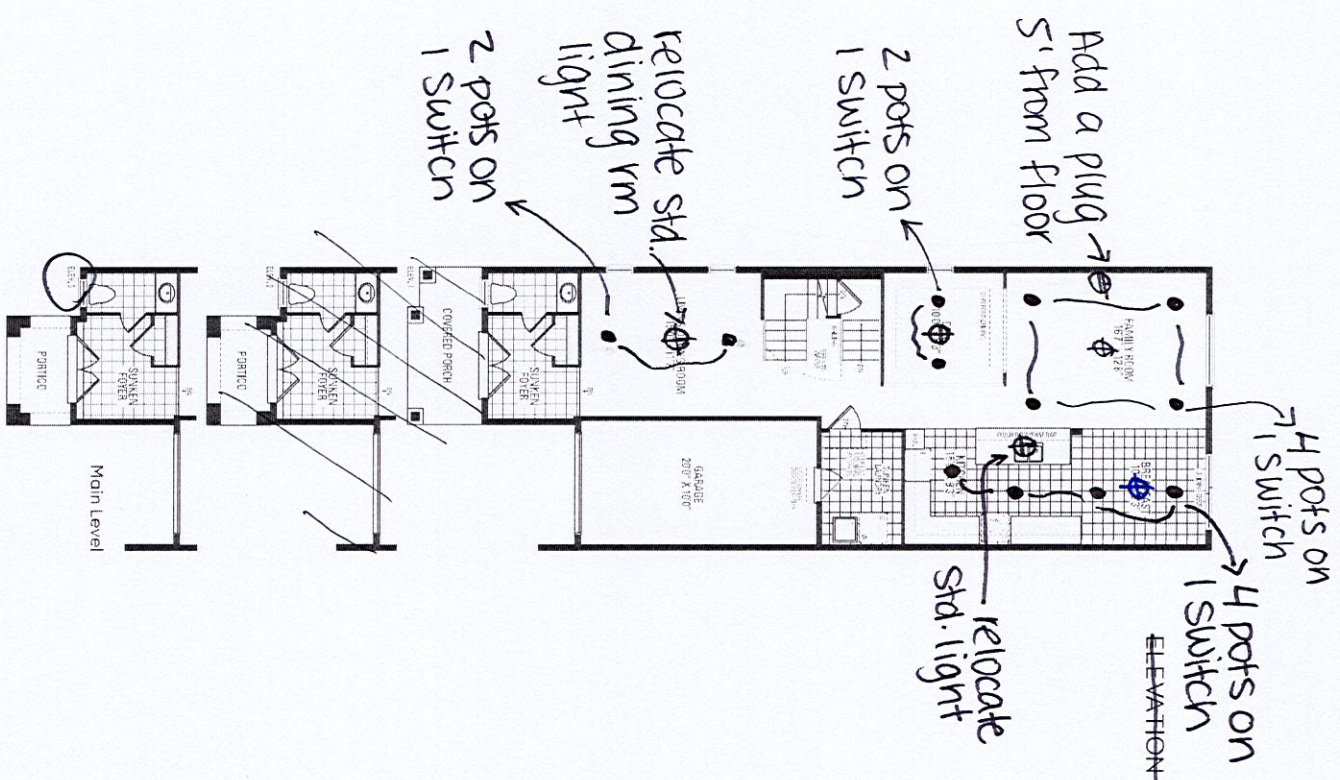

Garden 4

ELEVATION 1 - 2,610 sq.ft. • ELEVATION 2 & 3 - 2,629 sq.ft.
Includes 14 sq.ft. of open area

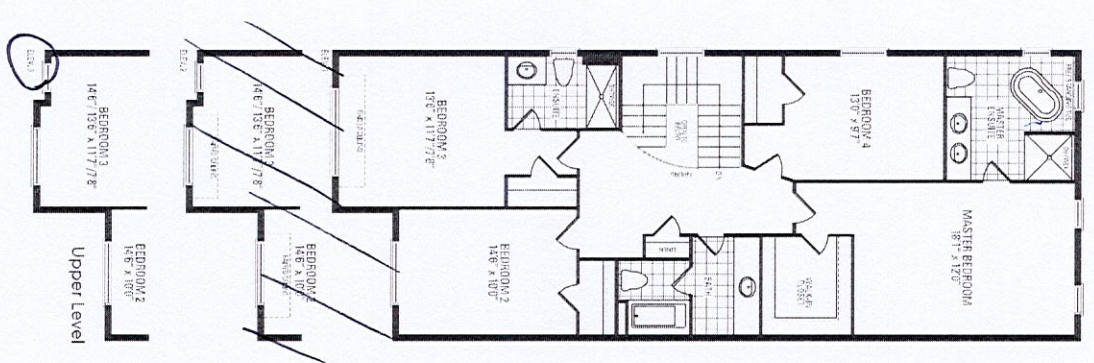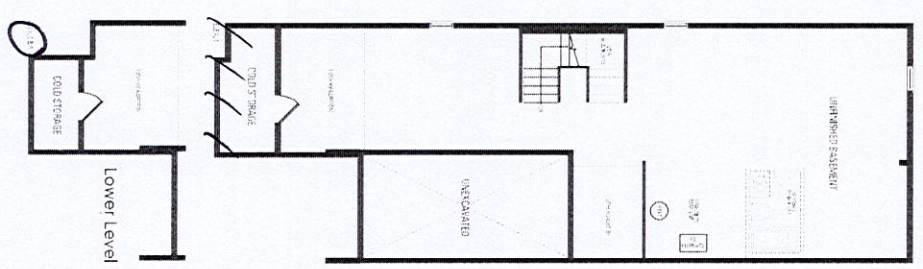

HAZEL GLENN
ARCHT

Orientation of home may be reversed and purchaser agrees to accept the same. Steps and porches may vary at any exterior entrance ways due to grading variance. Actual usable floor space may vary from the stated floor areas. All renderings are artist's concept. Dimensions, specifications and architectural detailing subject to modifications. Roofline and adjoining model types may vary due to stimg. E. & O.E. October 2022