

CONSTRUCTION SUMMARY

Hazel Glenn - Barlassina Construction Inc.

PURCHASERS: Randeep Singh BHAMRA and Amulpreet Kaur BHAMRA

TEL: RES.: 416-275-0081 BUS.: 437-980-9690

LOT / PHASE	REG. PLAN #	HOUSE TYPE		
115 / 1		Garden 4 Elev 1		

CONSTRUCTION

1 - CLOSE OFF DEN ARCHAYS TO FAMILY ROOM AND HALLWAY. ADD DOUBLE FRENCH DOORS FROM DEN TO HALLWAY 23May23 Note:	
3 - ENLARGE BASEMENT WINDOWS (MAY REQUIRE WINDOW WELLS) - WINDOW IS 30 INCHES X 24 INCHES 30Nov22 Note:	

ELECTRICAL

2 - PLUG - ELECTRICAL PLUG 5FT FROM FLOOR FOR FUTURE WALL MOUNTED TV 23May23 Note: SEE SKETCH FOR LOCATION	
FAMILY ROOM & BEDROOM 3	
1 - LIGHT AND SWITCH - NO FIXTURE INCLUDED - LIVING ROOM 23May23 Note:	
1 - ABOVE KITCHEN ISLAND - ADD LIGHT AND SWITCH - NO FIXTURE INCLUDED 23May23 Note:	
1 - PLUG - ELECTRICAL PLUG WITH GFI AND SWITCH - FOR FESTIVE LIGHTING 23May23 Note: COVERED PORCH	
1 - ELECTRIC VEHICLE ROUGH-IN PROVISION ONLY FOR FUTURE ELECTRIC CAR (CONDUIT FROM BASEMENT INTO JUNCTION BOX IN GARAGE WITH PULL STRING, NO WIRE) 23May23 Note:	

FIREPLACE AND ACCESSORIES

1 - GAS LINE ROUGH-IN FOR STOVE (INCLUDES ELECTRICAL OUTLET) - FIRST FLOOR 23May23 Note:	
---	--

MISCELLANEOUS

1 - GARAGE DOOR OPENER – LIFEMASTER 8155 WITH BELT DRIVE – INCLUDES 1 KEYPAD AND 2 HANDHELD CONTROLS - PRICE IS PER GARAGE DOOR 23May23 Note:	
--	--

PLUMBING

2 - TOE TESTER - ADD TOE TESTER TO SHOWER 23May23 Note: MASTER ENSUITE ENSUITE 3	
2 - HOSE BIB - EXTERIOR FROST FREE 23May23 Note: 1 @ REAR/ 1@ GARAGE	
1 - TUB TO SHOWER CONVERSION - 5 FOOT SHOWER WITH SLIDING GLASS CHROME DOORS IN LIEU OF TUB INCLUDES SHOWER POT LIGHT 23May23 Note: MAIN BATHROOM	

PROMOTIONAL


1 - LESS BALANCE OF CREDIT FROM PURCHASER EXTRA SHEET IN OFFER 23May23 Note:	
1 - LESS CREDIT FROM PURCHASER EXTRA SHEET IN OFFER 30Nov22 Note: PROMO BALANCE REMAINING - \$ 8,050.00	

LOT 115
BARLASSINA
HAZEL GLENN
CITY OF CAMBRIDGE

GARDEN 4
ELEVATION 1

REVISIONS:

- CLOSE OFF DEN ARCHWAYS TO FAMILY ROOM AND HALLWAY. ADD DOUBLE FRENCH DOORS FROM DEN TO HALLWAY.

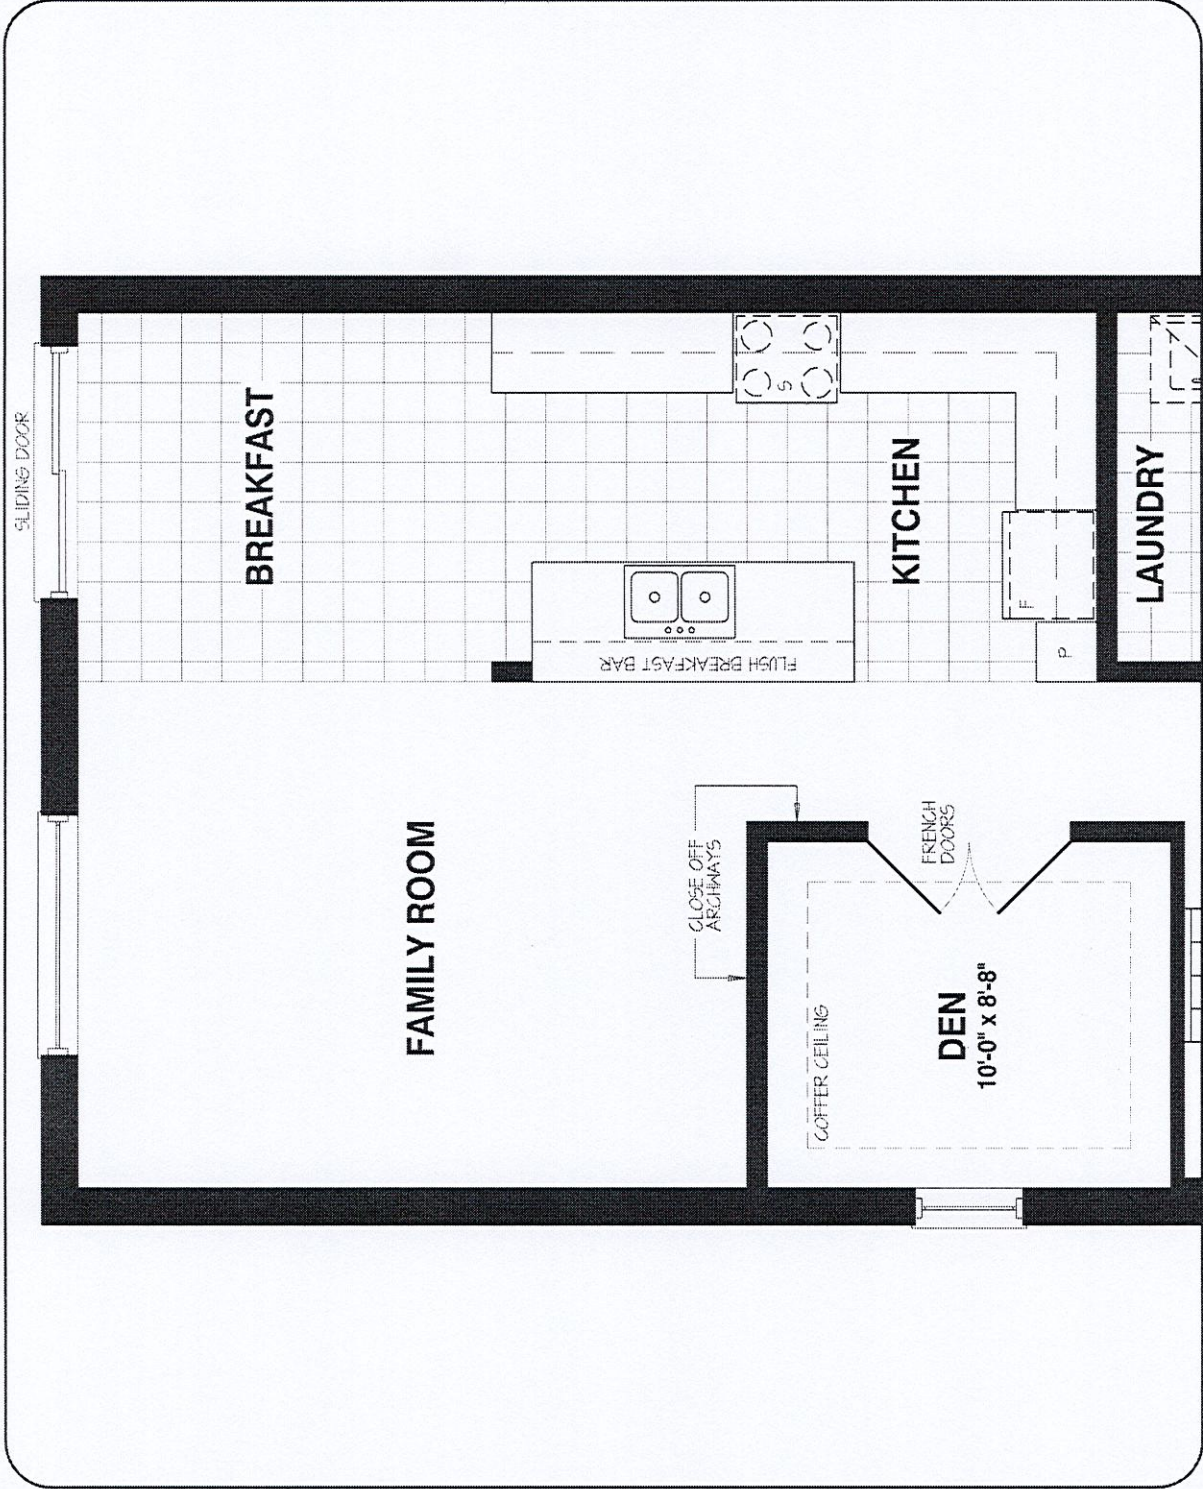

MAIN LEVEL


DISCLAIMERS: SKETCH NOT TO SCALE. DIMENSIONS, SPECIFICATIONS AND ARCHITECTURAL DETAILS SUBJECT TO MODIFICATION BY THE VENDOR. SKETCH IS ONLY FOR THE PURPOSE OF ILLUSTRATING REVISIONS REQUESTED BY THE PURCHASER AND ALL REVISIONS ARE SUBJECT TO VENDOR'S FINAL APPROVAL. ONLY REVISIONS ACCEPTED IN WRITING BY THE PURCHASER AND VENDOR ON A PURCHASER'S EXTRA SHEET WILL BE INCORPORATED INTO THE PLANS FILED WITH THE MUNICIPALITY. E. & O.E.

REGION
DESIGN
INC.

SCALE
N.T.S.
BY
PAGE NO.
MB
1 OF 1



ELEVATION 1 - 2,610 sq.ft. • ~~ELEVATION 2 - 9 - 2,629 sq.ft.~~
Includes 14 sq.ft. of open area

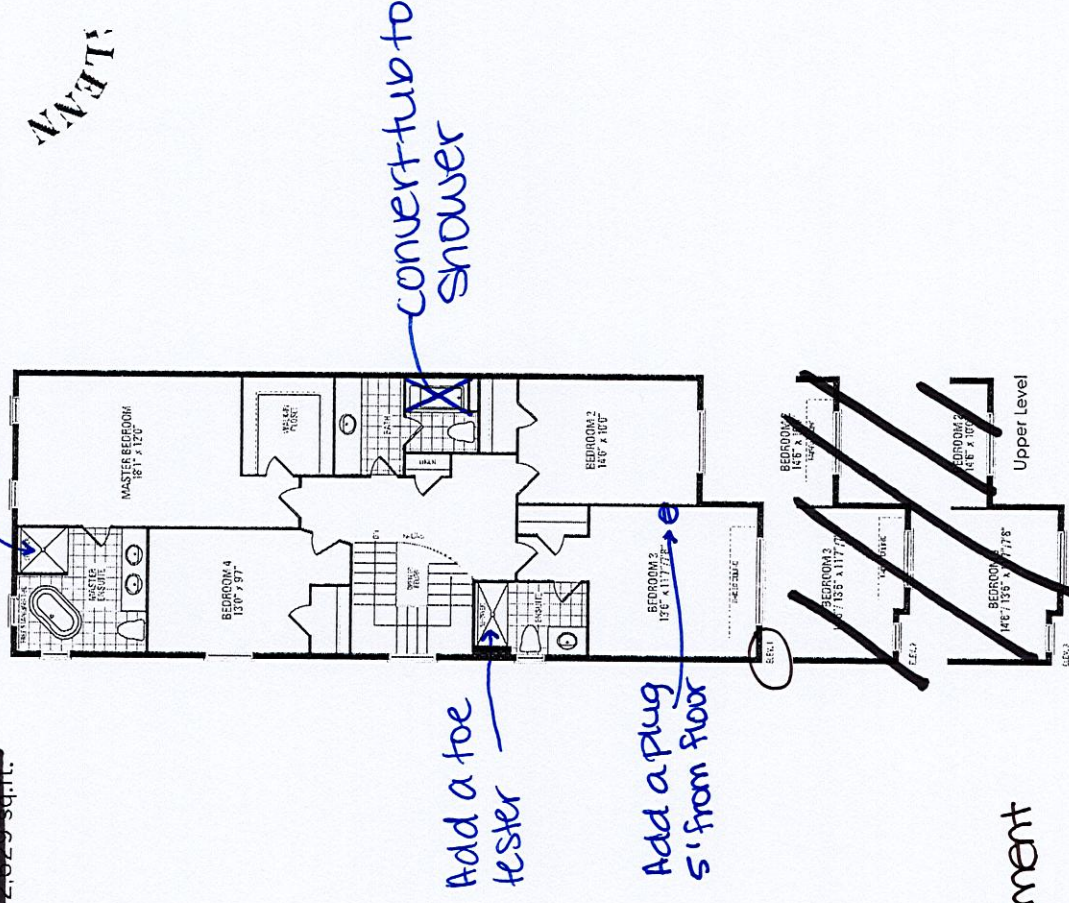

* Gas line r/1 for stove

Orientation of home may be reversed and purchaser agrees to accept the same. Steps and porches may vary at any exterior entrance ways due to grading variance. Actual usable floor space may vary from the stated floor areas. All renderings are artist's concept. Dimensions, specifications and architectural detailing subject to modifications. Roofline and adjoining model types may vary due to siting. E. & O.E. October 2022