

CONSTRUCTION SUMMARY			RECEIVED	
Palmetto - Zadorra Estates Corp.			JUN 14 2023	
PURCHASERS: Rajesh ARRA and Shailaja ARRA			TEL:	
LOT / PHASE	REG. PLAN #	HOUSE TYPE		
148 / 1		Rose 2 Elev 1		

CONSTRUCTION

1 - ENLARGED BASEMENT WINDOWS (MAY REQUIRE WINDOW WELLS) - WINDOW IS 30 INCHES X 24 INCHES 12Jun23 Note:	
1 - FIRST FLOOR INCREASE CEILING HEIGHT FROM 9 FEET TO 10 FEET 12Jun23 Note:	

EXTRAS AS PER OFFER


The Vendor agrees that notwithstanding any other term or provision in this Agreement included in the Purchase Price and in addition to those items detailed in Schedule GP to the Agreement of Purchase and Sale, the Purchaser is entitled to a credit of Fif Worksheet Note:	
---	--

This Document is Extremely Time Sensitive - Printed 14 Jun 23 at 10:23

Lot 148 Zadora

Rose 2 40' LOT

ELEVATION 1 3,005 sq.ft. • ELEVATION 2 2,999 sq.ft. • ELEVATION 3 2,998 sq.ft.

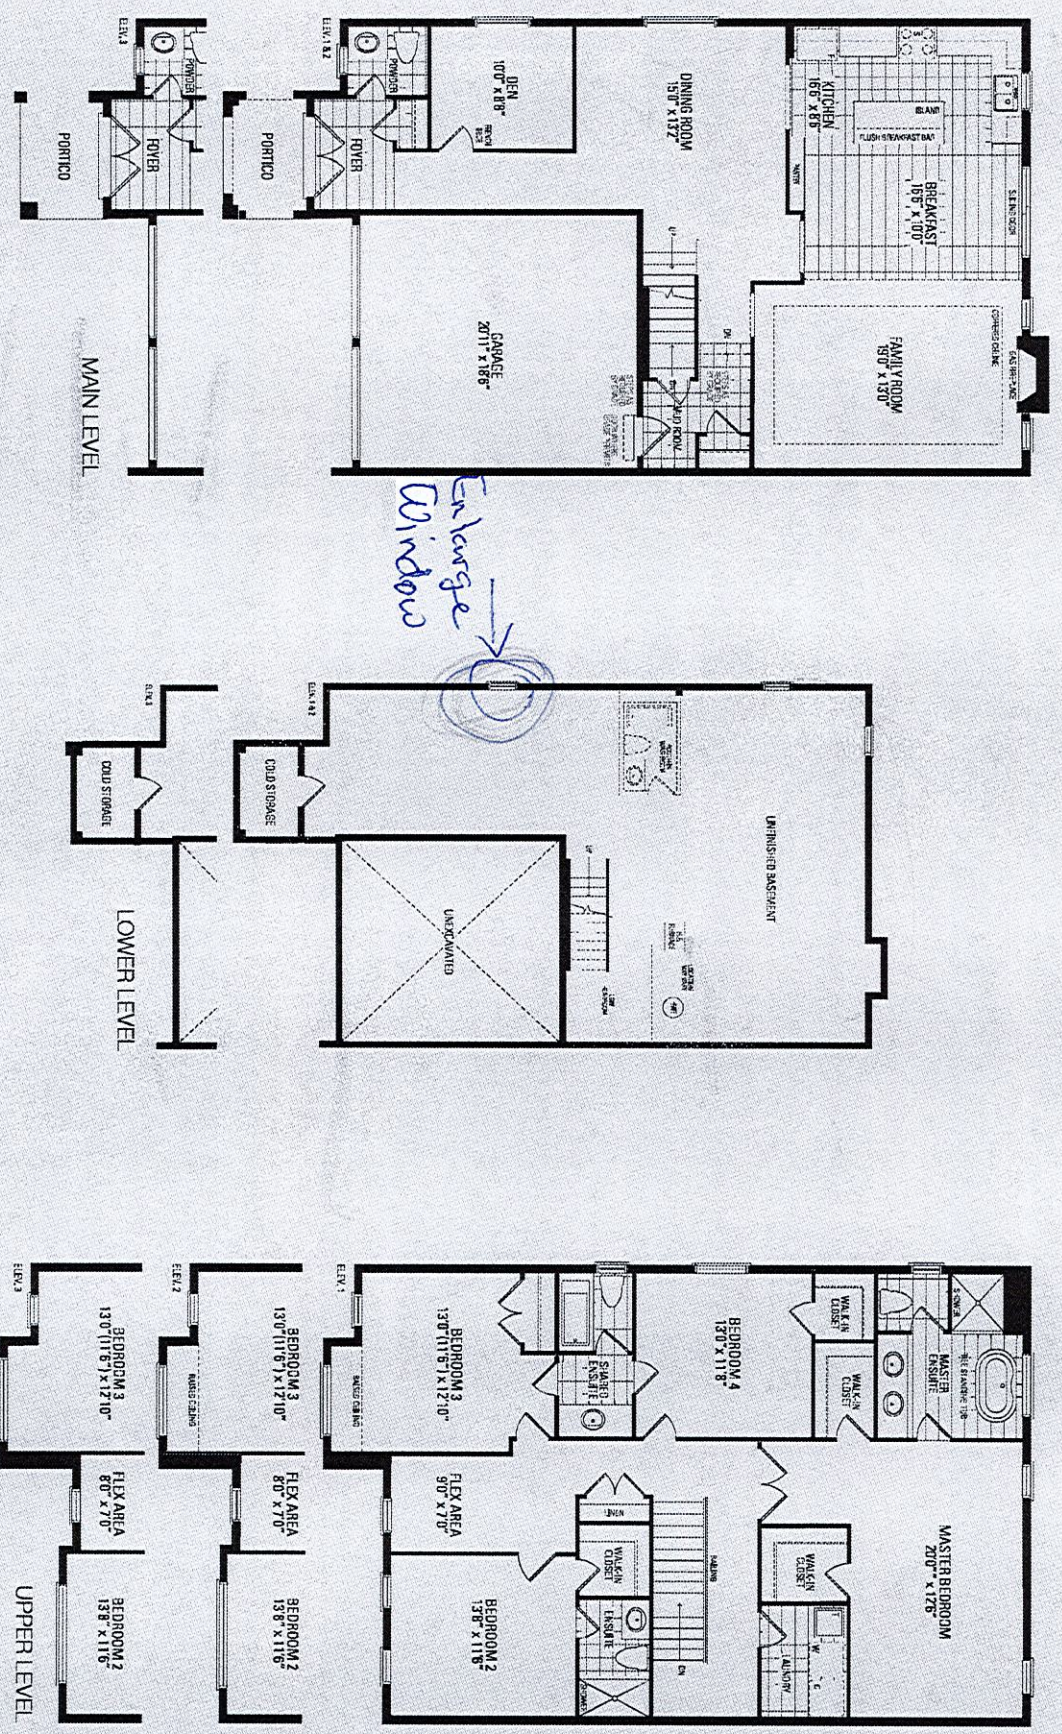

Enlarge Window

* 1st Floor 10ft Ceiling *

Orientation of home may be reversed and purchaser agrees to accept the same. Steps and porches may vary at any exterior entrance ways due to grading variance. Actual usable floor space may vary from the stated floor areas. All renderings are artist's concept. Dimensions, specifications and architectural detailing subject to modifications. Roofline and adjoining model types may vary due to siting. E. & O. E. May 2023