

CONSTRUCTION SUMMARY

Palmetto - Zadorra Estates Corp.

RECEIVED

PURCHASERS: Premchander GANNU and Sowjanya VYSYARAJU

JUN 14 2023

TEL:

LOT / PHASE 84 / 1	REG. PLAN #	HOUSE TYPE Rose 6 Elev 2 (4 Bedroom)		
-----------------------	-------------	---	--	--

CONSTRUCTION

1 - LOWER LEVEL - BASEMENT 8 FOOT 6 INCH CONCRETE POUR - MEASURED FROM TOP OF FOOTING TO TOP OF FOUNDATION WALL 13Jun23 Note:	
1 - FIRST FLOOR INCREASE CEILING HEIGHT FROM 9 FEET TO 10 FEET 13Jun23 Note:	
2 - ENLARGED BASEMENT WINDOWS (MAY REQUIRE WINDOW WELLS) - WINDOW IS 30 INCHES X 24 INCHES 13Jun23 Note:	

PROMOTIONAL

1 - PARTIAL REDEMPTION OF PROMOTIONAL PACKAGE \$ BALANCE FORWARD \$ TO BE USED AT A LATER DATE. ORIGINAL PROMOTIONAL PACKAGE OF \$ AS PER SCHEDULE PE. 13Jun23 Note:	
1 - LESS CREDIT FROM PURCHASER EXTRA SHEET IN OFFER 13Jun23 Note:	


EXTRAS AS PER OFFER

The Vendor agrees that notwithstanding any other term or provision in this Agreement included in the Purchase Price and in addition to those items detailed in Schedule GP to the Agreement of Purchase and Sale, the Purchaser is entitled to a credit of Fif Worksheet Note:	
---	--

This Document is Extremely Time Sensitive - Printed 14 Jun 23 at 9:19

Rose 6 40' LOT

ELEVATION 1 3,215 sq.ft. • ELEVATION 2 3,197 sq.ft. • ~~ELEVATION 3 3,197 sq.ft.~~
INCLUDES 11 SQ.FT. OF OPEN AREA.

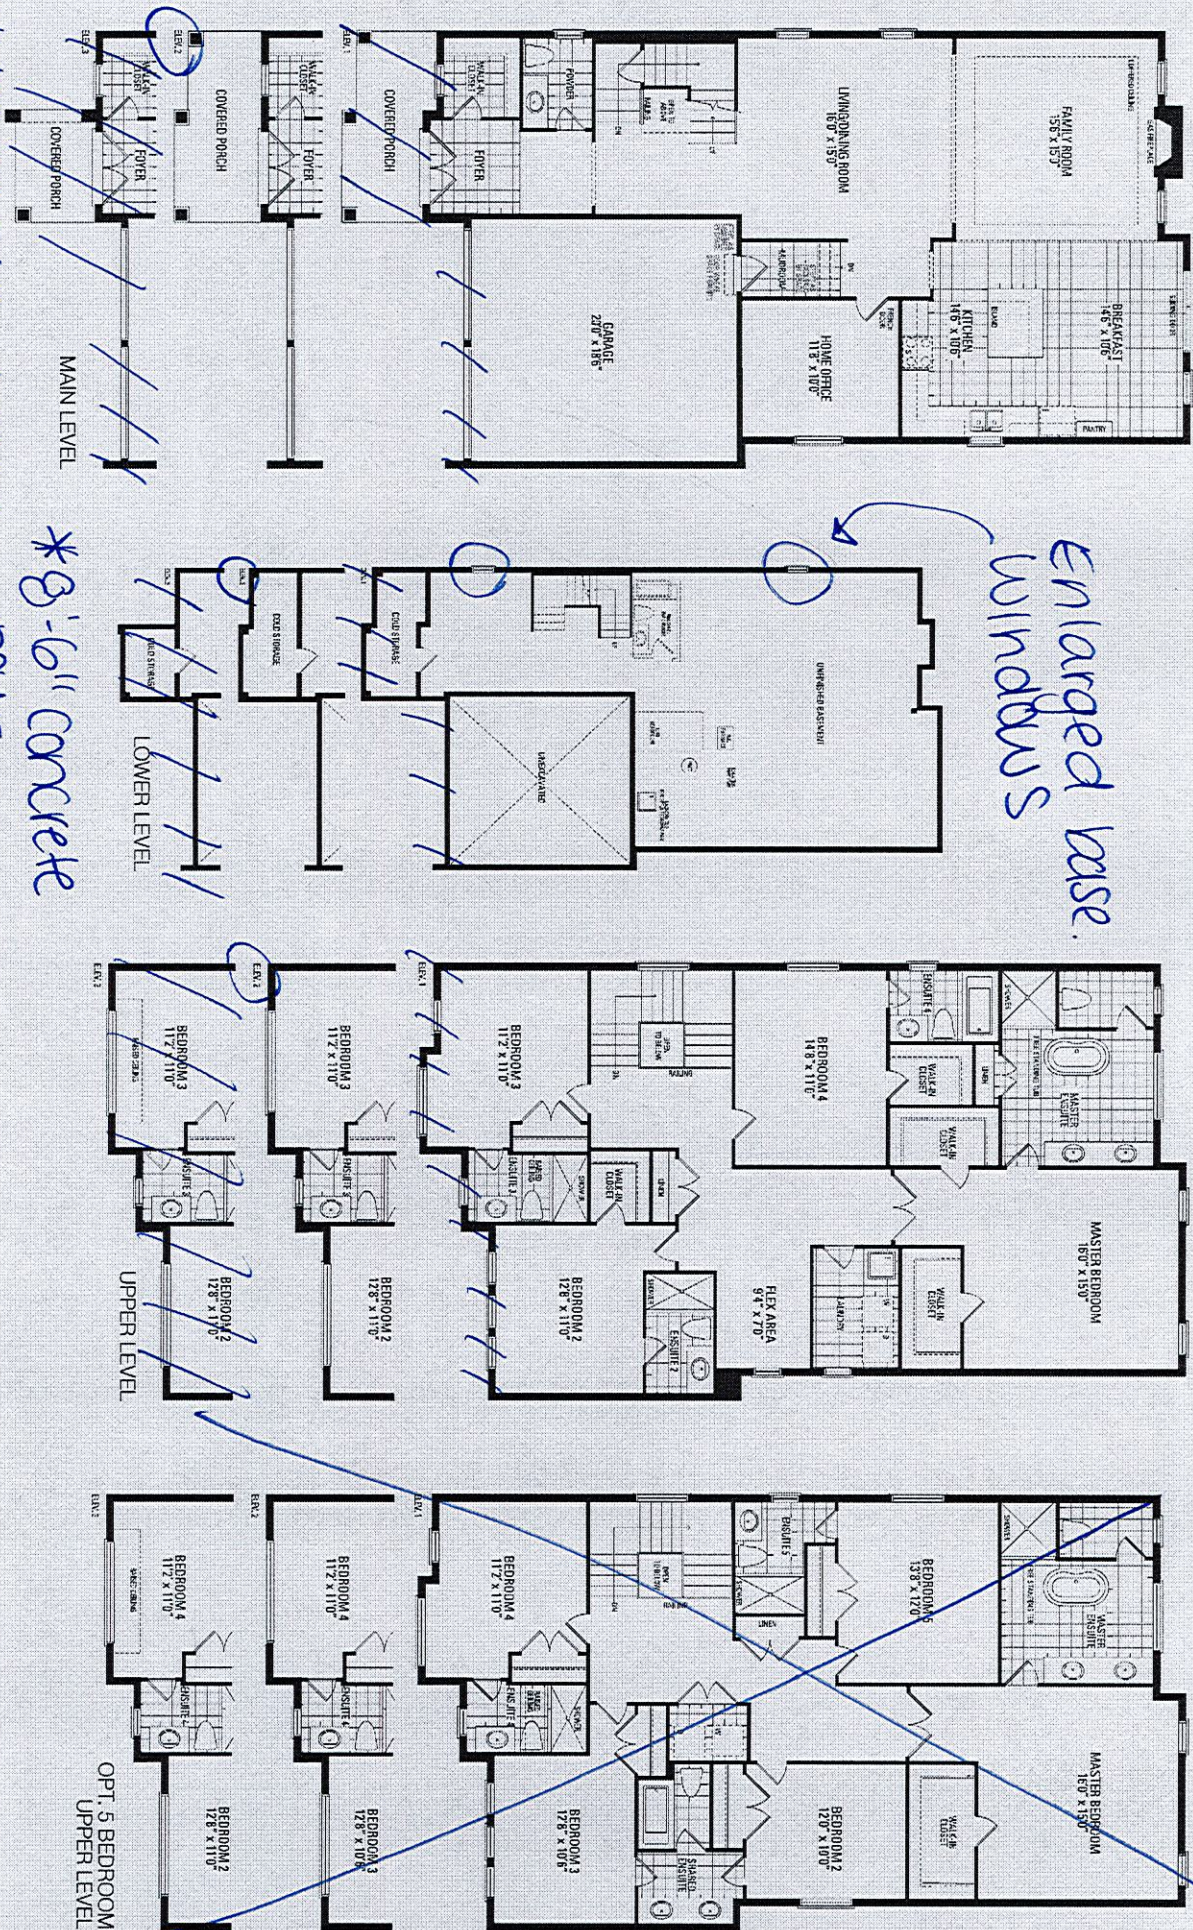

*10'-0" ceiling height
*8'-6" concrete pour
Orientation of home may be reversed and purchaser agrees to accept the same. Steps and porches may vary at any exterior entrance ways due to grading variance. Actual usable floor space may vary from the stated floor areas. All renderings are artist's concept. Dimensions, specifications and architectural detailing subject to modifications. Roofline and adjoining model types may vary due to siting. E. & O. E. May 2023