

CONSTRUCTION SUMMARY

Palmetto - Zadorra Estates Corp.

RECEIVED

JUN 14 2023

TEL:

PURCHASERS: Chandrasekhar YARRAMSETTY and Sravani YARRAMSETTY

LOT / PHASE 142 / 1	REG. PLAN #	HOUSE TYPE Penrose 2 Elev 3		
------------------------	-------------	--------------------------------	--	--

CONSTRUCTION

3 - ENLARGED BASEMENT WINDOWS (MAY REQUIRE WINDOW WELLS) - WINDOW IS 30 INCHES X 24 INCHES 14Jun23 Note:	
1 - LOWER LEVEL - BASEMENT 8 FOOT 6 INCH CONCRETE POUR - MEASURED FROM TOP OF FOOTING TO TOP OF FOUNDATION WALL 14Jun23 Note:	
1 - FIRST FLOOR INCREASE CEILING HEIGHT FROM 9 FEET TO 10 FEET 14Jun23 Note:	

PROMOTIONAL


1 - LESS CREDIT FROM PURCHASER EXTRA SHEET IN OFFER 14Jun23 Note:	
--	--

This Document is Extremely Time Sensitive - Printed 14 Jun 23 at 10:38


Lot 142 Zadorra

Penrose 2 40' LOT

ELEVATION 1 3,045 sq.ft. • ELEVATION 2 3,045 sq.ft. • ELEVATION 3 3,042 sq.ft.

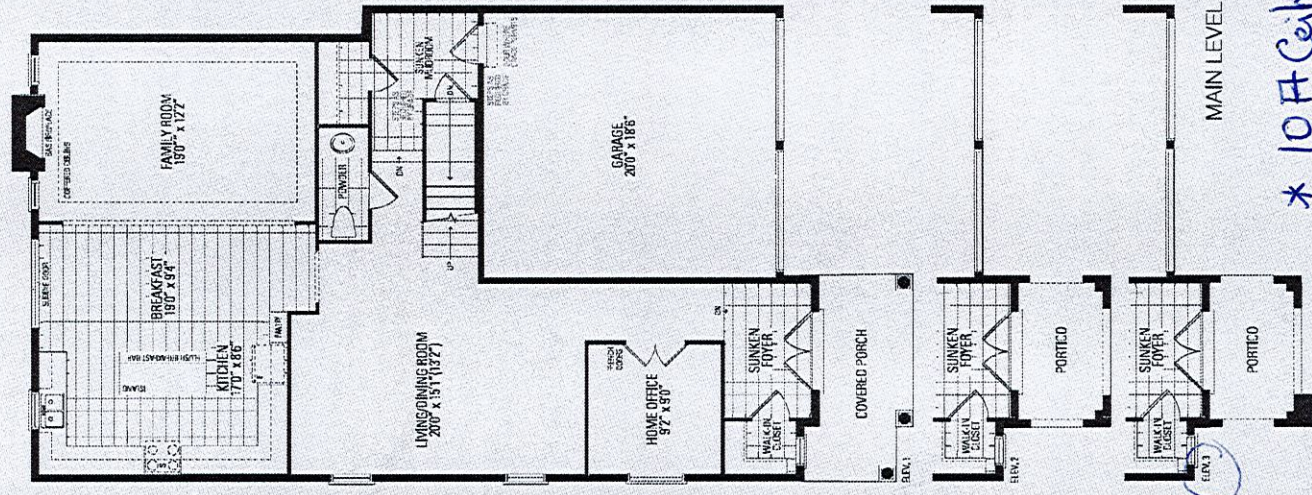

* 10 FT Ceilings 1st Floor *

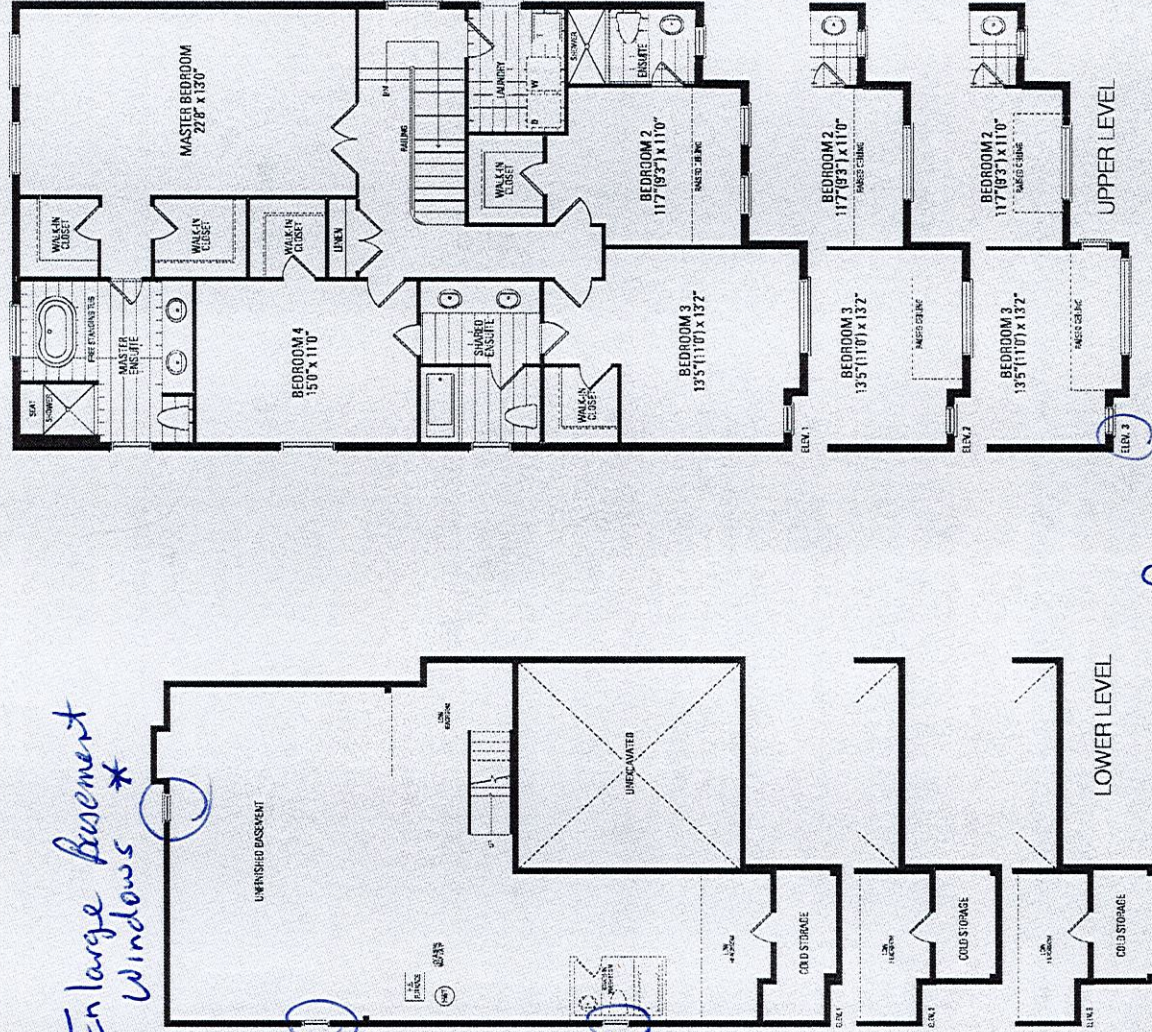

* Enlarge Basement Windows *

* 8 FT 6 in Concrete Pour *

