



CONSTRUCTION SUMMARY

Palmetto - Zadorra Estates Corp.

RECEIVED

PURCHASERS: Kartheek Reddy KATTA and Gayatri Shashanka KOMATIREDDY

JUN 15 2023

TEL:

LOT / PHASE 85 / 1	REG. PLAN #	HOUSE TYPE Villa 5 Elev 3		
-----------------------	-------------	------------------------------	--	--

CONSTRUCTION

3 - ENLARGED BASEMENT WINDOWS (MAY REQUIRE WINDOW WELLS) - WINDOW IS 30 INCHES X 24 INCHES 14Jun23 Note:	
---	--

PROMOTIONAL

1 - PARTIAL REDEMPTION OF PROMOTIONAL PACKAGE \$1,950.00. BALANCE FORWARD \$13,050.00 TO BE USED AT A LATER DATE. ORIGINAL PROMOTIONAL PACKAGE OF \$15,000.00 AS PER SCHEDULE PE. 14Jun23 Note:	
--	--

EXTRAS AS PER OFFER



The Vendor agrees that notwithstanding any other term or provision in this Agreement included in the Purchase Price and in addition to those items detailed in Schedule GP to the Agreement of Purchase and Sale, the Purchaser is entitled to a credit of Fif Worksheet Note:	
---	--

This Document is Extremely Time Sensitive - Printed 15 Jun 23 at 8:54




Villa 5 36' LOT

~~ELEVATION 1 2,991 sq.ft.~~ • ~~ELEVATION 2 2,070 sq.ft.~~ • ELEVATION 3 2,873 sq.ft.  
INCLUDES 19 SQ.FT. OF OPEN AREA

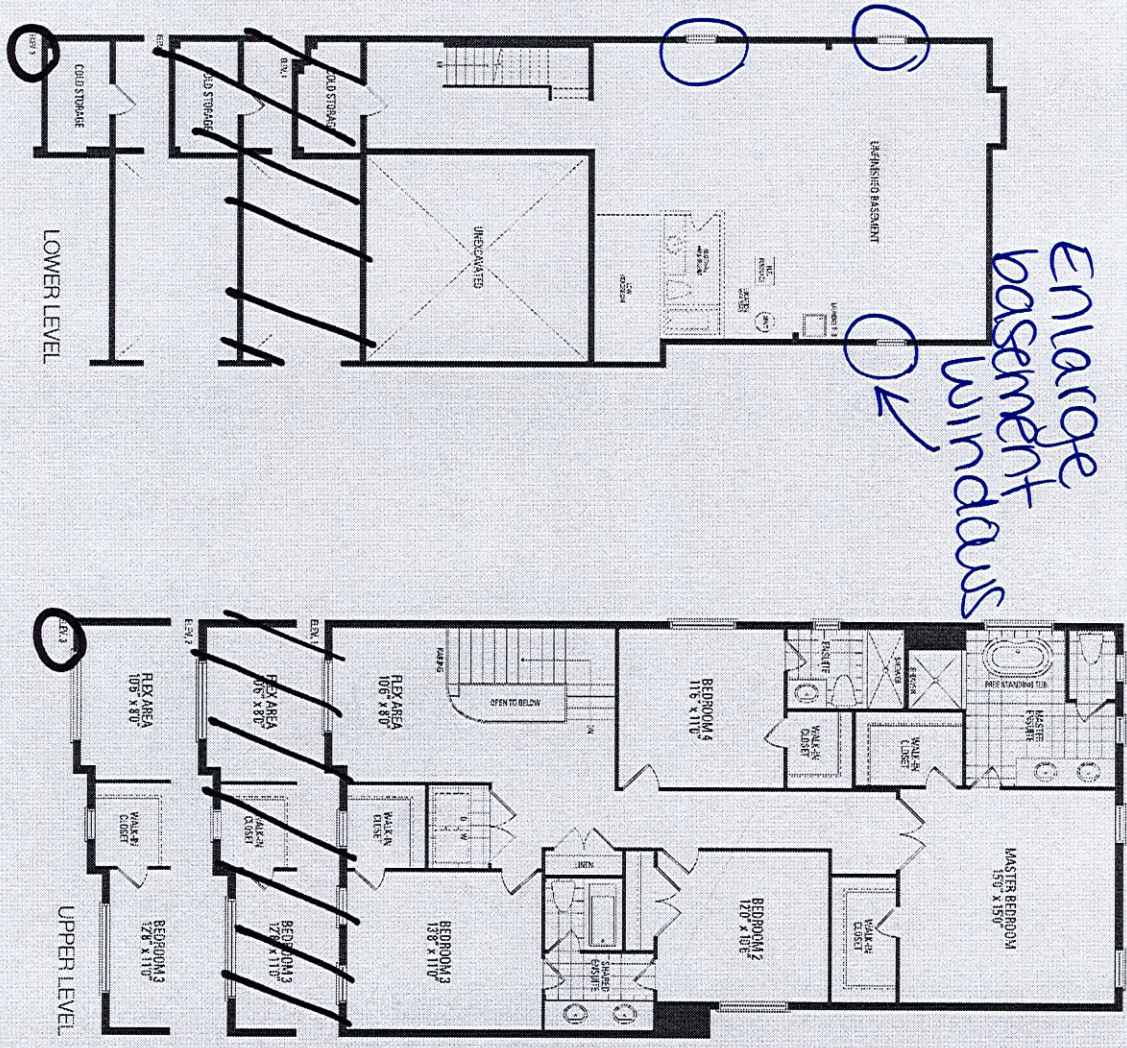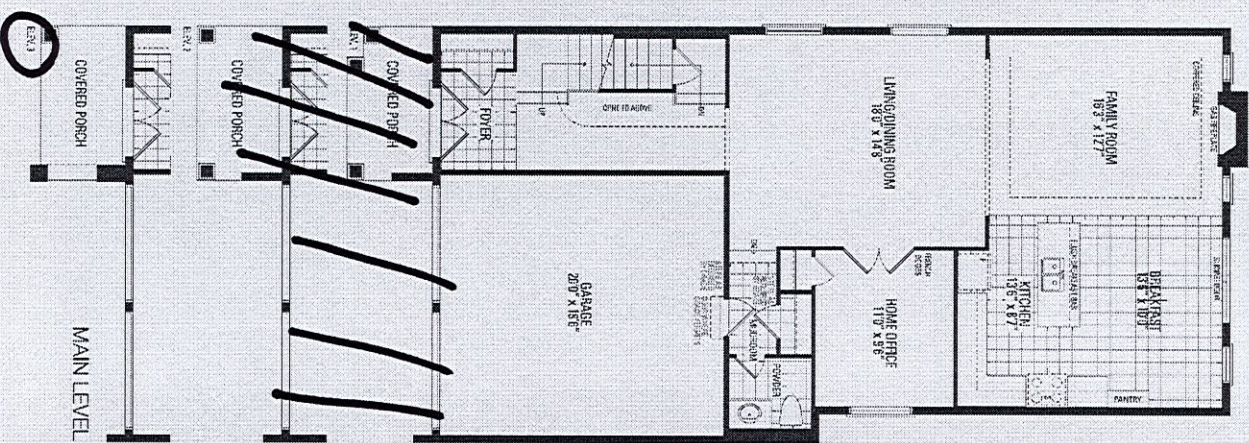

Enlarge  
basement  
windows

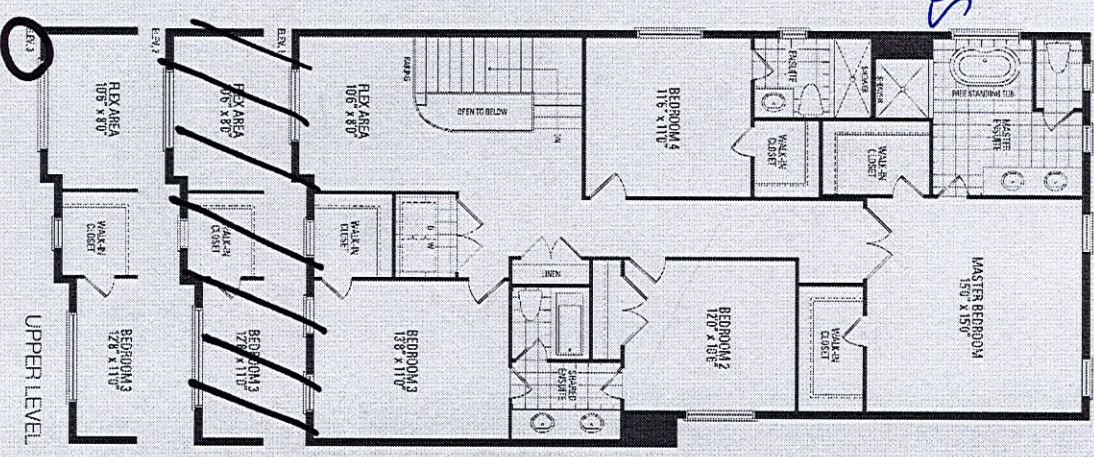

Orientation of home may be reversed and purchaser agrees to accept the same. Steps and porches may vary at any exterior entrance ways due to grading variance. Actual usable floor space may vary from the stated floor areas. All renderings are artist's concept. Dimensions, specifications and architectural detailing subject to modifications. Roofline and adjoining model types may vary due to siting. E. & O. E. May 2023