

CONSTRUCTION SUMMARY
Palmetto - Zadorra Estates Corp.

RECEIVED
JUN 15 2023

TEL:

PURCHASER: Nagarajan SHANMUGA

LOT / PHASE 86 / 1	REG. PLAN #	HOUSE TYPE Villa 2 Elev 1		
-----------------------	-------------	------------------------------	--	--

CONSTRUCTION

3 - ENLARGED BASEMENT WINDOWS (MAY REQUIRE WINDOW WELLS) - WINDOW IS 30 INCHES X 24 INCHES 14Jun23 Note:	
---	--

PROMOTIONAL



1 - PARTIAL REDEMPTION OF PROMOTIONAL PACKAGE \$1,950.00 BALANCE FORWARD \$13,050.00 TO BE USED AT A LATER DATE. ORIGINAL PROMOTIONAL PACKAGE OF \$15,000.00 AS PER SCHEDULE PE. 14Jun23 Note:	
---	--

This Document is Extremely Time Sensitive - Printed 15 Jun 23 at 8:52

LOT #86

Villa 2 36' LOT

ELEVATION 1 2,527 sq.ft. • ELEVATION 2 2,527 sq.ft. • ELEVATION 3 2,523 sq.ft.
INCLUDES 10 SQ.FT. OF OPEN AREA

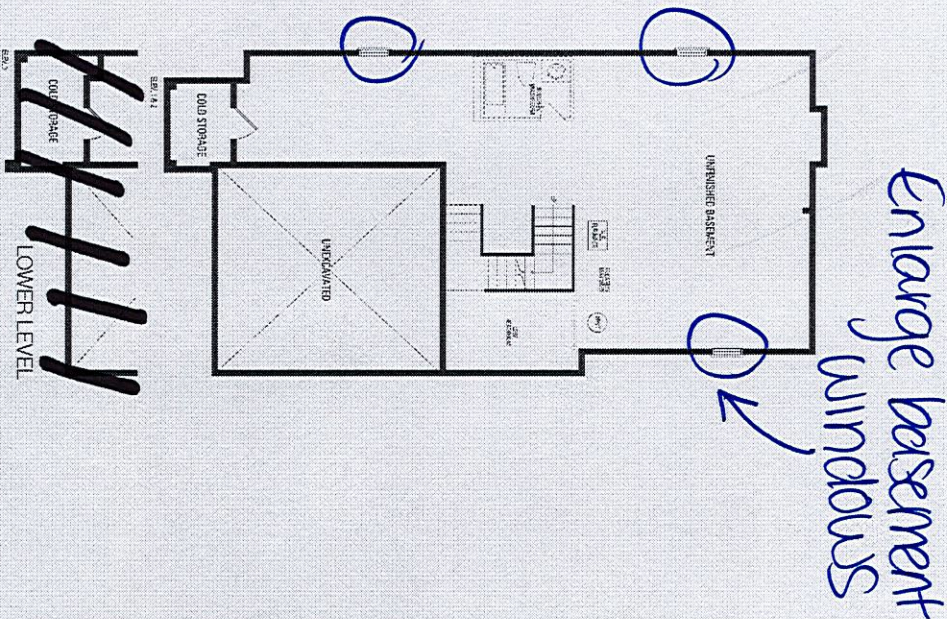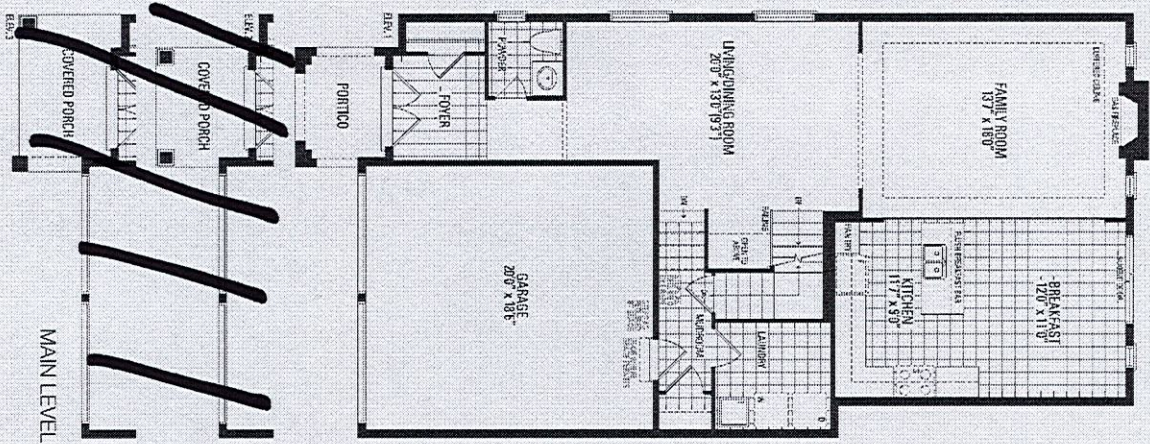

Orientation of home may be reversed and purchaser agrees to accept the same. Steps and porches may vary at any exterior entrance ways due to grading variance. Actual usable floor space may vary from the stated floor areas. All renderings are artist's concept. Dimensions, specifications and architectural detailing subject to modifications. Roofline and adjoining model types may vary due to siting. E. & O. E. May 2023