Greenpark.

CONSTRUCTION SUMMARY

Palmetto - Zadorra Estates Corp.

RECEIVED

PURCHASER: Marie M. RANCY

JUN 2 0 2023

TEL: RES.: 416-629-1943

LOT / PHASE	REG. PLAN#	HOUSE TYPE	
94 / 1		Penrose 2 Elev 3	
74/1		T CHI OSC Z LICY S	

CONSTRUCTION

3 - ENLARGED BASEMENT WINDOWS (MAY REQUIRE WINDOW WELLS) - WINDOW IS 30 INCHES X 24 INCHES

15Jun23 Note:

1 - LOWER LEVEL - BASEMENT 8 FOOT 6 INCH CONCRETE POUR - MEASURED FROM TOP OF FOOTING TO TOP OF

PROMOTIONAL

FOUNDATION WALL 15Jun23 Note:

1 - LESS CREDIT FROM PURCHASER EXTRA SHEET IN OFFER

15Jun23 Note:


EXTRAS AS PER OFFER

The Vendor agrees that notwithstanding any other term or provision in this Agreement included in the Purchase Price and in addition to those items detailed in Schedule GP to the Agreement of Purchase and Sale, the Purchaser is entitled to a credit of Fif Worksheet Note:

This Document is Extremely Time Sensitive - Printed 19 Jun 23 at 15:59

Penrose 2 40' Lot

ELEVATION 1 3,045 sq.ft. ELEVATION 2 3,045 sq.ft. ELEVATION 3 3,042 sq.ft.

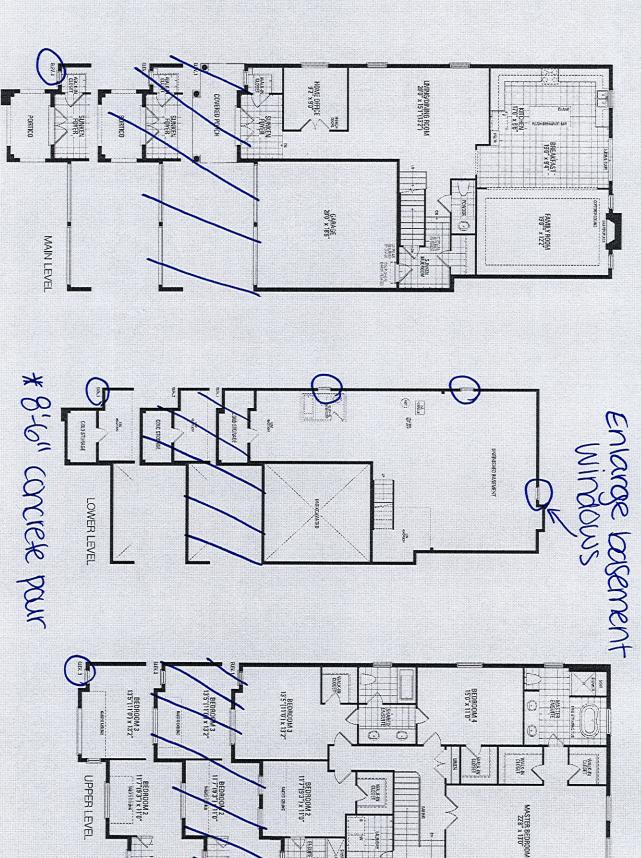

Orientation of home may be reversed and purchaser agrees to accept the same. Steps and porches may vary at any exterior entrance ways due to grading variance. Actual usable floor space may vary from the stated floor areas. All renderings are artist's concept. Dimensions, specifications and architectural detailing subject to modifications. Roofline and adjoining model types may vary due to siting. E. & O. E. May 2023