

CONSTRUCTION SUMMARY

Palmetto - Zadorra Estates Corp.

PURCHASER: Purushotham Naidu PUTHUMAKU

TEL: RES.: 416-357-3267

LOT / PHASE 151 / 1	REG. PLAN #	HOUSE TYPE Villa 3 Elev 3		
------------------------	-------------	------------------------------	--	--

CONSTRUCTION

1 - ENLARGED BASEMENT WINDOWS (MAY REQUIRE WINDOW WELLS) - WINDOW IS 30 INCHES X 24 INCHES 19Jun23 Note:	
1 - FIRST FLOOR INCREASE CEILING HEIGHT FROM 9 FEET TO 10 FEET 19Jun23 Note:	

PROMOTIONAL

1 - LESS CREDIT FROM PURCHASER EXTRA SHEET IN OFFER 19Jun23 Note:	
--	--



EXTRAS AS PER OFFER

The Vendor agrees that notwithstanding any other term or provision in this Agreement included in the Purchase Price and in addition to those items detailed in Schedule GP to the Agreement of Purchase and Sale, the Purchaser is entitled to a credit of Fif Worksheet Note:	
---	--

This Document is Extremely Time Sensitive - Printed 19 Jun 23 at 16:07

Villa 3 36' LOT

ELEVATION 1 2,662 sq.ft. • ELEVATION 2 2,662 sq.ft. • ELEVATION 3 2,647 sq.ft.
INCLUDES 16 SQ.FT. OF OPEN AREA

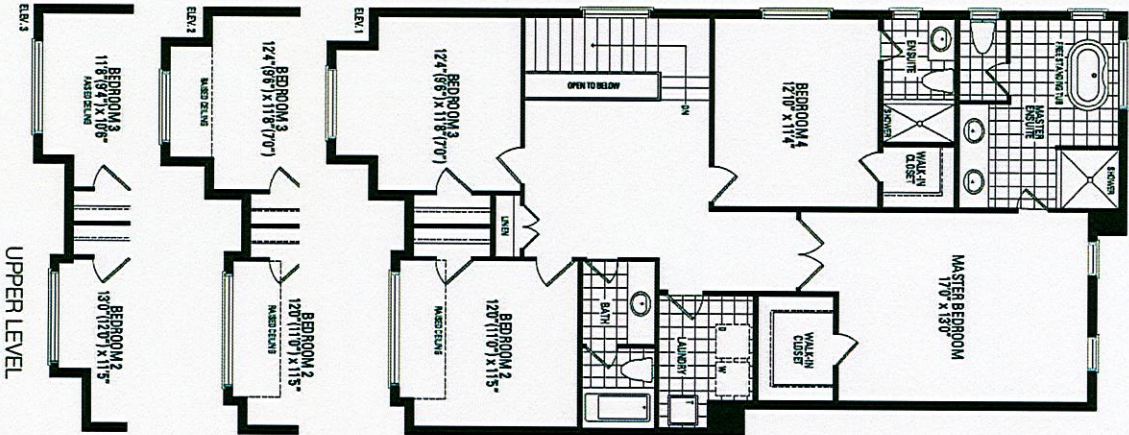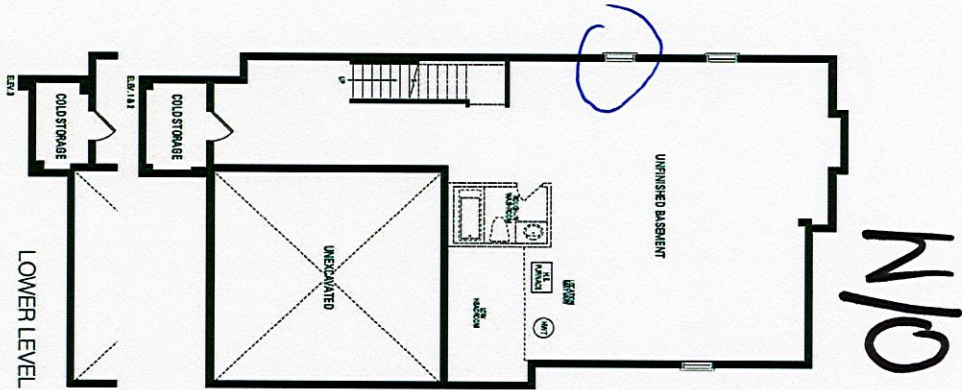

Orientation of home may be reversed and purchaser agrees to accept the same. Steps and porches may vary at any exterior entrance ways due to grading variance. Actual usable floor space may vary from the stated floor areas. All renderings are artist's concept. Dimensions, specifications and architectural detailing subject to modifications. Roofline and adjoining model types may vary due to siting. E. & O. E. May 2023