

| CONSTRUCTION SUMMARY | | | | |
|--|-------------|-----------------|-------------------------|--|
| Palmetto - Zadorra Estates Corp. | | | | |
| PURCHASERS: Consing Tharshni JACOB and Franklin Jailes FRANCIS | | | TEL: RES.: 647-525-3658 | |
| LOT / PHASE | REG. PLAN # | HOUSE TYPE | | |
| 1 / 1 | | Villa 12 Elev 3 | | |

CONSTRUCTION

| | |
|---|--|
| 4 - ENLARGED BASEMENT WINDOWS (MAY REQUIRE WINDOW WELLS) - WINDOW IS 30 INCHES X 24 INCHES 22Jun23 Note: | |
| 1 - FIRST FLOOR INCREASE CEILING HEIGHT FROM 9 FEET TO 10 FEET 22Jun23 Note: | |

PROMOTIONAL


| | |
|--|--|
| 1 - LESS CREDIT FROM PURCHASER EXTRA SHEET IN OFFER 22Jun23 Note: | |
|--|--|

This Document is Extremely Time Sensitive - Printed 23 Jun 23 at 9:01

LOT #1

Villa 12 36' LOT

~~ELEVATION 1 2,811 sq.ft.~~ • ~~ELEVATION 2 2,811 sq.ft.~~ • ELEVATION 3 2,784 sq.ft.

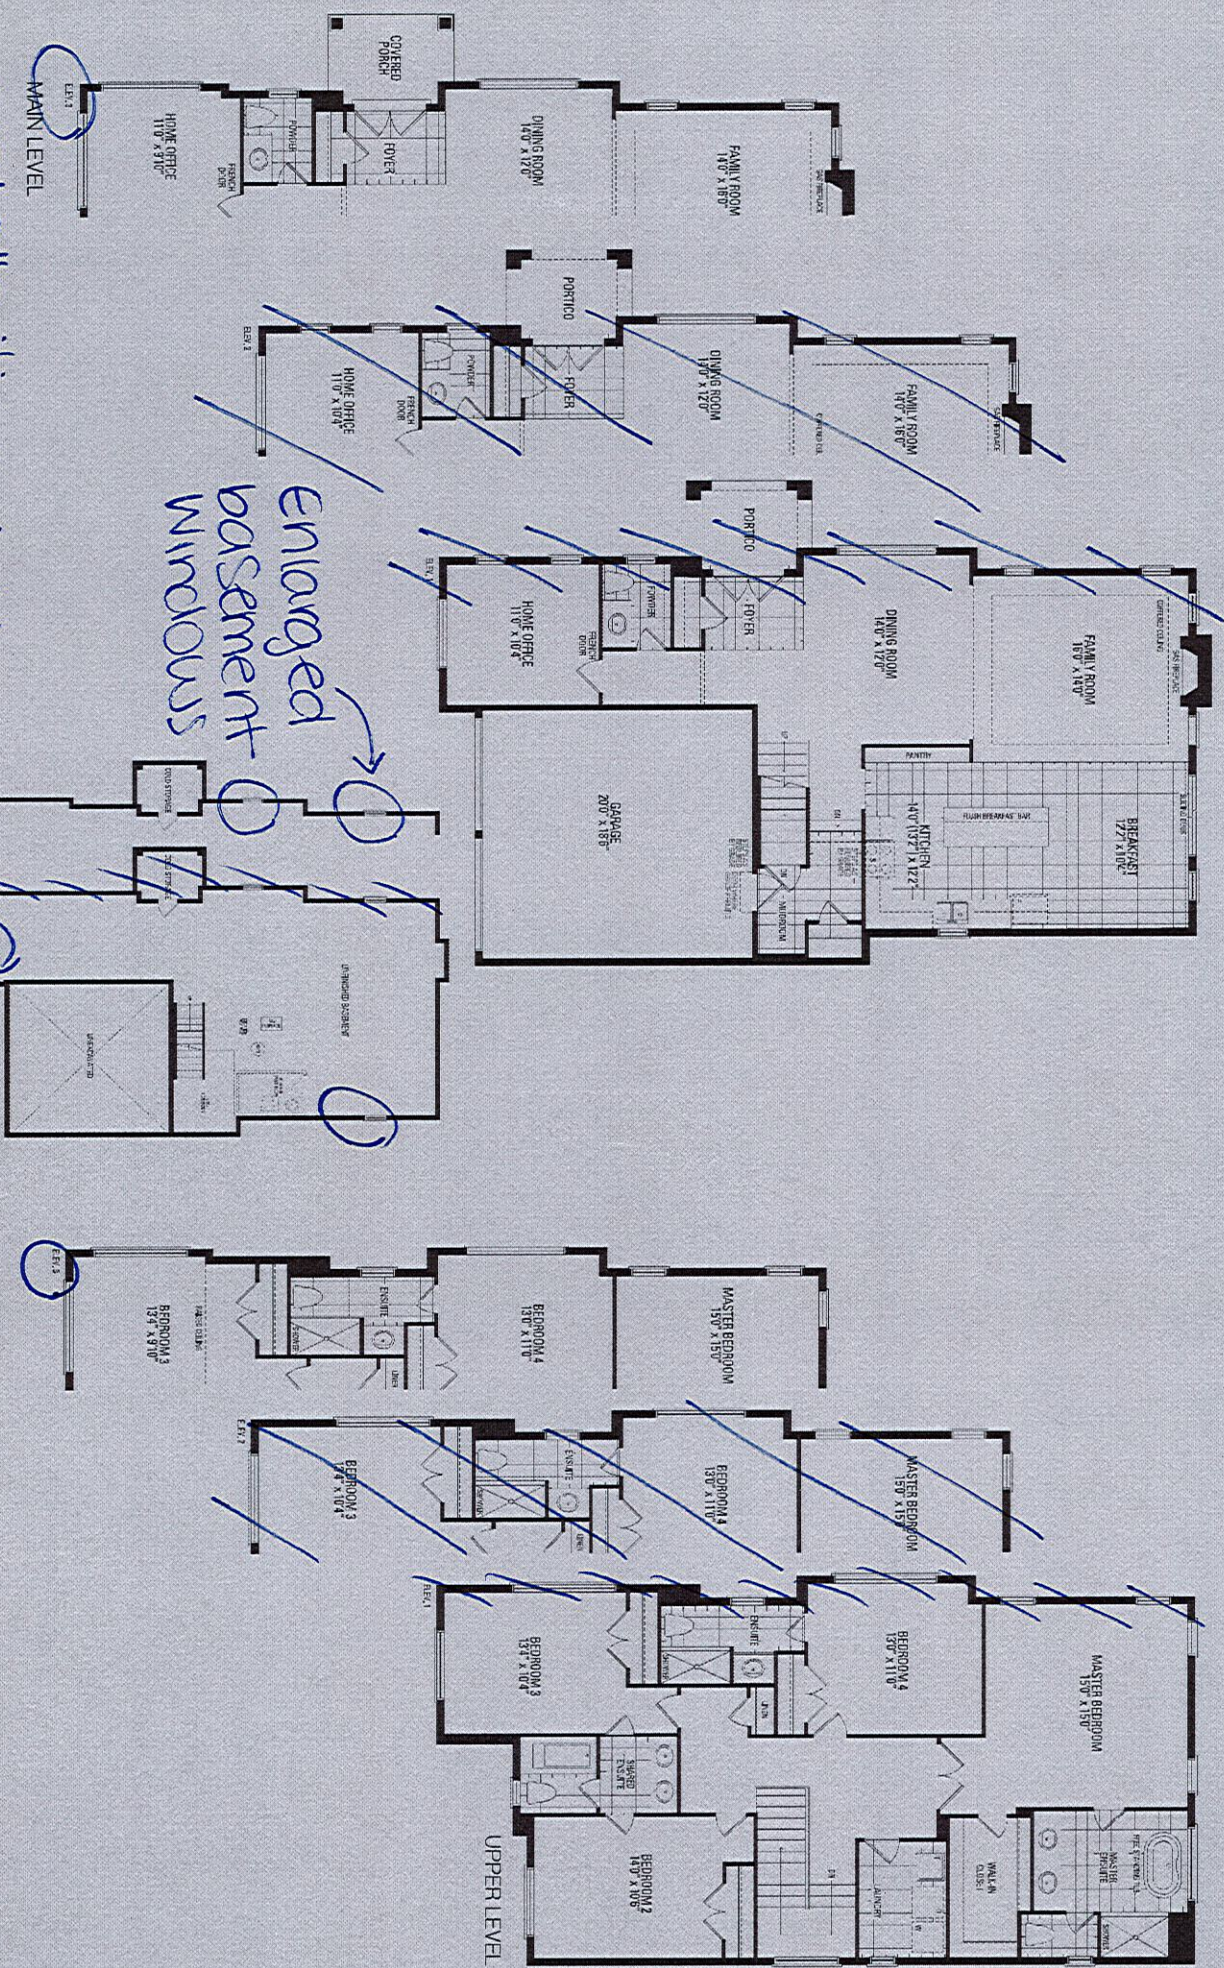

Orientation of home may be reversed and purchaser agrees to accept the same. Steps and porches may vary at any exterior entrance ways due to grading variance. Actual usable floor space may vary from the stated floor areas. All renderings are artist's concept. Dimensions, specifications and architectural detailing subject to modifications. Floorline and adjoining model types may vary due to siting. E. & O. E. May 2023