

CONSTRUCTION SUMMARY

Palmetto - Zadorra Estates Corp.

RECEIVED

JUN 27 2023

PURCHASERS: Achuyuth Kumar PYDMARRI and Venkata Geetha Sushma PYDMARRI

TEL: RES.: 365-888-5633

| | | | | |
|-----------------------|-------------|------------------------------|--|--|
| LOT / PHASE 83 / 1 | REG. PLAN # | HOUSE TYPE Rose 12 Elev 2 | | |
|-----------------------|-------------|------------------------------|--|--|

CONSTRUCTION

| | |
|--|--|
| 4 - ENLARGED BASEMENT WINDOWS (MAY REQUIRE WINDOW WELLS) - WINDOW IS 30 INCHES X 24 INCHES 09Jun23 Note: | |
| 1 - FIRST FLOOR INCREASE CEILING HEIGHT FROM 9 FEET TO 10 FEET 09Jun23 Note: | |
| 1 - LOWER LEVEL - BASEMENT 8 FOOT 6 INCH CONCRETE POUR - MEASURED FROM TOP OF FOOTING TO TOP OF FOUNDATION WALL 09Jun23 Note: | |

PROMOTIONAL

| | |
|--|--|
| 1 - LESS CREDIT FROM PURCHASER EXTRA SHEET IN OFFER 09Jun23 Note: | |
|--|--|


EXTRAS AS PER OFFER

| | |
|---|--|
| The Vendor agrees that notwithstanding any other term or provision in this Agreement included in the Purchase Price and in addition to those items detailed in Schedule GP to the Agreement of Purchase and Sale, the Purchaser is entitled to a credit of Fif Worksheet Note: | |
|---|--|

This Document is Extremely Time Sensitive - Printed 21 Jun 23 at 13:02

Rose 12 40' LOT

ELEVATION 1 3,162 sq.ft. • ELEVATION 2 3,162 sq.ft. • ELEVATION 3 3,162 sq.ft.

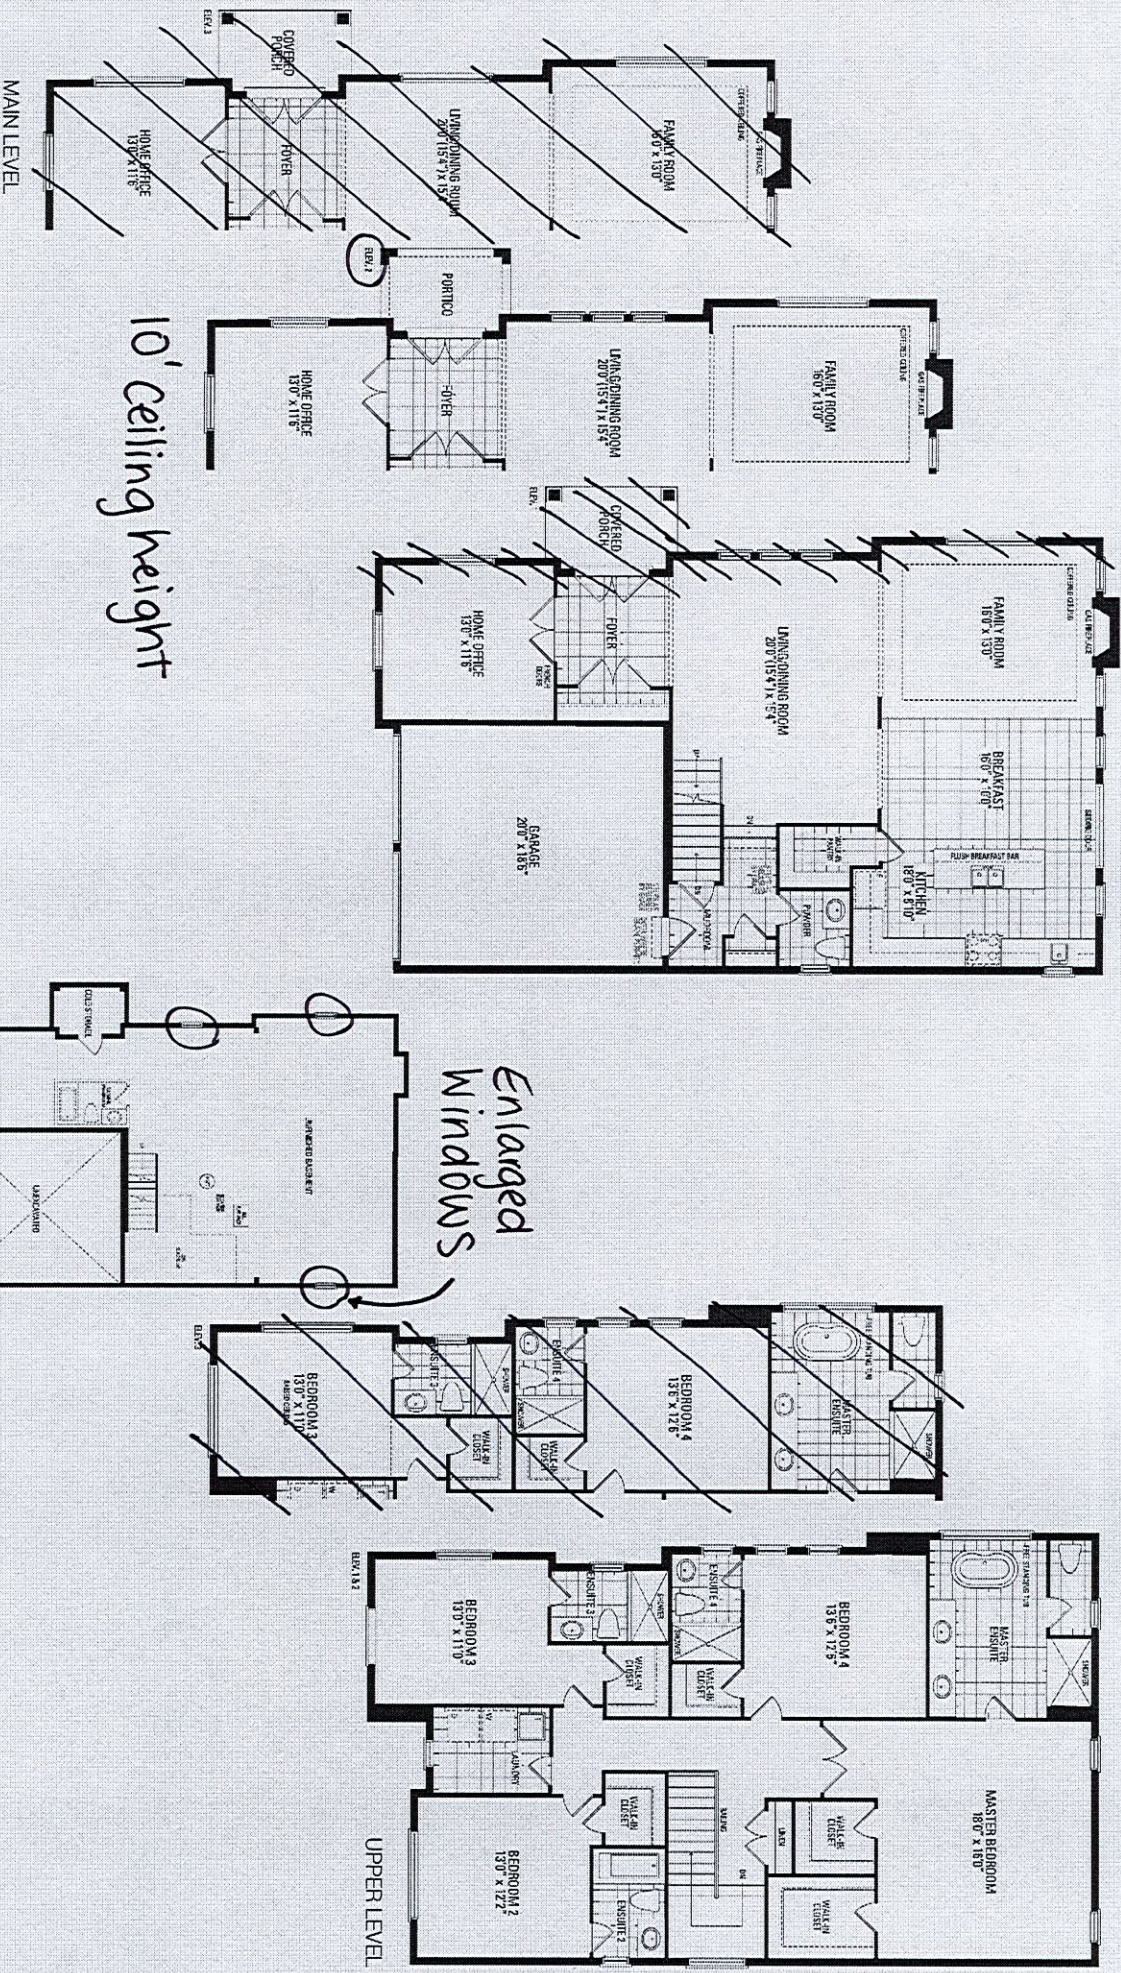

Orientation of home may be reversed and purchaser agrees to accept the same. Steps and porches may vary at any exterior entrance ways due to grading variance. Actual usable floor space may vary from the stated floor areas. All renderings are artist's concept. Dimensions, specifications and architectural detailing subject to modifications. Roofline and adjoining model types may vary due to siting. E. & O. E. May 2023