

CONSTRUCTION SUMMARY

Palmetto - Zadorra Estates Corp.

RECEIVED
JUN 27 2023

PURCHASERS: Ravi Kumar KEELU and Ratna Sudha CHADUVULA

TEL: RES.: 647-287-4282

LOT / PHASE 92 / 1	REG. PLAN #	HOUSE TYPE Rose 6 Elev 3 (4 Bedroom)		
-----------------------	-------------	---	--	--

CONSTRUCTION

1 - FIRST FLOOR INCREASE CEILING HEIGHT FROM 9 FEET TO 10 FEET 19Jun23 Note:	
1 - LOWER LEVEL - BASEMENT 8 FOOT 6 INCH CONCRETE POUR - MEASURED FROM TOP OF FOOTING TO TOP OF FOUNDATION WALL 19Jun23 Note:	
2 - ENLARGED BASEMENT WINDOWS (MAY REQUIRE WINDOW WELLS) - WINDOW IS 30 INCHES X 24 INCHES 19Jun23 Note:	

PROMOTIONAL

1 - LESS CREDIT FROM PURCHASER EXTRA SHEET IN OFFER 19Jun23 Note:	
--	--

EXTRAS AS PER OFFER


The Vendor agrees that notwithstanding any other term or provision in this Agreement included in the Purchase Price and in addition to those items detailed in Schedule GP to the Agreement of Purchase and Sale, the Purchaser is entitled to a credit of Fif Worksheet Note:	
---	--

This Document is Extremely Time Sensitive - Printed 22 Jun 23 at 11:19

LOT #92

Rose 6 40' LOT

ELEVATION 1 3,216 sq.ft. • ELEVATION 2 3,197 sq.ft. • ELEVATION 3 3,197 sq.ft.
INCLUDES 11 SQ.FT. OF OPEN AREA.

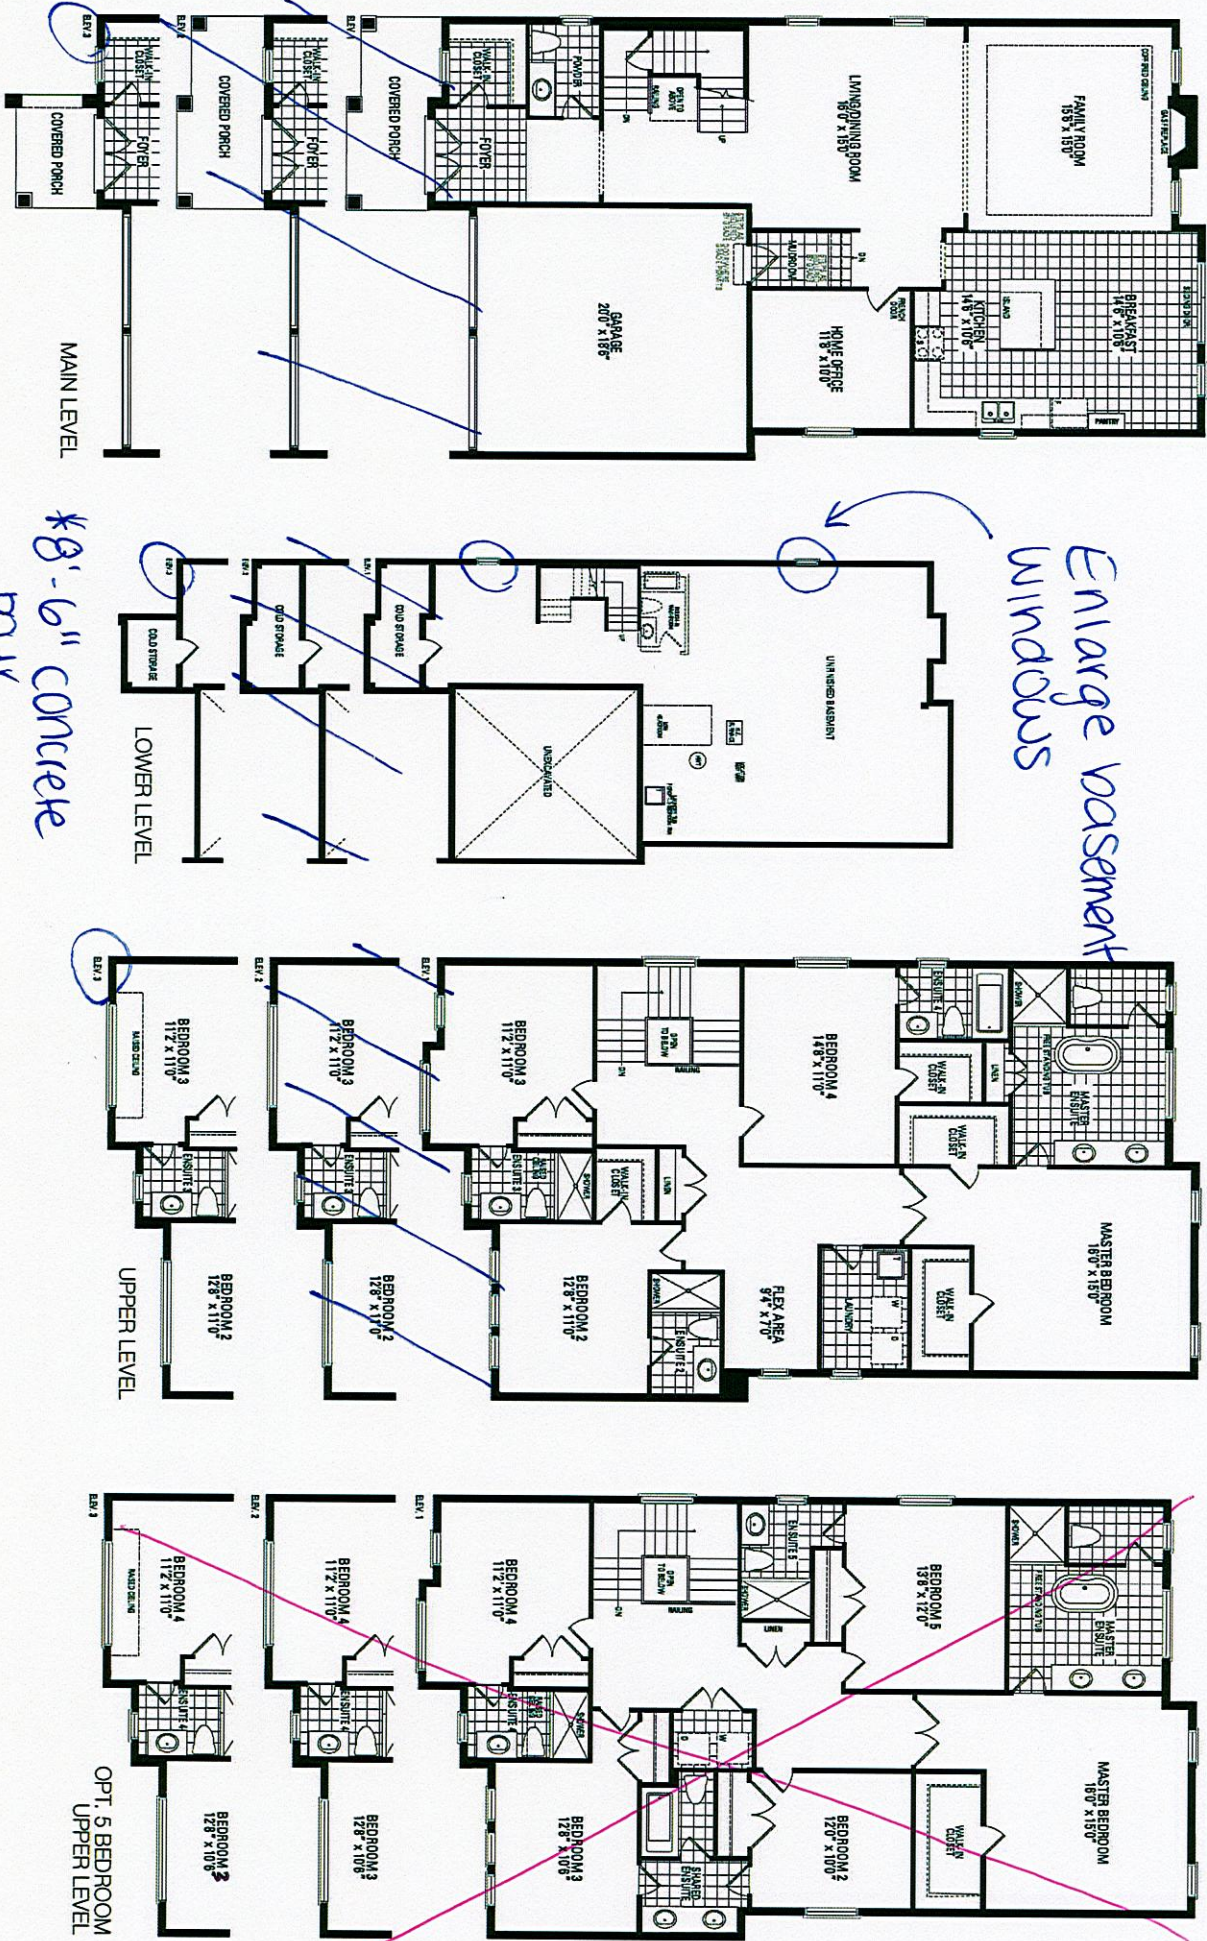

*10'-0" ceiling height
Orientation of home may be reversed and purchaser agrees to accept the same. Steps and porches may vary at any exterior entrance ways due to grading variance. Actual usable floor space may vary from the stated floor areas. All renderings are artist's concept. Dimensions, specifications and architectural detailing subject to modifications. Routine and adjoining model types may vary due to siting. E. & O. E. May 2023