

CONSTRUCTION SUMMARY

Palmetto - Zadorra Estates Corp.

PURCHASER: Saima ZAIDI

TEL: RES.: 437-971-5425

LOT / PHASE 26 / 1	REG. PLAN #	HOUSE TYPE River 9 Elev 3		
-----------------------	-------------	------------------------------	--	--

CONSTRUCTION

2 - ENLARGED BASEMENT WINDOWS (MAY REQUIRE WINDOW WELLS) - WINDOW IS 30 INCHES X 24 INCHES 23Jun23 Note:	
---	--

PROMOTIONAL

1 - PARTIAL REDEMPTION OF PROMOTIONAL PACKAGE \$1,300.00. BALANCE FORWARD \$8,700.00 TO BE USED AT A LATER DATE. ORIGINAL PROMOTIONAL PACKAGE OF \$10,000.00 AS PER SCHEDULE PE. 23Jun23 Note:	
---	--



This Document is Extremely Time Sensitive - Printed 26 Jun 23 at 9:05

LOT #26

River 9 30' LOT
FOR LOT 26

~~ELEVATION 1 2,411 sq.ft.~~ • ~~ELEVATION 2 2,414 sq.ft.~~ • ELEVATION 3 2,410 sq.ft.

Enlarge
basement
windows

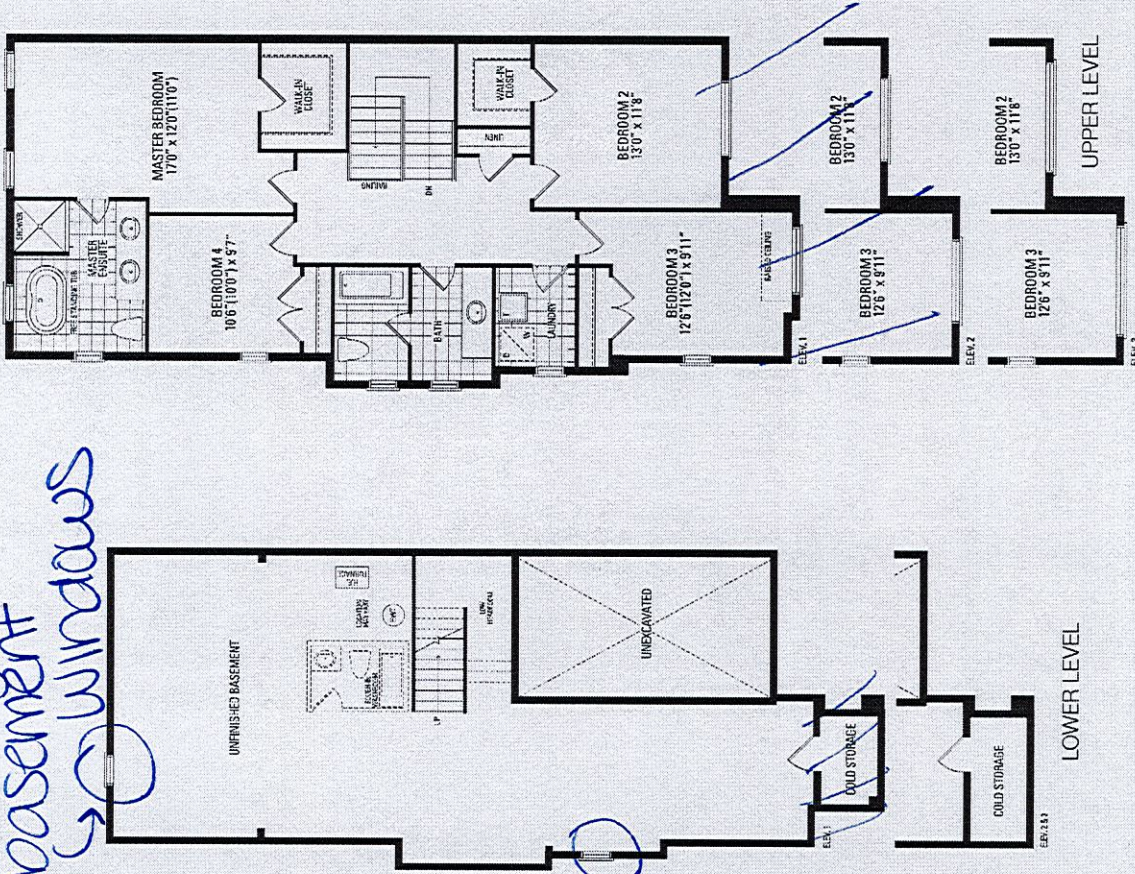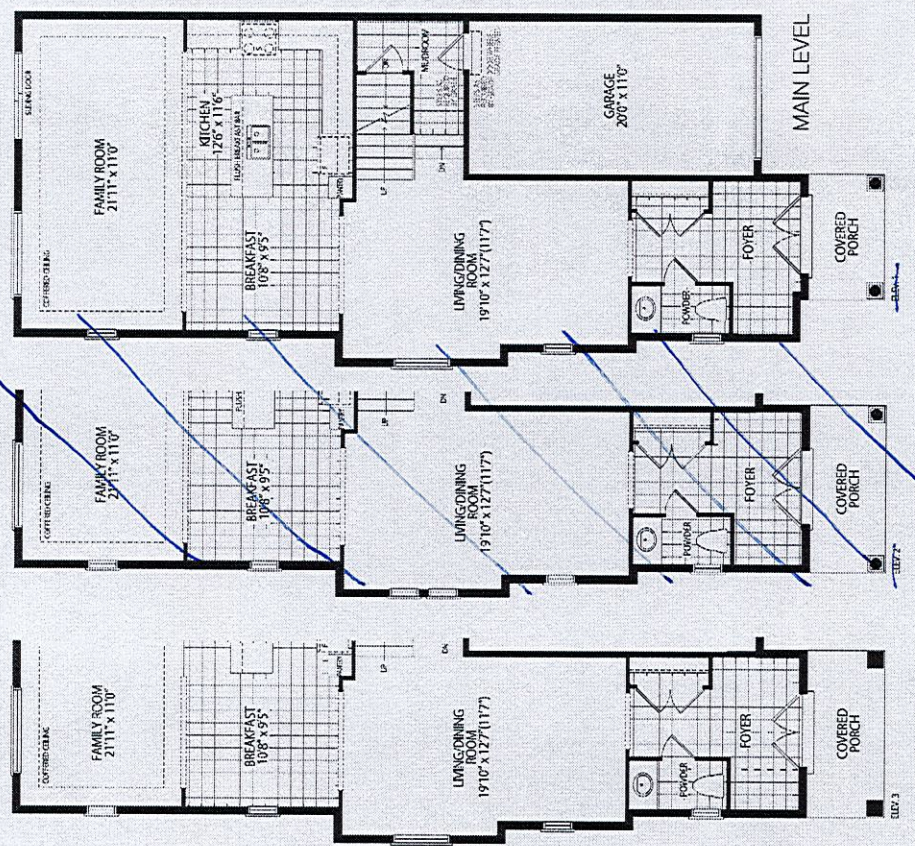

Orientation of home may be reversed and purchaser agrees to accept the same. Steps and porches may vary at any exterior entrance ways due to grading variance. Actual usable floor space may vary from the stated floor areas. All renderings are artist's concept. Dimensions, specifications and architectural detailing subject to modifications. Roofline and adjoining model types may vary due to siting. E. & O. E. May 2023