

CONSTRUCTION SUMMARY		RECEIVED
Palmetto - Zadorra Estates Corp.		JUL 12 2023
PURCHASERS: Shair Baz SHAH and Hina Mir BAZ		TEL: RES.: 306-715-8443

LOT / PHASE	REG. PLAN #	HOUSE TYPE		
37 / 1		Villa 2 Elev 1		

CONSTRUCTION

3 - ENLARGED BASEMENT WINDOWS (MAY REQUIRE WINDOW WELLS) - WINDOW IS 30 INCHES X 24 INCHES	
12Jul23 Note:	

PROMOTIONAL

1 - PARTIAL REDEMPTION OF PROMOTIONAL PACKAGE \$1,950.00. BALANCE FORWARD \$13,050.00 TO BE USED AT A LATER DATE. ORIGINAL PROMOTIONAL PACKAGE OF \$15,000.00 AS PER SCHEDULE PE.	
12Jul23 Note:	


This Document is Extremely Time Sensitive - Printed 12 Jul 23 at 14:50

LOT #37

Villa 2 36' LOT

ELEVATION 1 2,527 sq.ft. • ~~ELEVATION 2 2,527 sq.ft.~~ • ~~ELEVATION 3 2,523 sq.ft.~~
INCLUDES 10 SQ.FT. OF OPEN AREA

Enlarged
Basement
Windows

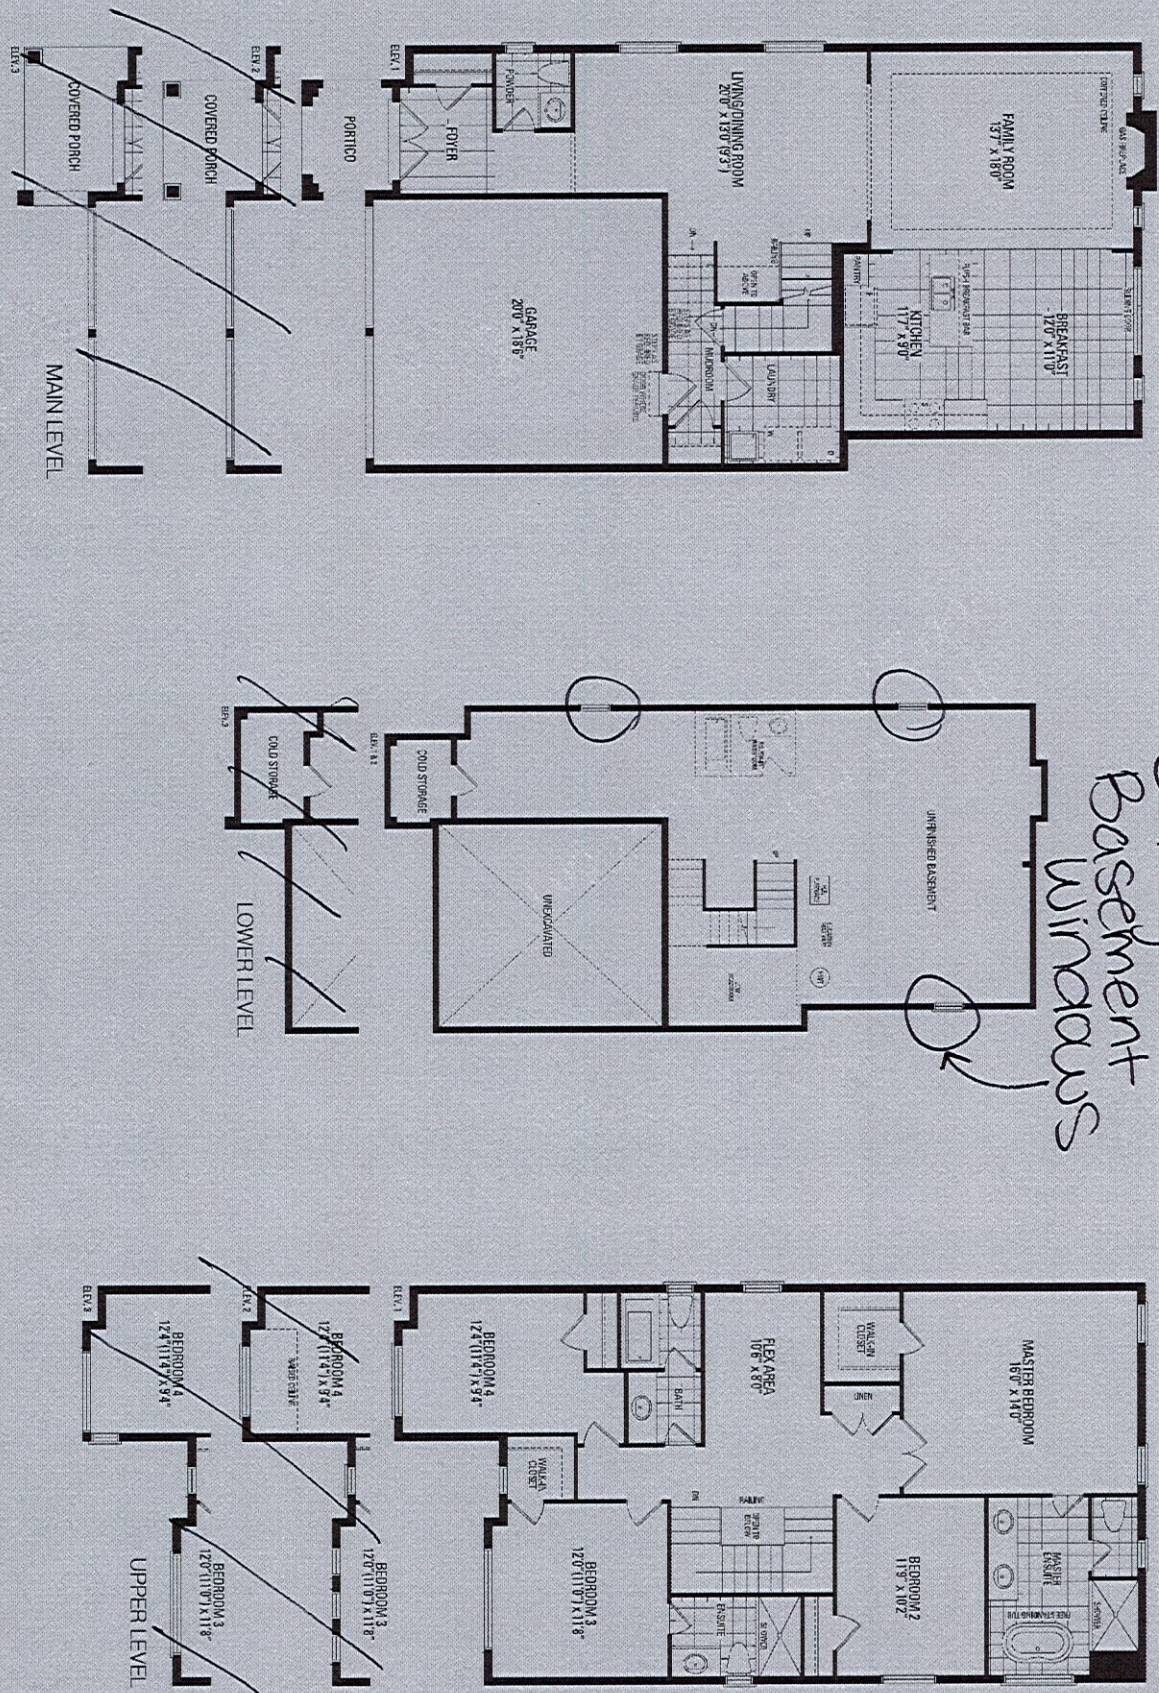

Orientation of home may be reversed and purchaser agrees to accept the same. Steps and porches may vary at any exterior entrance ways due to grading variance. Actual usable floor space may vary from the stated floor areas. All renderings are artist's concept. Dimensions, specifications and architectural detailing subject to modifications. Roofline and adjoining model types may vary due to siting. E. & O. E. May 2023