

CONSTRUCTION SUMMARY

RECEIVED

Palmetto - Zadorra Estates Corp.

JUL 13 2023

PURCHASERS: Mohamed Hashim ABDUL KADER and Shereefa THANATHPARAMBIL ABDUL KHADER TEL: RES.: 416-706-9176

LOT / PHASE 164 / 1	REG. PLAN #	HOUSE TYPE Villa 5 Elev 3		
------------------------	-------------	------------------------------	--	--

CONSTRUCTION

3 - ENLARGED BASEMENT WINDOWS (MAY REQUIRE WINDOW WELLS) - WINDOW IS 30 INCHES X 24 INCHES 11Jul23 Note:	
---	--


PROMOTIONAL

1 - PARTIAL REDEMPTION OF PROMOTIONAL PACKAGE \$1,950.00 BALANCE FORWARD \$13,050.00 TO BE USED AT A LATER DATE. ORIGINAL PROMOTIONAL PACKAGE OF \$15,000.00 AS PER SCHEDULE PE. 11Jul23 Note:	
---	--



This Document is Extremely Time Sensitive - Printed 11 Jul 23 at 10:04

Villa 5 36' LOT

ELEVATION 1 2,881 sq.ft. • ELEVATION 2 2,870 sq.ft. • ELEVATION 3 2,873 sq.ft.
INCLUDES 19 SQ.FT. OF OPEN AREA

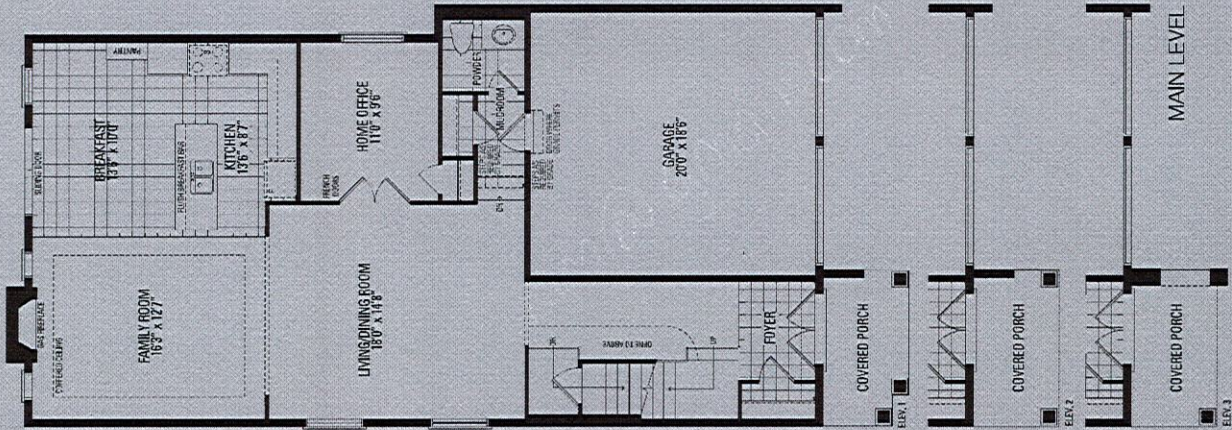

Enlarged
Basement
windows

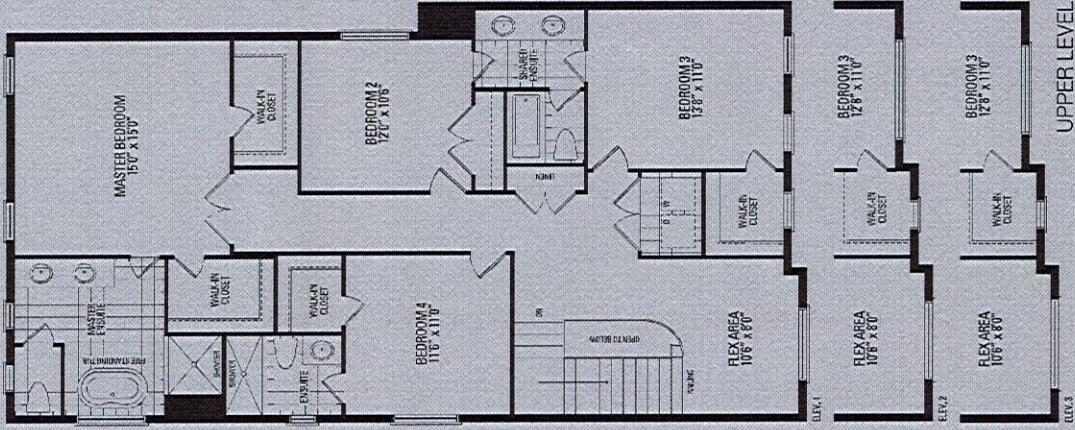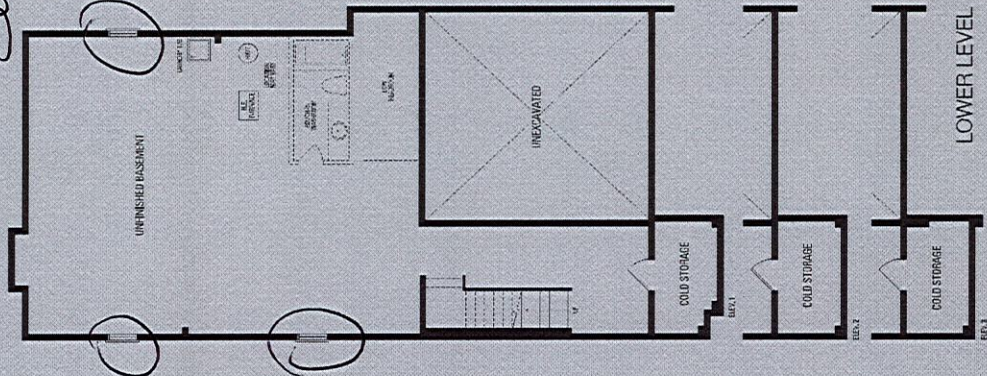

Lot 164
Zadora