

CONSTRUCTION SUMMARY

Palmetto - Zadorra Estates Corp.

RECEIVED

PURCHASERS: Geetchandra RAJKUMAR and Sunitarani THOKCHOM

JUL 13 2023 TEL: RES.: 647-838-6980

LOT / PHASE 27 / 1	REG. PLAN #	HOUSE TYPE Villa 1 Elev 2		
-----------------------	-------------	------------------------------	--	--

CONSTRUCTION

3 - ENLARGED BASEMENT WINDOWS (MAY REQUIRE WINDOW WELLS) - WINDOW IS 30 INCHES X 24 INCHES 12Jul23 Note:	
---	--




PROMOTIONAL

1 - PARTIAL REDEMPTION OF PROMOTIONAL PACKAGE \$1,950.00. BALANCE FORWARD \$13,050.00 TO BE USED AT A LATER DATE. ORIGINAL PROMOTIONAL PACKAGE OF \$15,000.00 AS PER SCHEDULE PE. 12Jul23 Note:	
--	--

This Document is Extremely Time Sensitive - Printed 13 Jul 23 at 11:40

Villa 1 36' LOT

ELEVATION 1 2,303 sq.ft. • ELEVATION 2 2,303 sq.ft. • ELEVATION 3 2,299 sq.ft.
INCLUDES 19 SQ.FT. OF OPEN AREA

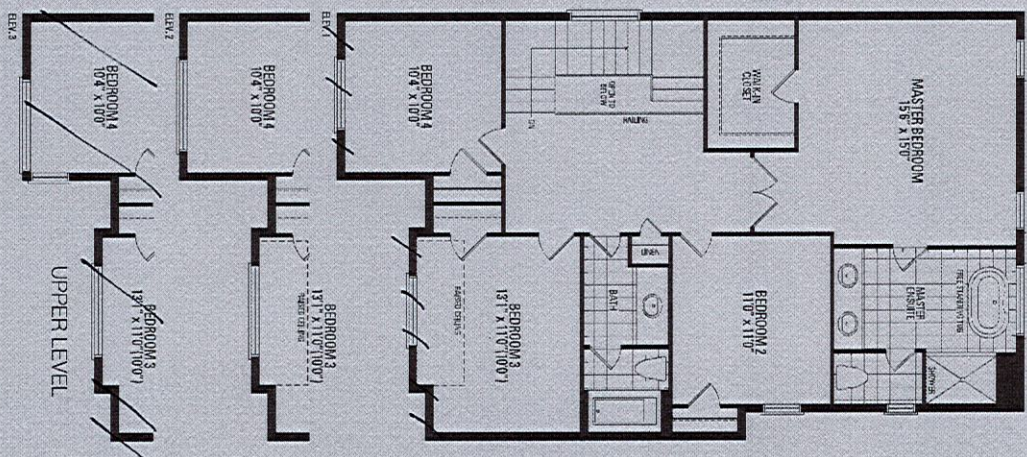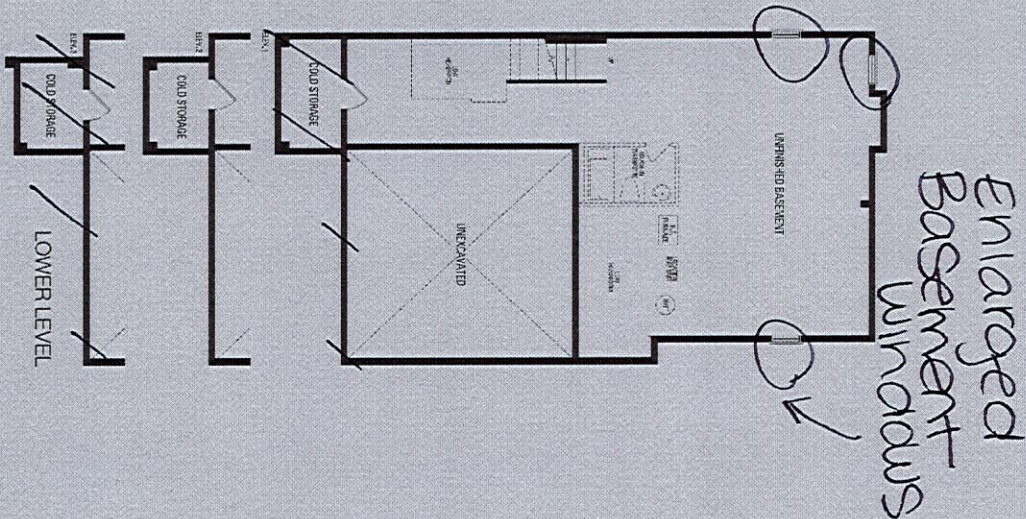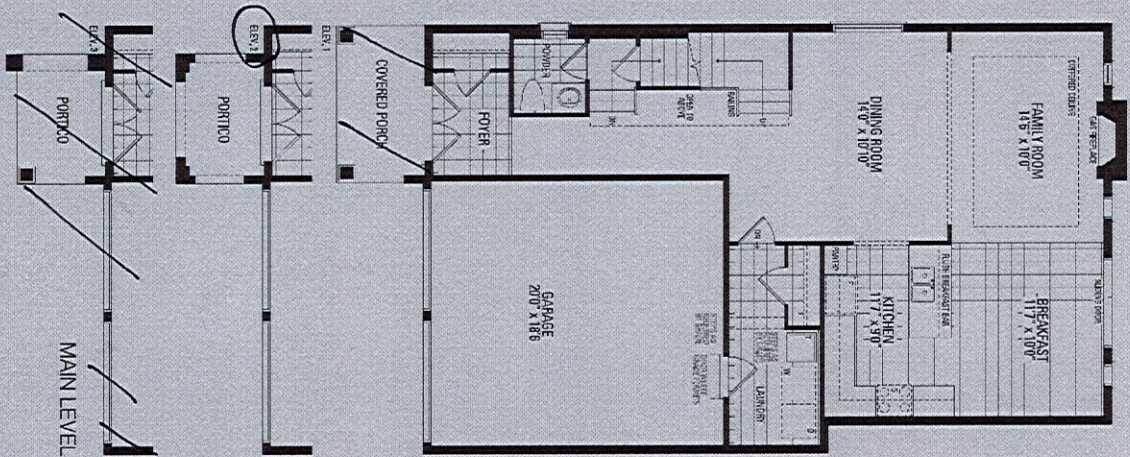

Orientation of home may be reversed and purchaser agrees to accept the same. Steps and porches may vary at any exterior entrance ways due to grading variance. Actual usable floor space may vary from the stated floor areas. All renderings are artist's concept. Dimensions, specifications and architectural detailing subject to modifications. Roofline and adjoining model types may vary due to siting. E. & O. E. May 2023