

PRELIMINARY

CONSTRUCTION SUMMARY

Palmetto - Zadorra Estates Corp.

PURCHASER: Nirojini JEYAKRISHNA

TEL: RES.: 519-551-4221

| | | | | |
|-----------------------|-------------|------------------------------|--|--|
| LOT / PHASE 39 / 1 | REG. PLAN # | HOUSE TYPE Rose 12 Elev 2 | | |
|-----------------------|-------------|------------------------------|--|--|

CONSTRUCTION

| | |
|---|--|
| 4 - ENLARGED BASEMENT WINDOWS (MAY REQUIRE WINDOW WELLS) - WINDOW IS 30 INCHES X 24 INCHES 14Jul23 Note: | |
|---|--|


PROMOTIONAL

| | |
|--|--|
| 1 - PARTIAL REDEMPTION OF PROMOTIONAL PACKAGE \$2,600.00. BALANCE FORWARD \$12,400.00 TO BE USED AT A LATER DATE. ORIGINAL PROMOTIONAL PACKAGE OF \$15,000.00 AS PER SCHEDULE PE. 14Jul23 Note: | |
|--|--|

This Document is Extremely Time Sensitive - Printed 14 Jul 23 at 14:05

Rose 12 40' LOT

ELEVATION 1 3,162 sq.ft. • ELEVATION 2 3,162 sq.ft. • ELEVATION 3 3,162 sq.ft.

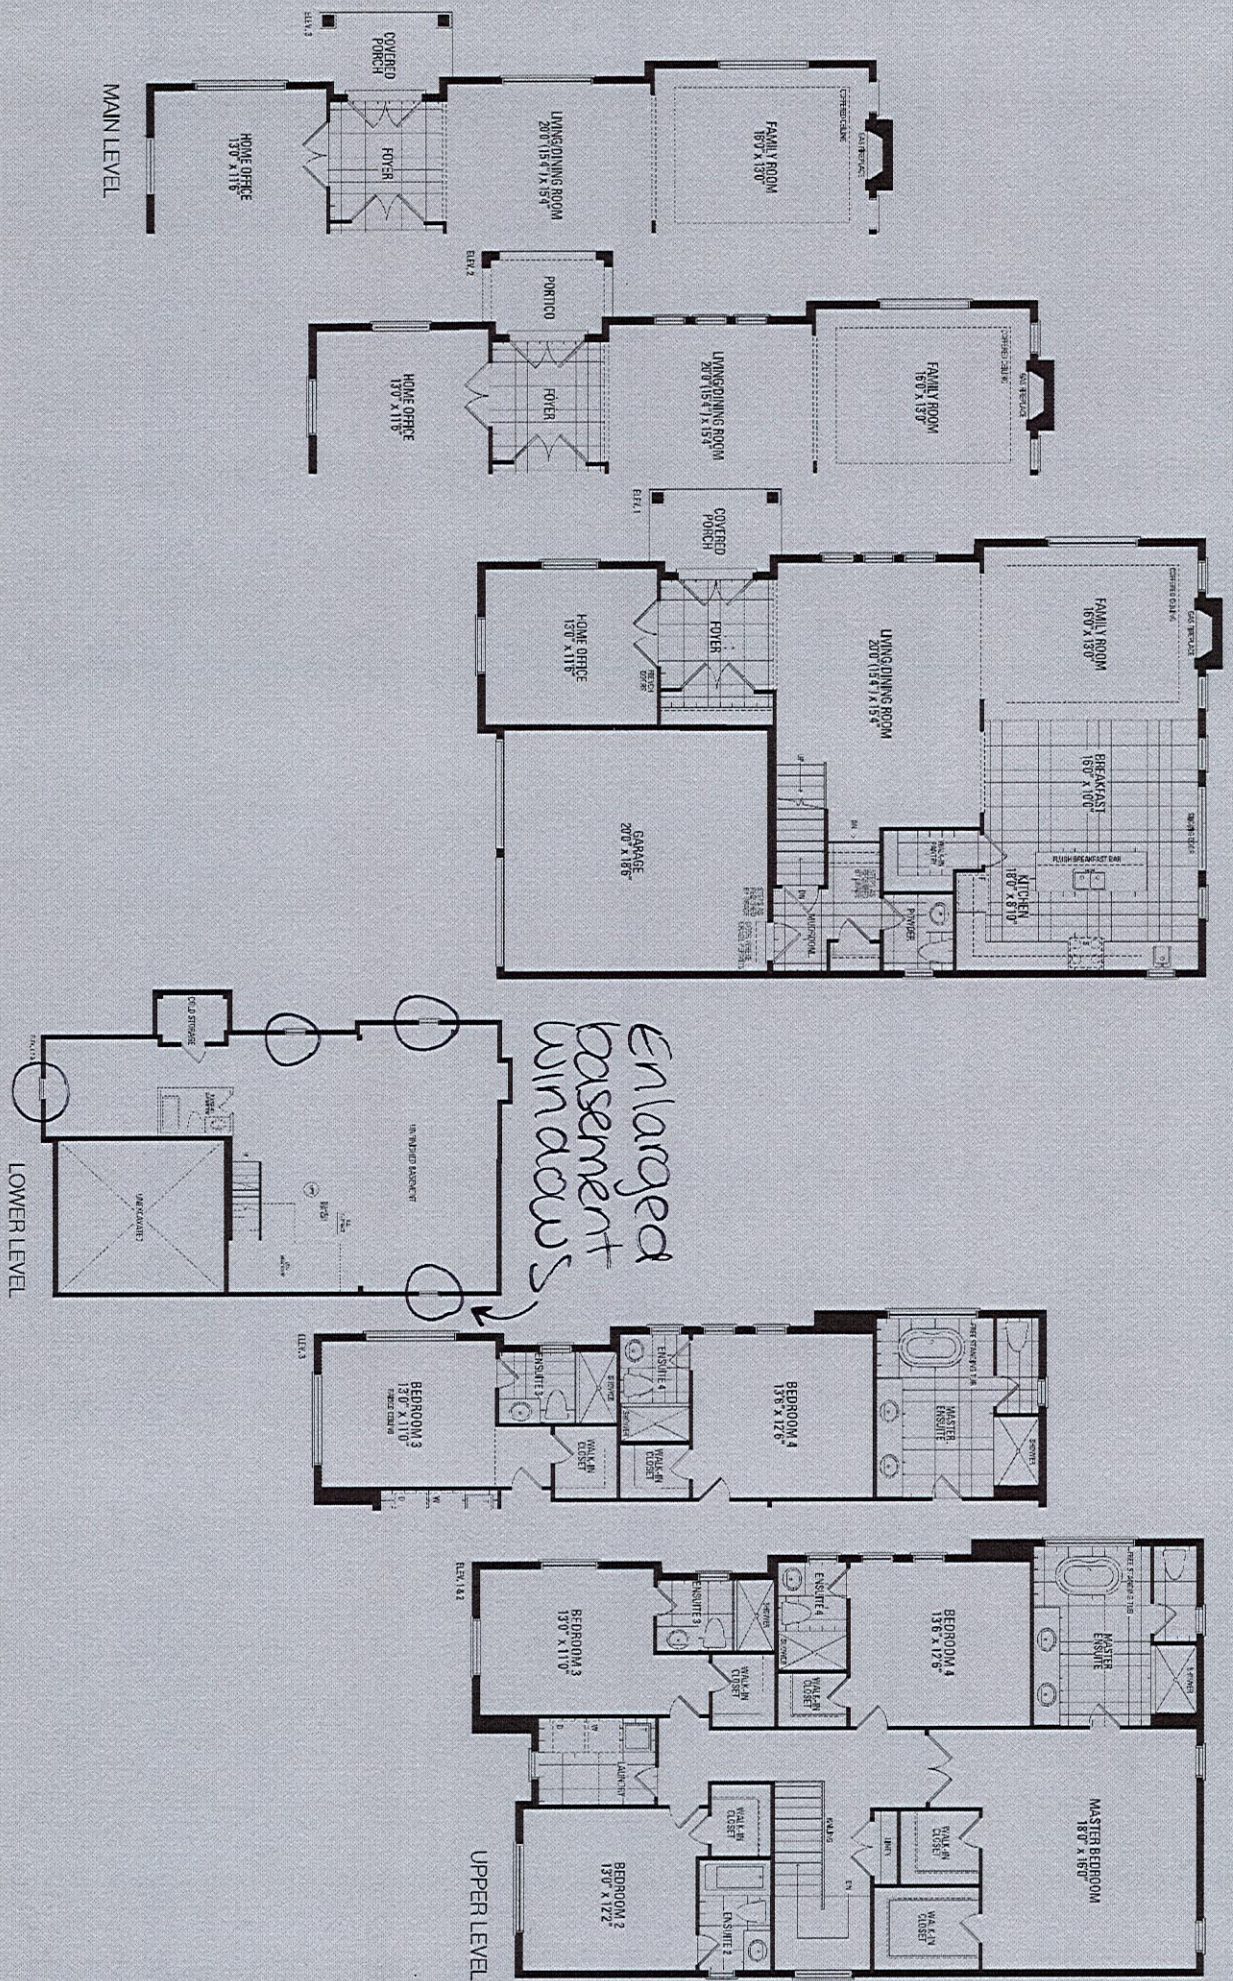

Orientation of home may be reversed and purchaser agrees to accept the same. Steps and porches may vary at any exterior entrance ways due to grading variance. Actual usable floor space may vary from the stated floor areas. All renderings are artist's concept. Dimensions, specifications and architectural detailing subject to modifications. Roofline and adjoining model types may vary due to siting. E. & O. E. May 2023