

PRELIMINARY

CONSTRUCTION SUMMARY RECEIVED

Palmetto - Zadorra Estates Corp.

PURCHASER: Ravishankar MURUGANANTHAM

JUL 24 2023 TEL: RES.: 647-465-5604

LOT / PHASE 22 / 1	REG. PLAN #	HOUSE TYPE Villa 2 Elev 1		
-----------------------	-------------	------------------------------	--	--

CONSTRUCTION

1 - LOWER LEVEL - BASEMENT 8 FOOT 6 INCH CONCRETE POUR - MEASURED FROM TOP OF FOOTING TO TOP OF FOUNDATION WALL 24Jul23 Note:	
1 - FIRST FLOOR INCREASE CEILING HEIGHT FROM 9 FEET TO 10 FEET 24Jul23 Note:	
3 - ENLARGED BASEMENT WINDOWS (MAY REQUIRE WINDOW WELLS) - WINDOW IS 30 INCHES X 24 INCHES 24Jul23 Note:	


PROMOTIONAL

1 - LESS BALANCE OF CREDIT FROM PURCHASER EXTRA SHEET IN OFFER 24Jul23 Note:	
---	--

This Document is Extremely Time Sensitive - Printed 24 Jul 23 at 13:05

Villa 2 36' LOT

ELEVATION 1 2,527 sq.ft. • ELEVATION 2 2,527 sq.ft. • ELEVATION 3 2,523 sq.ft.
INCLUDES 10 SQ.FT. OF OPEN AREA

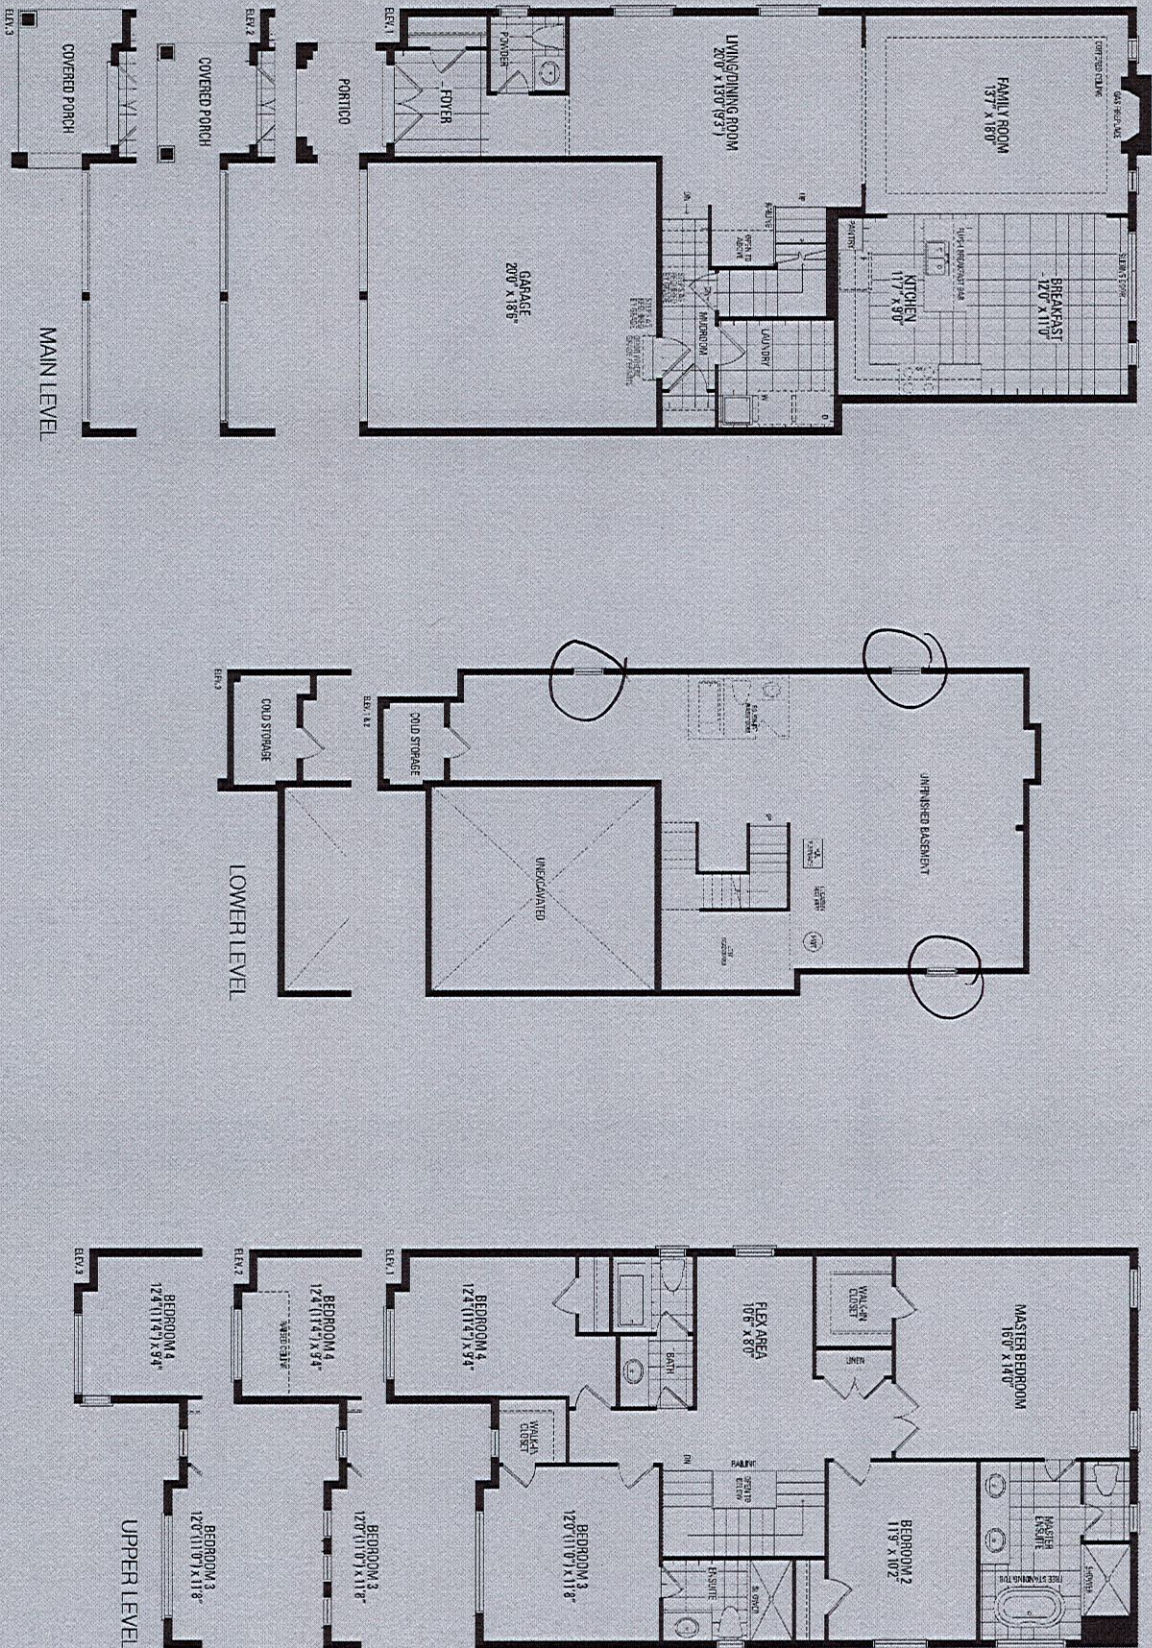

Orientation of home may be reversed and purchaser agrees to accept the same. Steps and porches may vary at any exterior entrance ways due to grading variance. Actual usable floor space may vary from the stated floor areas. All renderings are artist's concept. Dimensions, specifications and architectural detailing subject to modifications. Roofline and adjoining model types may vary due to siting. E. & O. E. May 2023