

CONSTRUCTION SUMMARY - PARTIAL ONLY
Mountainview Heights 3 (G) - Russell Gardens Building Ltd.

RECEIVED
SEP 7 - 2023


PURCHASER: Aliya ARIZ

TEL:

LOT NUMBER	PHASE	HOUSE TYPE	REG. PLAN #		
568	4	Springfield Three (4 Bed with Guest Suite) Elev 1	62M-1266		

INV#	QTY	EXTRA / CHANGE	COMMENTS
------	-----	----------------	----------

NEW ELECTRICAL

29,165 06Sep23	1 - FOR CONFIRMATION PURPOSES - MASTER ENSUITE VANITY LIGHTS TO HAVE 1 LIGHT OVER EACH SINK AS PER SKETCH Note: 
25,632 17Jun21	1 - 200 AMP ELECTRICAL SERVICE Note:
27,157 09May22	1 - LIGHT AND SWITCH - NO FIXTURE INCLUDED - LIVING ROOM Note:
27,157 09May22	1 - POT LIGHT - LED - FIRST FLOOR INSTALLATION - INSTALLED ON SEPERATE SWITCH FROM STANDARD LIGHTS - KITCHEN Note:
27,157 09May22	1 - POT LIGHT - LED - FIRST FLOOR INSTALLATION - INSTALLED ON SEPERATE SWITCH FROM STANDARD LIGHTS - FAMILY ROOM Note:
27,157 09May22	1 - POT LIGHT - LED - FIRST FLOOR INSTALLATION - INSTALLED ON SEPERATE SWITCH FROM STANDARD LIGHTS - LIVING/DINING ROOM Note:
27,157 09May22	1 - POT LIGHT - LED - FIRST FLOOR INSTALLATION - INSTALLED ON SEPERATE SWITCH FROM STANDARD LIGHTS - LIBRARY Note:
27,157 09May22	1 - PLUG - ELECTRICAL PLUG - TO BE INSTALLED OVER FIREPLACE Note:
27,157 09May22	3 - ABOVE KITCHEN ISLAND - ADD LIGHT AND SWITCH - NO FIXTURE INCLUDED Note:
25,632 17Jun21	1 - PLUG - ELECTRICAL PLUG WITH GFI AND SWITCH - FOR FESTIVE LIGHTING Note:
27,157 09May22	1 - FRONT PORCH - RELOCATE STANDARD LIGHT TO SOFFIT - SEE SKETCH - IF CONSTRUCTION PERMITS Note:
27,157 09May22	1 - LIGHT - EXTERIOR WITH INTERIOR SWITCH - RIGHT SIDE ELEVATION - SEE SKETCH Note:
27,157 09May22	1 - LIGHT - EXTERIOR WITH INTERIOR SWITCH - LEFT SIDE ELEVATION - SEE SKETCH Note:
27,157 09May22	2 - PLUG - ELECTRICAL PLUG - INSTALLED 5' FROM FLOOR - FLEX ROOM & MASTER BEDROOM Note:
27,157 09May22	1 - BUILT IN OVEN AND COOKTOP PROVISION - PROVISION ONLY - ELECTRICAL ONLY Note:

CONSTRUCTION SUMMARY - PARTIAL ONLY

Mountainview Heights 3 (G) - Russell Gardens Building Ltd.

PURCHASER: Aliya ARIZ

TEL:


LOT NUMBER	PHASE	HOUSE TYPE	REG. PLAN #		
568	4	Springfield Three (4 Bed with Guest Suite) Elev 1	62M-1266		


INV#	QTY	EXTRA / CHANGE	EXTENSION
------	-----	----------------	-----------

ELECTRICAL

27,104 22Jun22	7 - POT LIGHT - LED - FIRST FLOOR INSTALLATION - INSTALLED ON A SERPERATE SWITCH FROM STANDARD LIGHT - 2 SWITCHES - SEE SKETCH - FOYER Note: INCLUDES FOYER HALL
27,104 22Jun22	4 - POT LIGHT - LED - FIRST FLOOR INSTALLATION - LIVING/DINING ROOM HALL Note:
27,104 22Jun22	4 - POT LIGHT - LED - FIRST FLOOR INSTALLATION - - INSTALLED ON A SERPERATE SWITCH FROM STANDARD LIGHT - LIVING ROOM Note:
27,104 22Jun22	3 - POT LIGHT - LED - FIRST FLOOR INSTALLATION - INSTALLED ON A SERPERATE SWITCH FROM STANDARD LIGHT - DINING ROOM Note:ADD 3 TO MAKE 4 POTLIGHTS IN TOTAL SEE SKETCH FOR POT LIGHT LOCATIONS (4 POTLIGHTS IN TOTAL TO BE INSTALLED)
27,104 22Jun22	4 - POT LIGHT - LED - FIRST FLOOR INSTALLATION - INSTALLED ON A SERPERATE SWITCH FROM STANDARD LIGHT - GUEST SUITE Note:
27,104 22Jun22	5 - POT LIGHT - LED - FIRST FLOOR INSTALLATION - INSTALLED ON A SERPERATE SWITCH FROM STANDARD LIGHT - FAMILY ROOM Note:ADD 5 TO MAKE 6 IN TOTAL SEE SKETCH FOR APPROXIMATE LOCATION (6 POTLIGHTS IN TOTAL)
27,104 22Jun22	4 - POT LIGHT - LED - FIRST FLOOR INSTALLATION - INSTALLED ON A SERPERATE SWITCH FROM STANDARD LIGHT - KITCHEN BREAKFAST Note:
27,104 22Jun22	4 - POT LIGHT - LED - FIRST FLOOR INSTALLATION - INSTALLED ON A SERPERATE SWITCH FROM STANDARD LIGHT - KITCHEN WORKSPACE Note:ADD 4 TO MAKE 5 IN TOTAL SEE SKETCH FOR POTLIGHT LOCATIONS (5 POTLIGHTS IN TOTAL)
27,104 22Jun22	1 - KITCHEN - VALANCE LIGHTING - LED LIGHTING Note:
27,104 22Jun22	1 - KITCHEN - DELETE STANDARD LIGHT TO ACCOMMODATE POTLIGHTS Note:
27,104 22Jun22	1 - FOYER HALL & LIVING/DINING ROOM HALL - DELETE STANDARD LIGHTS TO ACCOMMODATE POTLIGHTS Note:
27,104 22Jun22	1 - ***DELETE POT LIGHT - LED - FIRST FLOOR INSTALLATION - LIBRARY Note:

MIRRORS AND GLASS

29,165 06Sep23	1 - FOR CONFIRMATION PURPOSES- MASTER ENSUITE MIRROR TO BE INSTALLED AS PER SKETCH- 3 PIECE Note: NEW 
25,632 17Jun21	1 - GUEST ENSUITE – FRAMELESS GLASS SHOWER ENCLOSURE – INCLUDES CHROME KNOB AND HINGES NoteFOR GUEST SUITE
25,632 17Jun21	1 - MASTER ENSUITE – FRAMELESS GLASS SHOWER ENCLOSURE – INCLUDES CHROME KNOB AND HINGES Note:

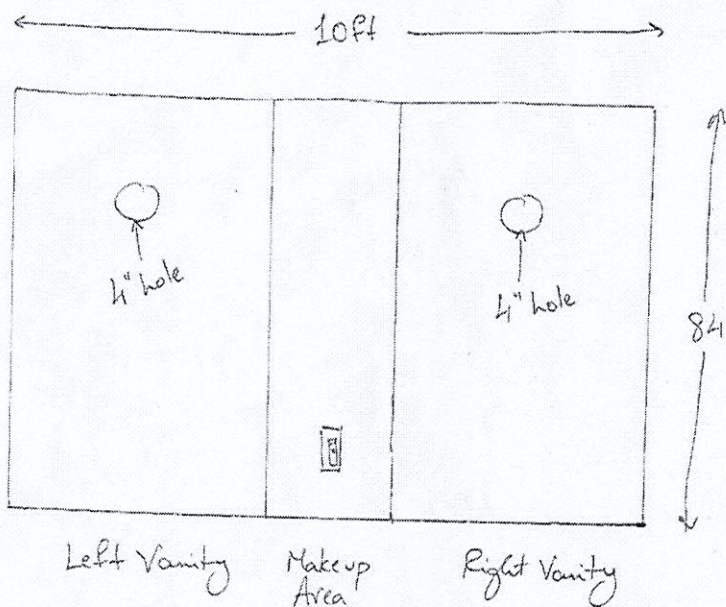

Master Ensuite Bathroom
- 3 Piece mirror.

Design
55 Sep 2023

