



CONSTRUCTION SUMMARY

Palmetto - Zadorra Estates Corp.

PURCHASERS: Nithin Kumar Reddy KONDRU and Thejaswi CHAVANA

TEL:

LOT / PHASE 18 / 1	REG. PLAN #	HOUSE TYPE Villa 3 Elev 3		
-----------------------	-------------	------------------------------	--	--

CONSTRUCTION

3 - ENLARGED BASEMENT WINDOWS (MAY REQUIRE WINDOW WELLS) - WINDOW IS 30 INCHES X 24 INCHES 20Jun23 Note:	
---	--

PLUMBING

1 - WATER LINE FOR FRIDGE - ROUGH-IN ONLY 20Sep23 Note:	
--	--

PROMOTIONAL

1 - PARTIAL REDEMPTION OF PROMOTIONAL PACKAGE \$395.00. BALANCE FORWARD \$12,655.00 TO BE USED AT A LATER DATE. ORIGINAL PROMOTIONAL PACKAGE OF \$15,000.00 AS PER SCHEDULE PE. 20Sep23 Note:	
1 - PARTIAL REDEMPTION OF PROMOTIONAL PACKAGE \$1,950.00. BALANCE FORWARD \$13,050.00 TO BE USED AT A LATER DATE. ORIGINAL PROMOTIONAL PACKAGE OF \$15,000.00 AS PER SCHEDULE PE. 20Jun23 Note:	

EXTRAS AS PER OFFER

The Vendor agrees that notwithstanding any other term or provision in this Agreement included in the Purchase Price and in addition to those items detailed in Schedule GP to the Agreement of Purchase and Sale, the Purchaser is entitled to a credit of Fif Worksheet Note:	
---	--



This Document is Extremely Time Sensitive - Printed 27 Sep 23 at 10:54

LOT #18

Villa 3 36' LOT

ELEVATION 1 2,662 sq.ft. • ELEVATION 2 2,662 sq.ft. • ELEVATION 3 2,647 sq.ft.

INCLUDES 15 SQ.FT. OF OPEN AREA

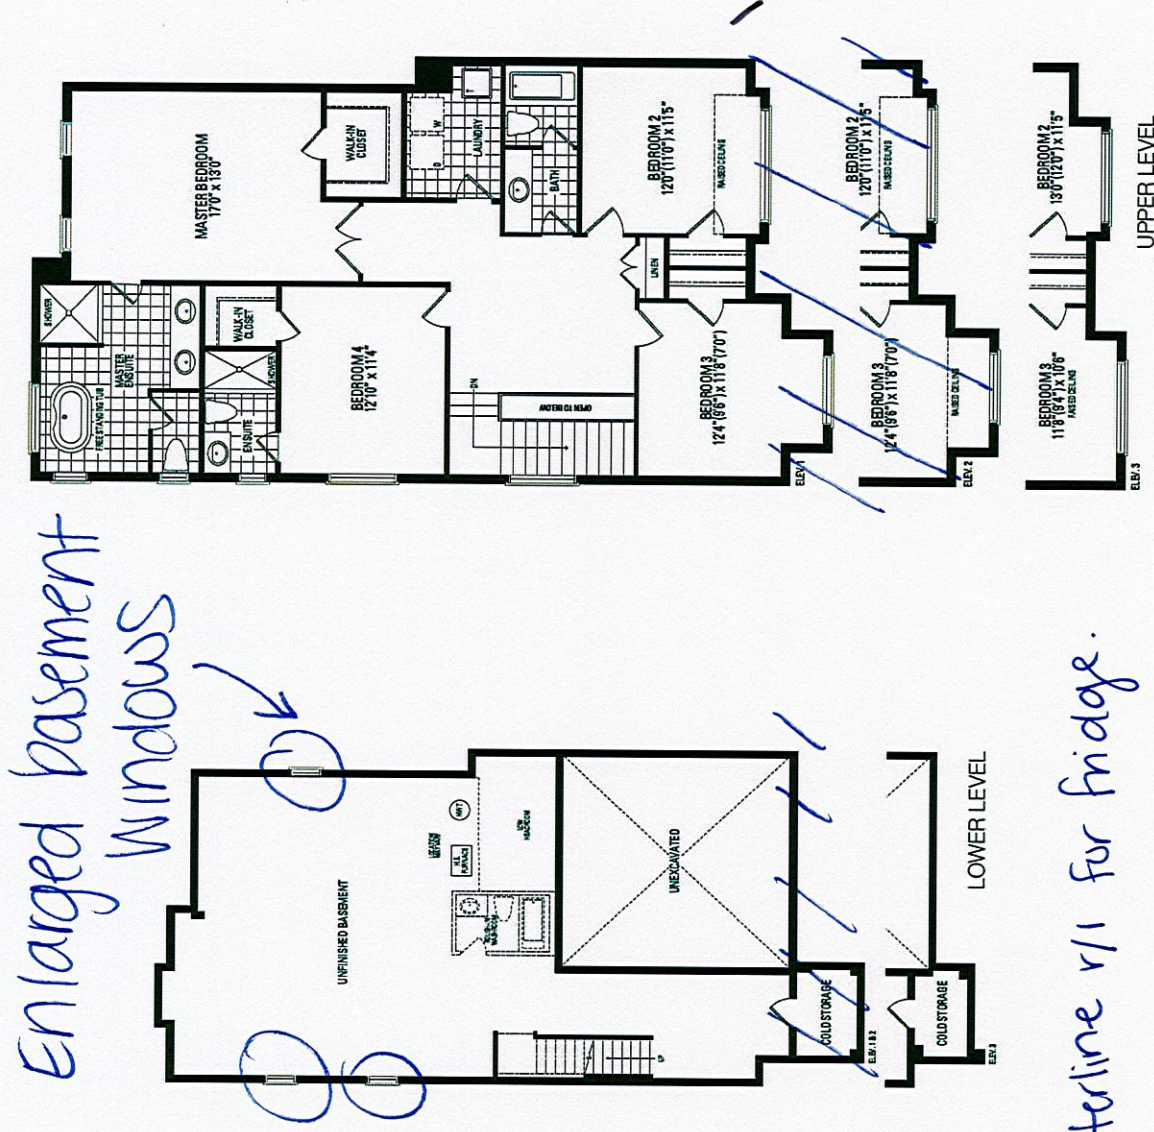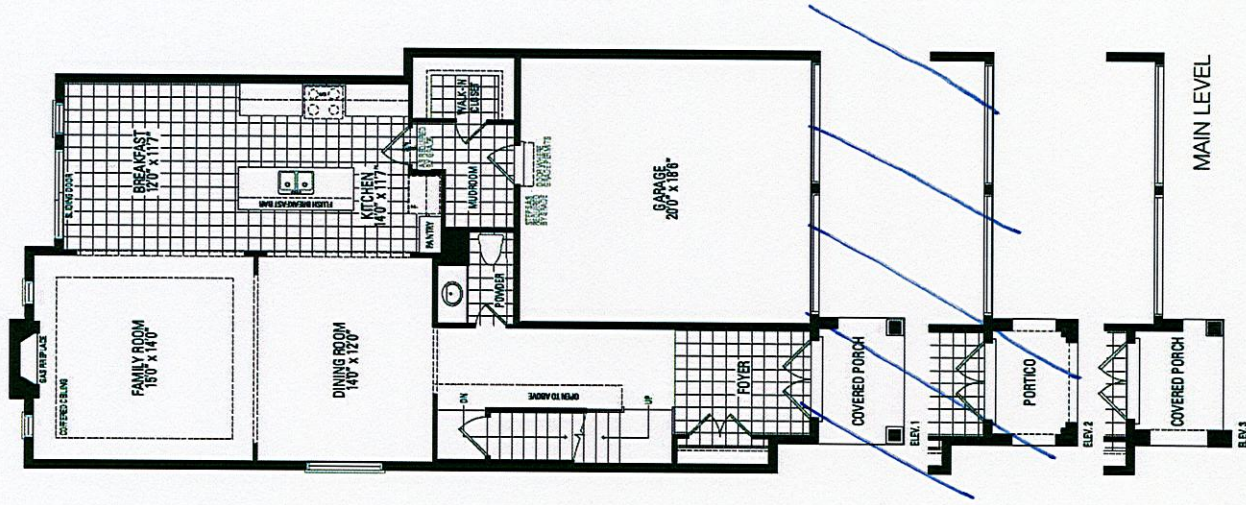

Enlarged basement
Windows

*Waterline v/i for fridge.