

CONSTRUCTION SUMMARY				
Palmetto - Zadorra Estates Corp.				
PURCHASERS: Sefiu Olalekan YEKINI and Opeyemi Monsurat YEKINI			TEL: RES.: 647-869-5031	
LOT / PHASE	REG. PLAN #	HOUSE TYPE		
25 / 1		River 1 Elev 1		

CONSTRUCTION

2 - ENLARGED BASEMENT WINDOWS (MAY REQUIRE WINDOW WELLS) - WINDOW IS 30 INCHES X 24 INCHES	
02Oct23 Note:	

PROMOTIONAL

1 - PARTIAL REDEMPTION OF PROMOTIONAL PACKAGE \$1,300.00. BALANCE FORWARD \$23,700.00 TO BE USED AT A LATER DATE. ORIGINAL PROMOTIONAL PACKAGE OF \$25,000.00 AS PER SCHEDULE PE.	
02Oct23 Note:	


This Document is Extremely Time Sensitive - Printed 3 Oct 23 at 14:33

LOT#25

River 1 30' LOT

ELEVATION 1 2,190 sq.ft. • ELEVATION 2 2,190 sq.ft. • ELEVATION 3 2,194 sq.ft.
INCLUDES 18 SQ.FT. OF OPEN AREA

enlarge basement windows

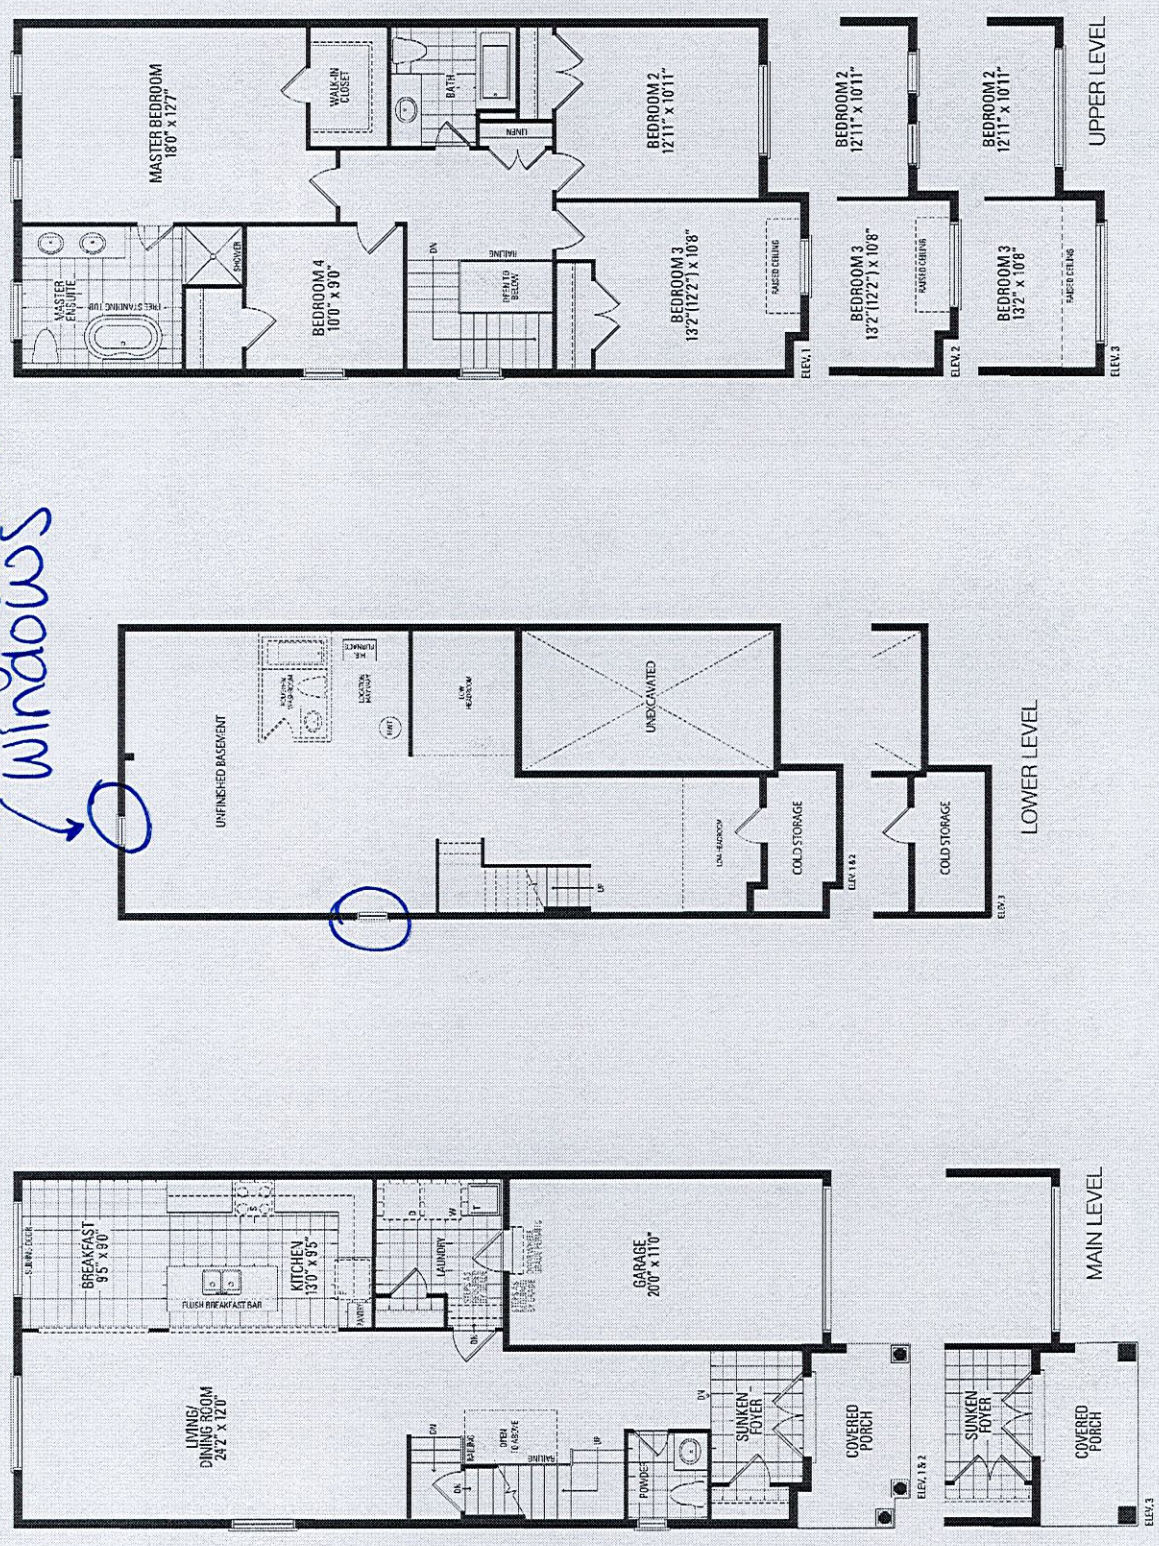

Orientation of home may be reversed and purchaser agrees to accept the same. Steps and porches may vary at any exterior entrance ways due to grading variance. Actual usable floor space may vary from the stated floor areas. All renderings are artist's concept. Dimensions, specifications and architectural detailing subject to modifications. Roofline and adjoining model types may vary due to siting. E. & O. E. May 2023