

CONSTRUCTION SUMMARY					RECEIVED
Legacy Hill - Trinigroup Development Inc.					OCT 11 2023
PURCHASER: NAN WEN					TEL:
LOT / PHASE	REG. PLAN #	HOUSE TYPE			
3 / 1		Villa 2 Elev 3			

CONSTRUCTION

3 - ENLARGED BASEMENT WINDOWS (MAY REQUIRE WINDOW WELLS) - WINDOW IS 30 INCHES X 24 INCHES 10Oct23    Note:	
1 - LOWER LEVEL - BASEMENT 8 FOOT 6 INCH CONCRETE POUR - MEASURED FROM TOP OF FOOTING TO TOP OF FOUNDATION WALL 10Oct23    Note:	
1 - FIRST FLOOR INCREASE CEILING HEIGHT FROM 9 FEET TO 10 FEET 10Oct23    Note:	

PROMOTIONAL

1 - LESS CREDIT FROM PURCHASER EXTRA SHEET IN OFFER 10Oct23    Note:	
---	--

EXTRAS AS PER OFFER

The Vendor agrees that notwithstanding any other term or provision in this Agreement included in the Purchase Price and in addition to those items detailed in Schedule GP to the Agreement of Purchase and Sale, the Purchaser is entitled to a credit of Ten Worksheet    Note:	
Complete Central Air Conditioning Worksheet    Note:	

This Document is Extremely Time Sensitive - Printed 10 Oct 23 at 14:48






# Villa 2 36' Lot

Elev. 1: 2,527 sq.ft. Elev. 2: 2,527 sq.ft. Elev. 3: 2,523 sq.ft.  
Includes 10 sq.ft. of Open Area

EH

Lot 3 Trini

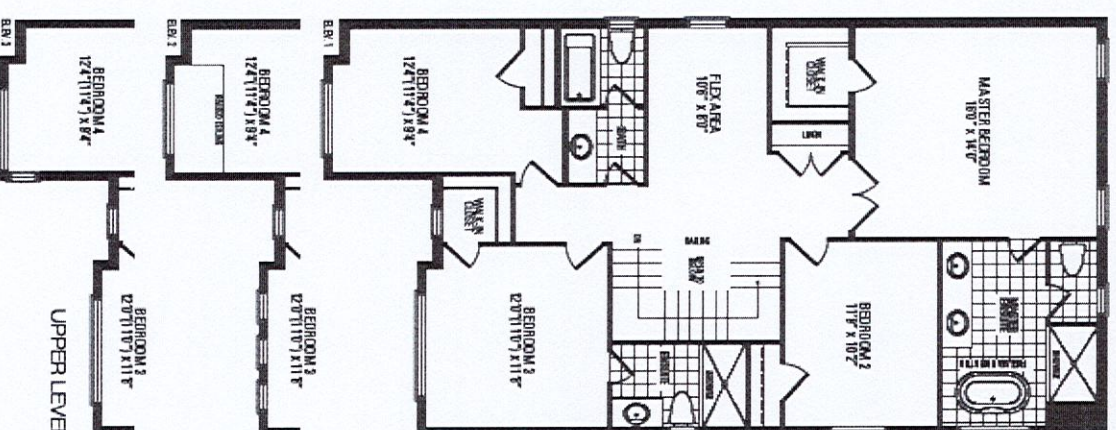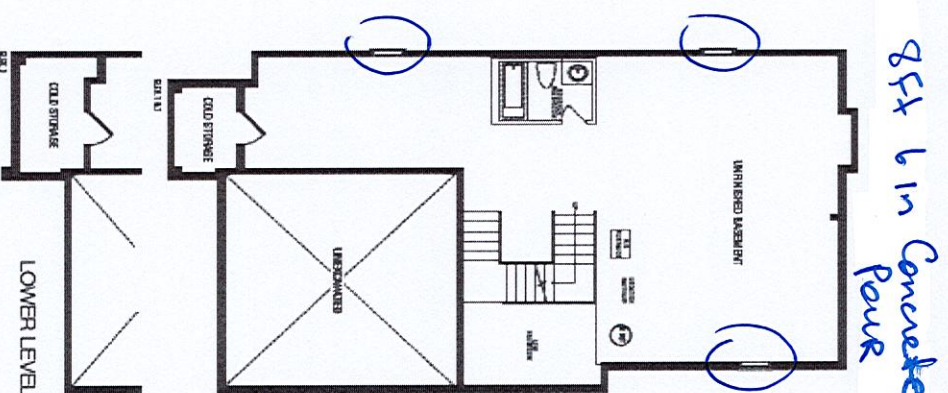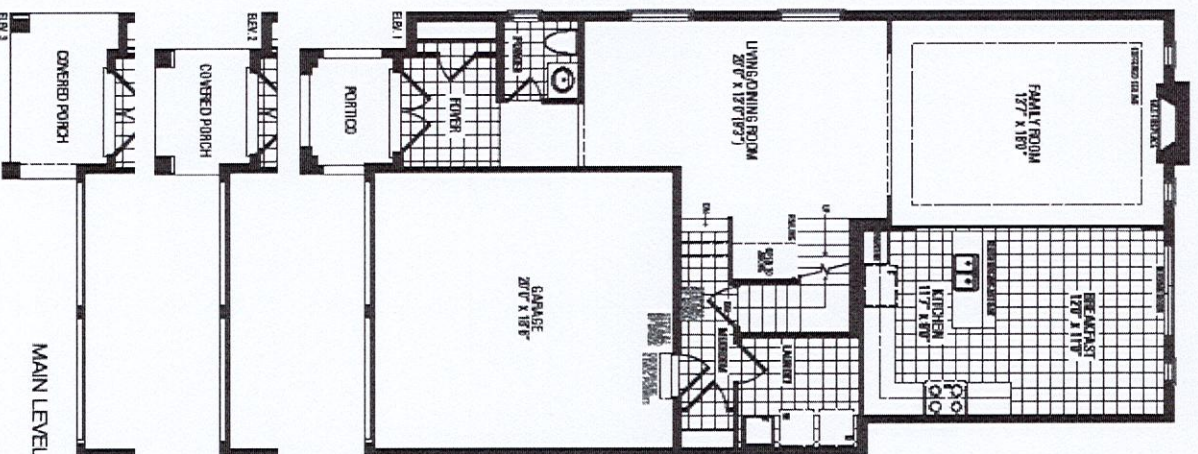

Orientation of home may be reversed and purchaser agrees to accept the same. Steps and porches may vary at any exterior entrance ways due to grading variance. Actual usable floor space may vary from the stated floor areas. All renderings are artist's concept. Dimensions, specifications and architectural detailing subject to modifications. Roofline and adjoining model types may vary due to siting. E. & O. E. September 2023