

|  |  |             |  |                           |  |      |
|--|--|-------------|--|---------------------------|--|------|
| <div>CONSTRUCTION SUMMARY</div> <div>Legacy Hill - Trinigroup Development Inc.</div> |  |             |  |                           | <div>RECEIVED</div> <div>OCT 18 2023</div> | TEL: |
| PURCHASER: Jin Hua ZHAO  |  |             |  |                           |  |      |
| LOT / PHASE  |  | REG. PLAN # |  | HOUSE TYPE                |  |      |
| 104 / 1  |  |             |  | Rose 6 Elev 2 (4 Bedroom) |  |      |

CONSTRUCTION

|  |  |
|--|--|
| 2 - ENLARGED BASEMENT WINDOWS (MAY REQUIRE WINDOW WELLS) - WINDOW IS 30 INCHES X 24 INCHES |  |
| 17Oct23    Note:   |  |

PROMOTIONAL

|  |  |
|--|--|
| 1 - PARTIAL REDEMPTION OF PROMOTIONAL PACKAGE \$1,300.00. BALANCE FORWARD \$8,700.00 TO BE USED AT A LATER DATE. ORIGINAL PROMOTIONAL PACKAGE OF \$10,000.00 AS PER SCHEDULE PE. |  |
| 17Oct23    Note:   |  |

EXTRAS AS PER OFFER

|  |  |
|--|--|
| The Vendor agrees that notwithstanding any other term or provision in this Agreement included in the Purchase Price and in addition to those items detailed in Schedule GP to the Agreement of Purchase and Sale, the Purchaser is entitled to a credit of Ten |  |
| Worksheet    Note:   |  |

This Document is Extremely Time Sensitive - Printed 17 Oct 23 at 11:43


# Rose 6 40' Lot

Elev. 1: 3,215 sq.ft. Elev. 2: 3,197sq.ft. Elev. 3: 3,197 sq.ft.  
Includes 11 sq.ft. of Open Area

EH

LOT #104

Enlarge  
Basement  
Windows

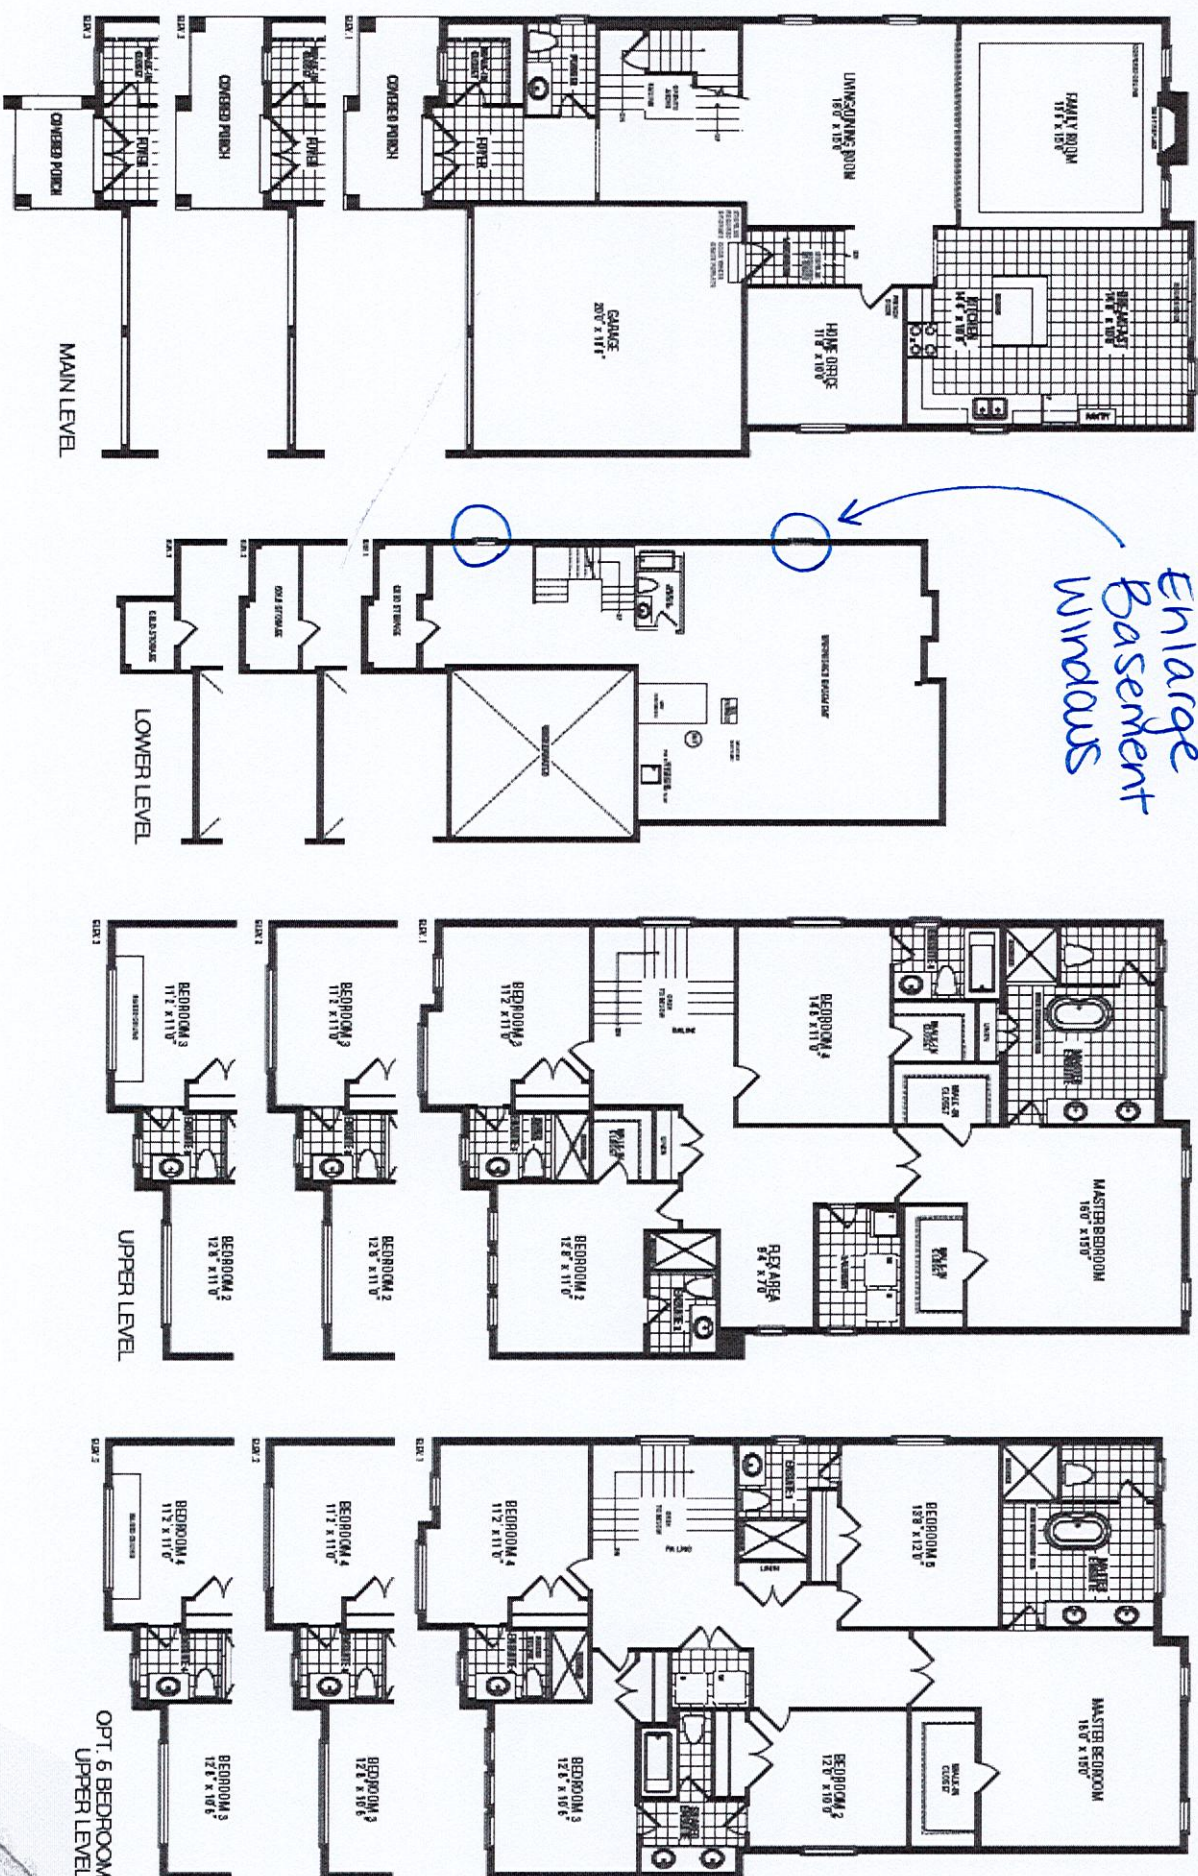

Orientation of home may be reversed and purchaser agrees to accept the same. Steps and porches may vary at any exterior entrance ways due to grading variance. Actual usable floor space may vary from the stated floor areas. All renderings are artist's concept. Dimensions, specifications and architectural detailing subject to modifications. Roofline and adjoining model types may vary due to siting. E. & O. E. September 2023