

CONSTRUCTION SUMMARY Legacy Hill - Trinigroup Development Inc.					RECEIVED OCT 20 2023	TEL:
PURCHASER: Xiao HE						
LOT / PHASE		REG. PLAN #		HOUSE TYPE		
68 / 1				Rose 5 Elev 2 (4 Bedroom)		

CONSTRUCTION

1 - ENLARGED BASEMENT WINDOWS (MAY REQUIRE WINDOW WELLS) - WINDOW IS 30 INCHES X 24 INCHES		
20Oct23 Note:		
1 - FIRST FLOOR INCREASE CEILING HEIGHT FROM 9 FEET TO 10 FEET		
20Oct23 Note:		

PROMOTIONAL

1 - LESS CREDIT FROM PURCHASER EXTRA SHEET IN OFFER		
20Oct23 Note:		

EXTRAS AS PER OFFER

The Vendor agrees that notwithstanding any other term or provision in this Agreement included in the Purchase Price and in addition to those items detailed in Schedule GP to the Agreement of Purchase and Sale, the Purchaser is entitled to a credit of Ten		
Worksheet Note:		

This Document is Extremely Time Sensitive - Printed 20 Oct 23 at 14:10





Rose 5 40' Lot

Elev. 1: 3,357 sq.ft. Elev. 2: 3,337 sq.ft. Elev. 3: 3,339 sq.ft.



Lot 68 TRINIGROUP

1st Floor Ceilings 10'4"

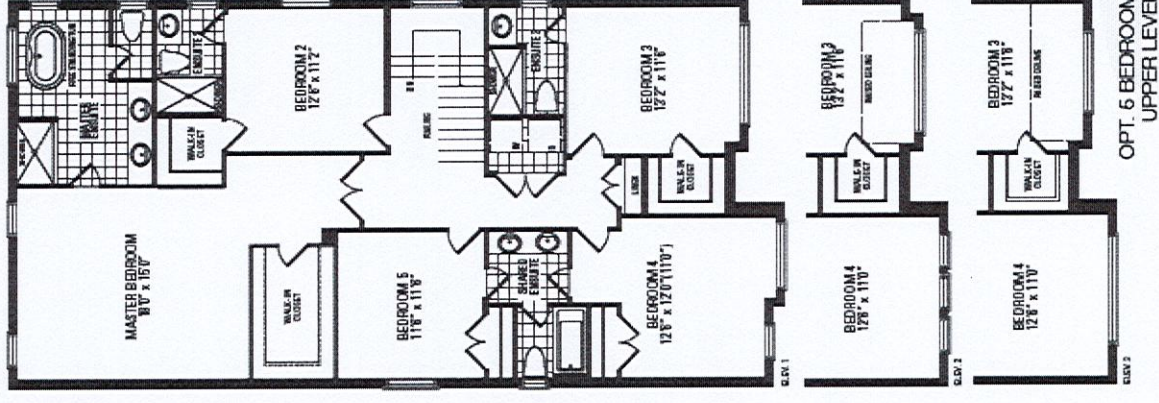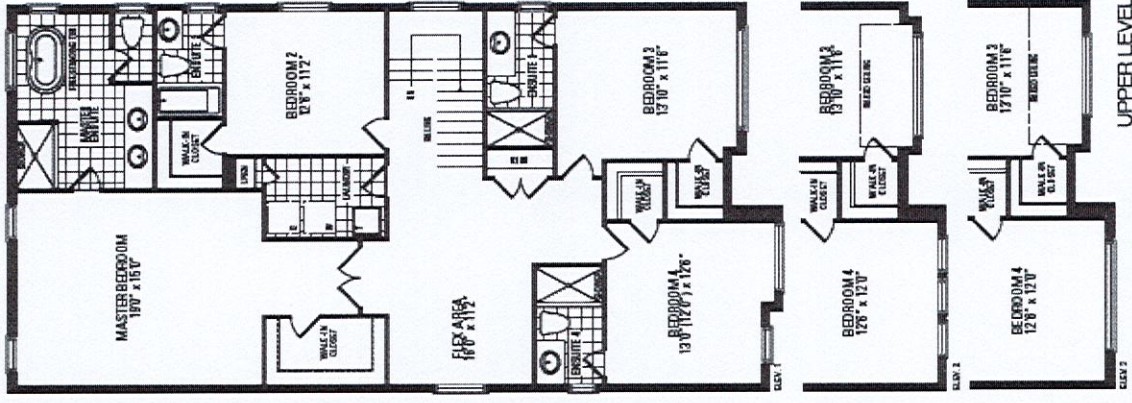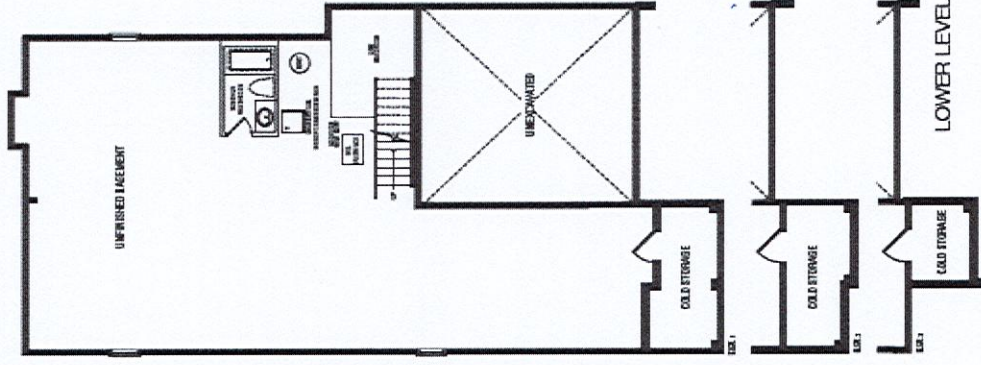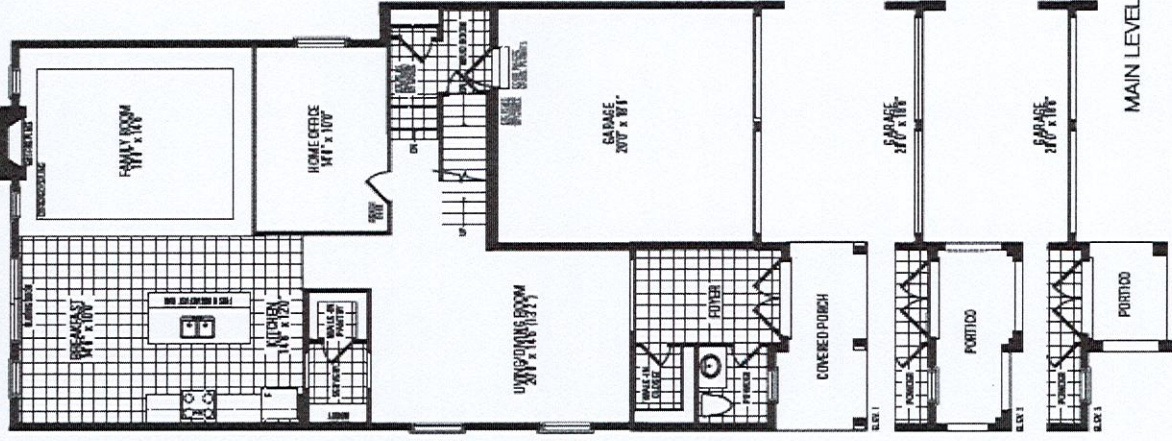

Enlarge Basement Windows

Orientation of home may be reversed and purchaser agrees to accept the same. Steps and porches may vary at any exterior entrance ways due to grading variance. Actual usable floor space may vary from the stated floor areas. All renderings are artist's concept. Dimensions, specifications and architectural detailing subject to modifications. Roofline and adjoining model types may vary due to siting. E. & O. E. September 2023