

<div>CONSTRUCTION SUMMARY</div> <div>Legacy Hill - Trinigroup Development Inc.</div>					<div>RECEIVED</div> <div>OCT 30 2023</div>	TEL:
PURCHASER: Zexuan LI						
LOT / PHASE		REG. PLAN #		HOUSE TYPE		
81 / 1				Villa 6 Elev 1		

CONSTRUCTION

1 - FIRST FLOOR INCREASE CEILING HEIGHT FROM 9 FEET TO 10 FEET	
25Oct23 Note:	

PROMOTIONAL

1 - LESS CREDIT FROM PURCHASER EXTRA SHEET IN OFFER	
25Oct23 Note:	

EXTRAS AS PER OFFER

The Vendor agrees that notwithstanding any other term or provision in this Agreement included in the Purchase Price and in addition to those items detailed in Schedule GP to the Agreement of Purchase and Sale, the Purchaser is entitled to a credit of Ten	
Worksheet Note:	

This Document is Extremely Time Sensitive - Printed 25 Oct 23 at 14:32




Villa 6 36' Lot

Elev. 1: 3.038 sq.ft. Elev. 2: 3.047 sq.ft. Elev. 3: 3.047 sq.ft.



Lot 81 Trinigrap.

* 10ft Ceiling 1st Fl *

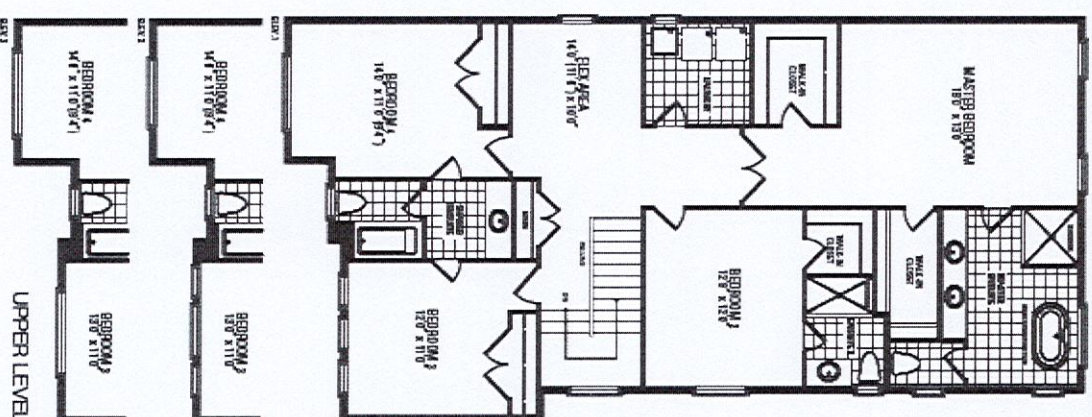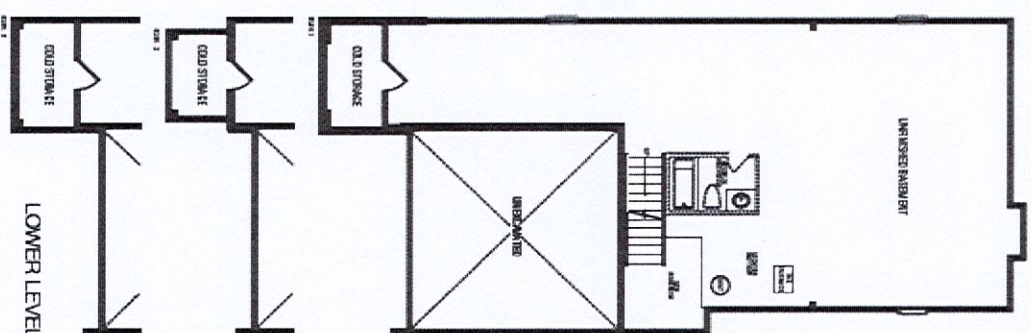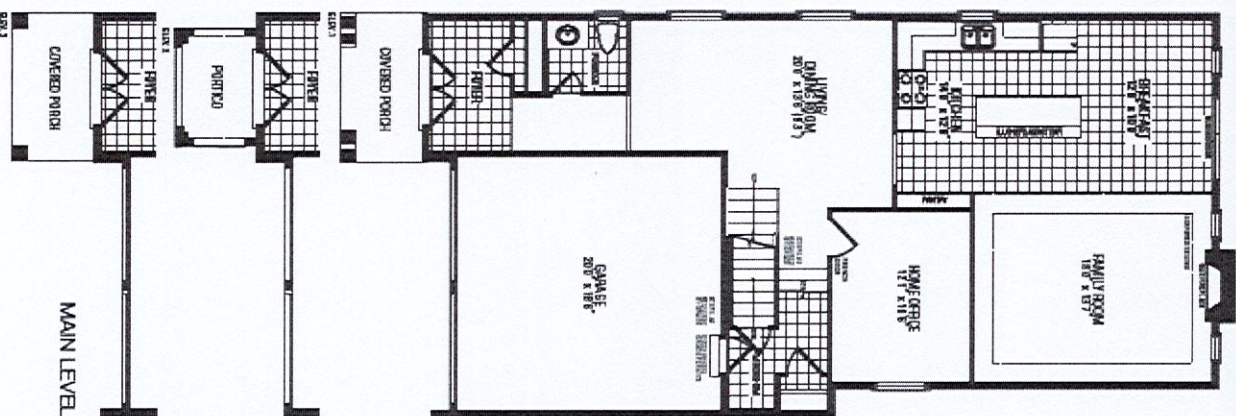

Orientation of home may be reversed and purchaser agrees to accept the same. Steps and porches may vary at any exterior entrance ways due to grading variance. Actual usable floor space may vary from the stated floor areas. All renderings are artist's concept. Dimensions, specifications and architectural detailing subject to modifications. Roofline and adjoining model types may vary due to siting. E. & O. E. September 2023