

PURCHASER: Yin Kwan SZE		CONSTRUCTION SUMMARY Legacy Hill - Trinigroup Development Inc.		RECEIVED OCT 30 2023		TEL:	
-------------------------	--	---	--	-------------------------	--	------	--

LOT / PHASE 20 / 1	REG. PLAN #	HOUSE TYPE Rose 2 Elev 2		
-----------------------	-------------	-----------------------------	--	--

CONSTRUCTION

1 - FIRST FLOOR INCREASE CEILING HEIGHT FROM 9 FEET TO 10 FEET 27Oct23 Note:	
---	--

PROMOTIONAL

1 - LESS CREDIT FROM PURCHASER EXTRA SHEET IN OFFER 27Oct23 Note:	
--	--

EXTRAS AS PER OFFER

The Vendor agrees that notwithstanding any other term or provision in this Agreement included in the Purchase Price and in addition to those items detailed in Schedule GP to the Agreement of Purchase and Sale, the Purchaser is entitled to a credit of Ten Worksheet Note:	
---	--


This Document is Extremely Time Sensitive - Printed 27 Oct 23 at 16:19

Rose 2 40' Lot

Elev. 1: 3,005 sq.ft. Elev. 2: 2,999 sq.ft. Elev. 3: 2,998 sq.ft.



Lot 20 Trinigroup.

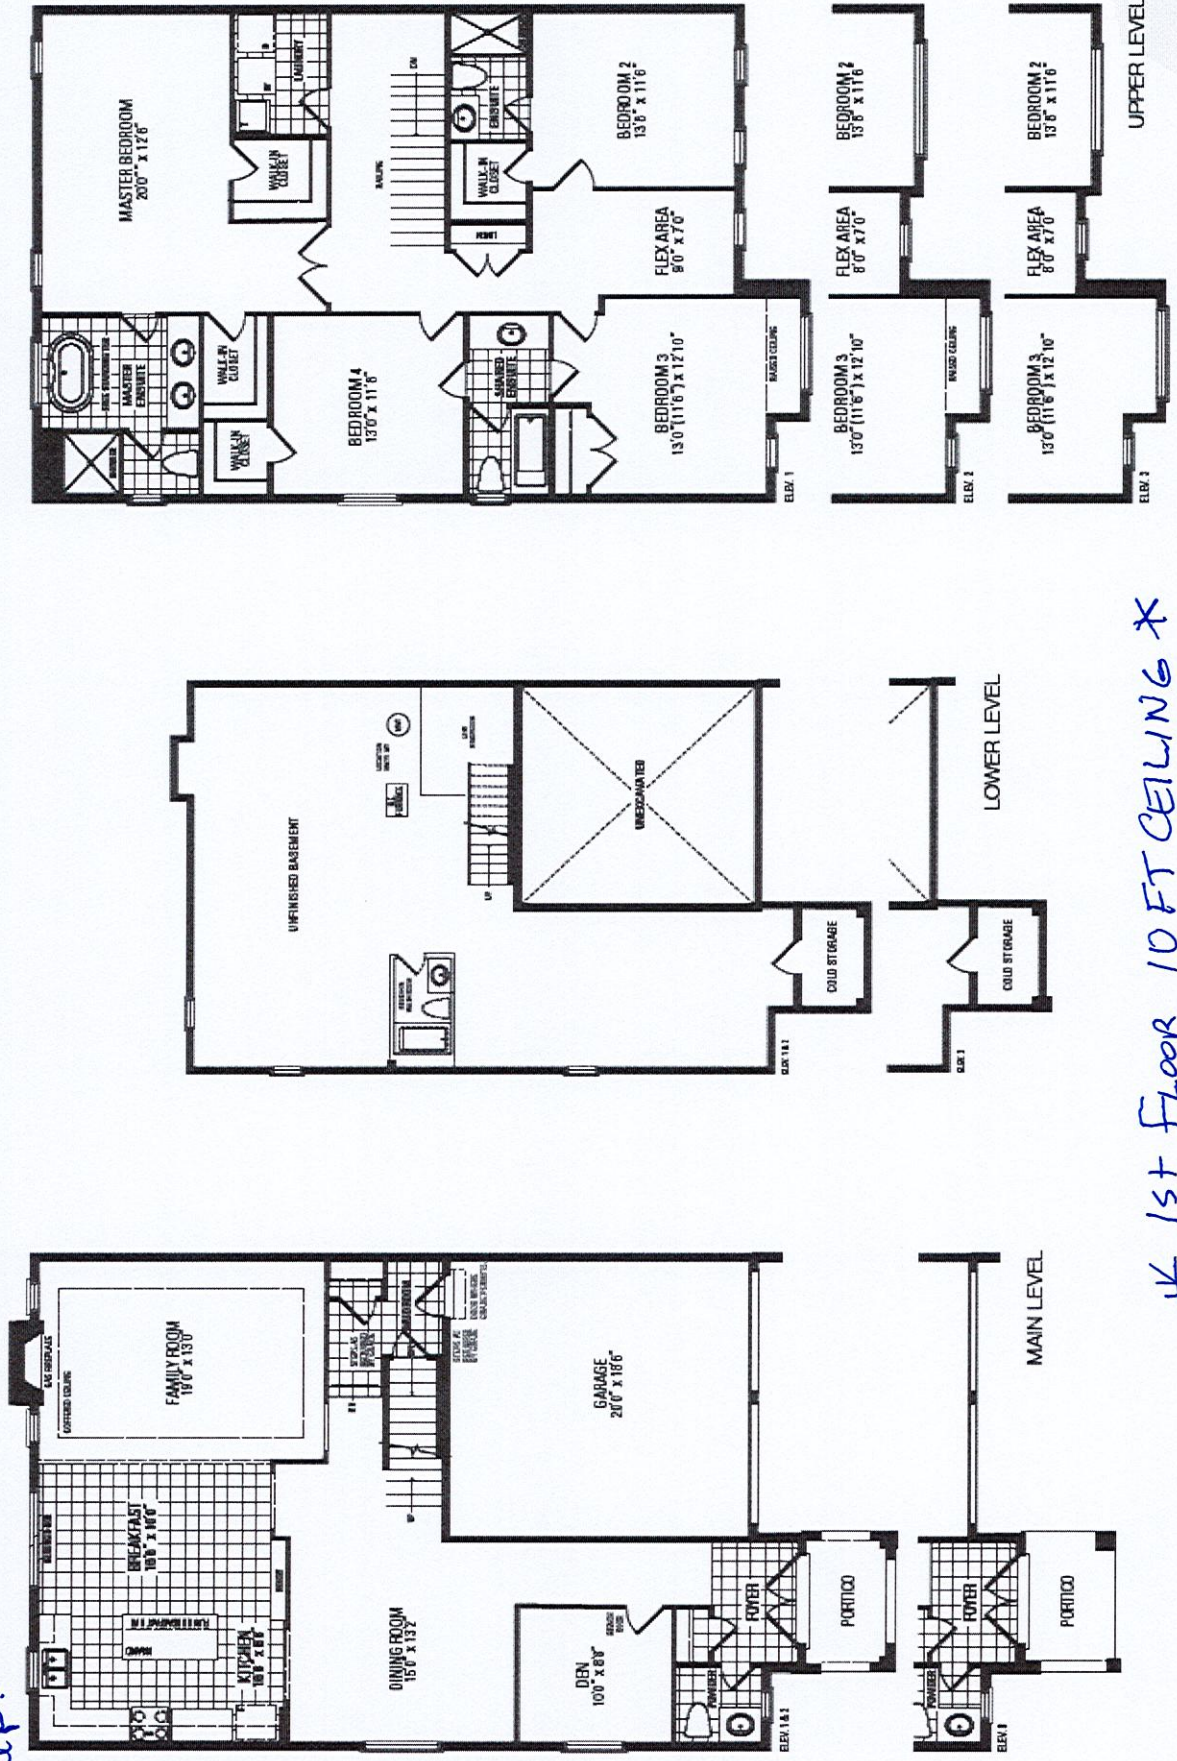

* 1st Floor 10 FT CEILING *

Orientation of home may be reversed and purchaser agrees to accept the same. Steps and porches may vary at any exterior entrance ways due to grading variance. Actual usable floor space may vary from the stated floor areas. All renderings are artist's concept. Dimensions, specifications and architectural detailing subject to modifications. Roofline and adjoining model types may vary due to siting. E. O. E. September 2023