

CONSTRUCTION SUMMARY Legacy Hill - Trinigroup Development Inc.					RECEIVED OCT 30 2023		TEL:		
PURCHASERS: Jin BAI and Yi Se PAN									
LOT / PHASE		REG. PLAN #		HOUSE TYPE					
35 / 1				Rose 5 Elev 1 (5 Bedroom)					

CONSTRUCTION

1 - LOWER LEVEL - BASEMENT 8 FOOT 6 INCH CONCRETE POUR - MEASURED FROM TOP OF FOOTING TO TOP OF FOUNDATION WALL									
27Oct23 Note:									
1 - FIRST FLOOR INCREASE CEILING HEIGHT FROM 9 FEET TO 10 FEET									
27Oct23 Note:									

PROMOTIONAL

1 - LESS CREDIT FROM PURCHASER EXTRA SHEET IN OFFER									
27Oct23 Note:									

EXTRAS AS PER OFFER

The Vendor agrees that notwithstanding any other term or provision in this Agreement included in the Purchase Price and in addition to those items detailed in Schedule GP to the Agreement of Purchase and Sale, the Purchaser is entitled to a credit of Ten									
Worksheet Note:									

This Document is Extremely Time Sensitive - Printed 27 Oct 23 at 16:31


Rose 5 40' Lot

Elev. 1: 3.357 sq.ft. Elev. 2: 3.337 sq.ft. Elev. 3: 3.339 sq.ft.



Lot 35 TRINICK

8ft 6in Concrete
Base-Basement

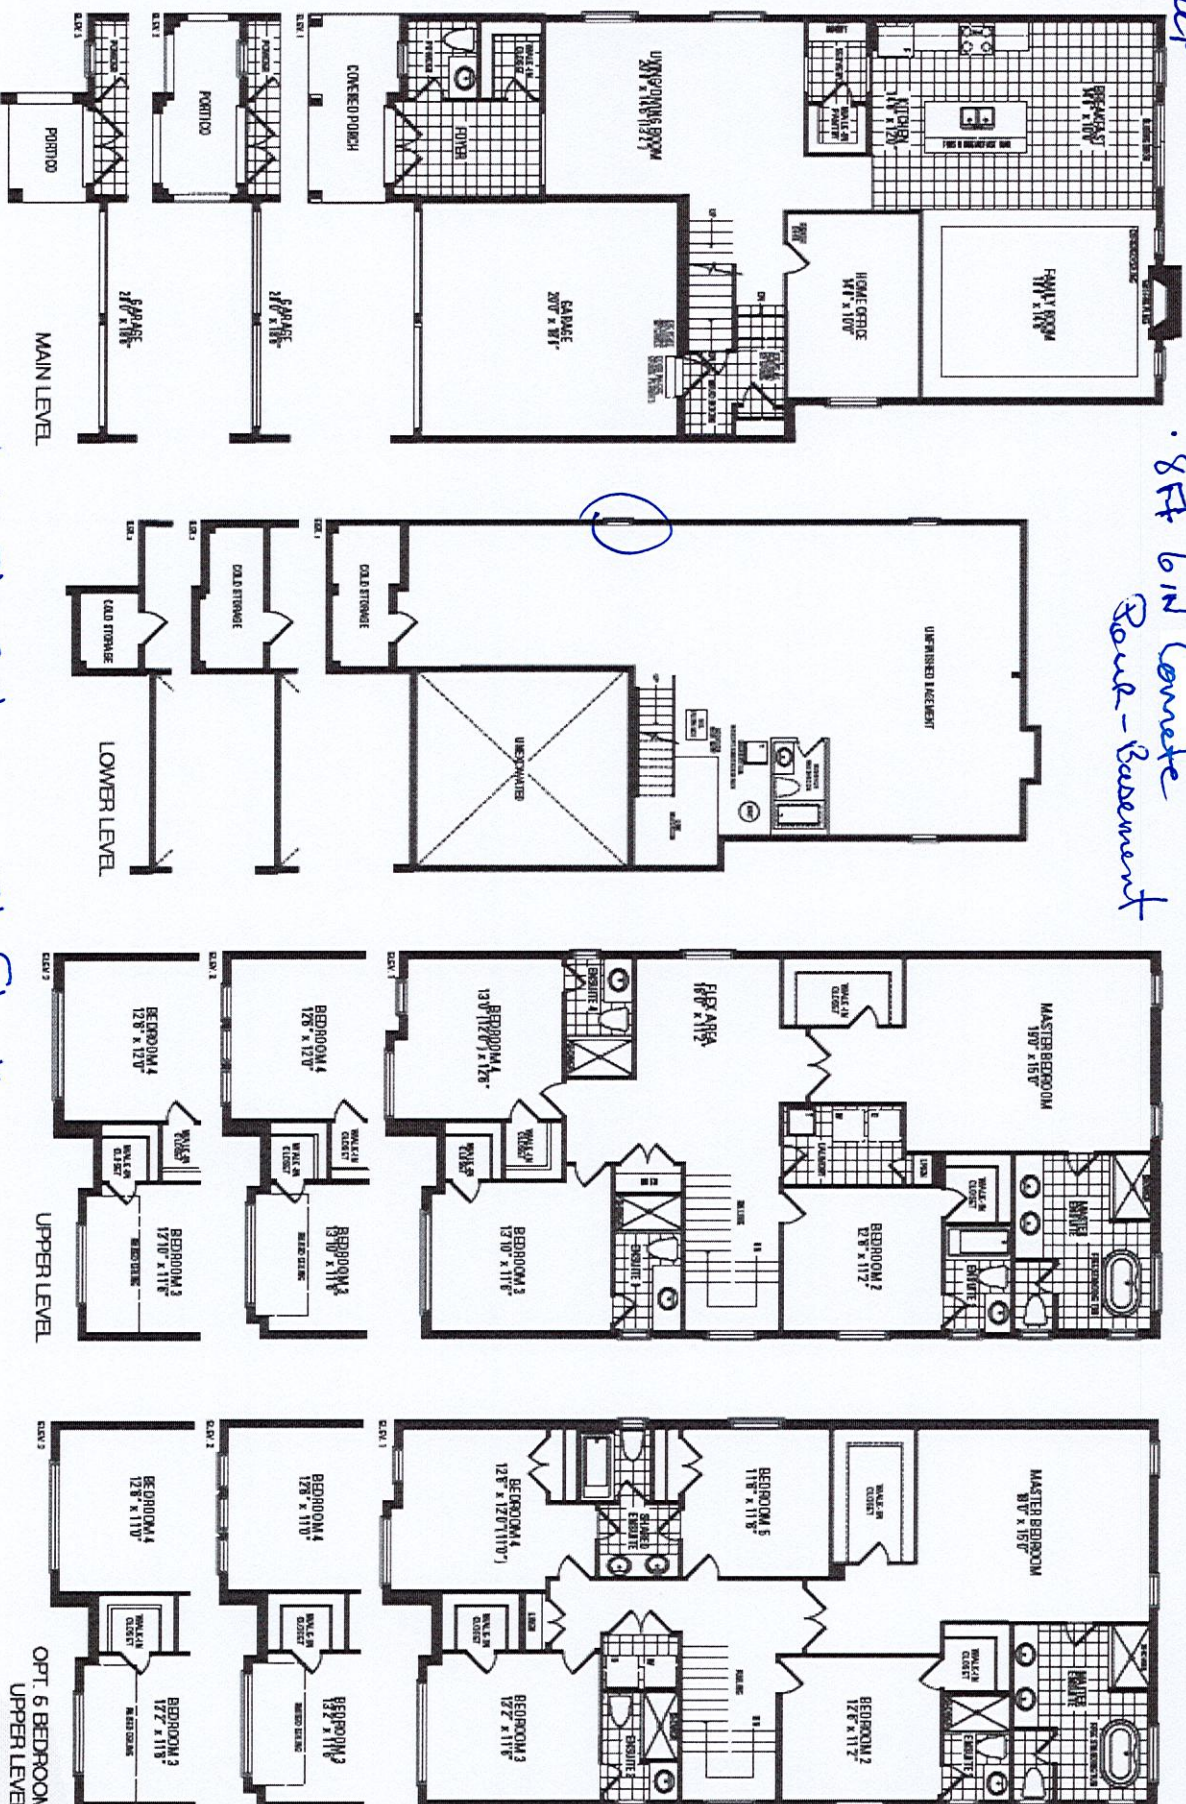

* 10 Ft Ceilings 1st Fl. *

Orientation of home may be reversed and purchaser agrees to accept the same. Steps and porches may vary at any exterior entrance ways due to grading variance. Actual usable floor space may vary from the stated floor areas. All renderings are artist's concept. Dimensions, specifications and architectural detailing subject to modifications. Roofline and adjoining model types may vary due to siting. E. & O. E. September 2023