

CONSTRUCTION SUMMARY

Palmetto - Zadorra Estates Corp.

PURCHASER: INVENTORY HOME_104

TEL:

LOT / PHASE 104 / 1	REG. PLAN #	HOUSE TYPE Penrose 1 Elev 1		
------------------------	-------------	--------------------------------	--	--

CABINETRY

1 - CABINETRY - BEDROOM 2 ENSUITE VANITY - UPGRADE 2 08Nov23 Note:	
1 - CABINETRY - MASTER ENSUITE VANITY - UPGRADE 2 08Nov23 Note:	
1 - CABINETRY - KITCHEN - UPGRADE 2 08Nov23 Note:	
1 - CABINETRY - KITCHEN - LIGHT VALANCE 08Nov23 Note:	
1 - CABINETRY - KITCHEN - HARDWARE UPGRADE 2 08Nov23 Note:	

CABINETRY ACCESSORIES

1 - LAUNDRY CABINETRY - ADD ONE ADDITIONAL STANDARD SERIES LAUNDRY CABINET ABOVE WASHER/DRYER - SEE SKETCH 08Nov23 Note:	
1 - KITCHEN HOOD CABINETS - CONTEMPORARY WOOD HOOD - UPGRADE 2 08Nov23 Note:	
2 - KITCHEN CABINETRY UPPER - GLASS DOOR - BEVELED - FINISHED INTERIOR - FITS TALL UPPER CABINETS - PRICE IS PER DOOR - UPGRADE 2 08Nov23 Note:	
1 - KITCHEN CABINETRY BASE - PULLOUT WIRE SPICE RACK - PRICE IS EACH 08Nov23 Note:	
1 - KITCHEN CABINETRY - APPLIANCE DOOR PANELS - 24" DISHWASHER DOOR PANEL (SUPPLY ONLY, INSTALLATION NOT INCLUDED, HARDWARE NOT INCLUDED) - UPGRADE 2 08Nov23 Note:	
1 - KITCHEN CABINETRY - APPLIANCE DOOR PANELS - FRIDGE DOOR PANELS - SUPPLY ONLY, INSTALLATION NOT INCLUDED, HARDWARE NOT INCLUDED - 30"-36" WIDE FRIDGES - UPGRADE 2 08Nov23 Note:	
1 - KITCHEN CABINETRY - BUILT-IN FRIDGE FEE - PRICE IS EACH 08Nov23 Note:	
1 - KITCHEN CABINETRY UPPER - FULL DEPTH ABOVE FRIDGE UPPER WITH GABLES - 650MM DEEP - PRICE IS EACH 08Nov23 Note:	
1 - KITCHEN CABINETRY - BUILT-IN MICROWAVE/OVEN COMBO WITH ONE POT DRAWER - UPGRADE 2 08Nov23 Note: SHIFT FRIDGE TO ACCOMODATE - SEE SKETCH	
1 - KITCHEN CABINETRY BASE - COOKTOP CABINET WITH POT DRAWERS (2 DRAWERS) - UPGRADE 2 08Nov23 Note: 36" COOKTOP	
1 - KITCHEN CABINETRY BASE - PULLOUT RECYCLE 2 BIN - PRICE IS EACH 08Nov23 Note:	

CERAMIC TILE

CONSTRUCTION SUMMARY				
PURCHASER: INVENTORY HOME_104			TEL:	
LOT / PHASE 104 / 1	REG. PLAN #	HOUSE TYPE Penrose 1 Elev 1		
1 - UPGRADE FLOOR TILE THROUGHOUT MAIN LEVEL IN ALL TILED AREAS 08Nov23 Note:				
1 - TILE - UPGRADE 4 WALL TILE - BEDROOM 3/4 SHARED ENSUITE WALL - TUB 08Nov23 Note:				
1 - TILE - UPGRADE 4 FLOOR TILE - BEDROOM 3/4 SHARED ENSUITE FLOOR 08Nov23 Note:				
1 - TILE - UPGRADE 4 WALL TILE - BEDROOM 2 ENSUITE WALL - TUB 08Nov23 Note:				
1 - TILE - UPGRADE 4 FLOOR TILE - BEDROOM 2 ENSUITE FLOOR 08Nov23 Note:				
1 - TILE - UPGRADE 5 WALL TILE - MASTER ENSUITE WALL - SHOWER 08Nov23 Note:				
1 - TILE - UPGRADE 5 FLOOR TILE - MASTER ENSUITE FLOOR 08Nov23 Note:				
1 - DELETE ALL CERAMIC BATHROOM ACCESSORIES - DELETE TOWEL BAR, PAPER HOLDER & SOAP DISH THROUGHOUT 08Nov23 Note:				

CONSTRUCTION

1 - MASTER ENSUITE - PROVISION FOR SHAMPOO NICHE APPROX. 14" WIDE X 20" HIGH AS PER SKETCH – IF CONSTRUCTION PERMITS 08Nov23 Note:	
1 - MASTER ENSUITE - PROVISION FOR FRAMELESS GLASS SHOWER ENCLOSURE - REMOVE SIDE WALL AND REPLACE WITH GLASS TO ACCOMMODATE FRAMELESS GLASS SHOWER ENCLOSURE SEE SKETCH 08Nov23 Note:	
1 - SMOOTH CEILINGS ON FIRST FLOOR 08Nov23 Note:	

COUNTER TOP

1 - BEDROOM 3/4 SHARED ENSUITE COUNTER TOP - UPGRADE STONE COUNTER TOP WITH 3" BACKSPLASH RETURN - ALL SIDES 08Nov23 Note:	
1 - BEDROOM 2 ENSUITE COUNTER TOP - UPGRADE STONE COUNTER TOP WITH 3" BACKSPLASH RETURN - ALL SIDES 08Nov23 Note:	
1 - MASTER ENSUITE COUNTER TOP - UPGRADE STONE COUNTER TOP WITH 3" BACKSPLASH RETURN - ALL SIDES 08Nov23 Note:	
1 - POWDER ROOM COUNTER TOP - UPGRADE STONE COUNTER TOP WITH 3" BACKSPLASH RETURN - ALL SIDES 08Nov23 Note:	
2 - KITCHEN - WATERFALL LEGS AT ISLAND 08Nov23 Note:	

CONSTRUCTION SUMMARY				
Palmetto - Zadorra Estates Corp.				TEL:
PURCHASER: INVENTORY HOME_104				
LOT / PHASE	REG. PLAN #	HOUSE TYPE		
104 / 1		Penrose I Elev 1		
1 - KITCHEN BACKSPLASH FULL HEIGHT - UPGRADE STONE COUNTER TOP				
08Nov23 Note:				
1 - KITCHEN COUNTER TOP - UPGRADE STONE COUNTER TOP				
08Nov23 Note:				
1 - MASTER ENSUITE - SHAMPOO NICHE 14" WIDE X 20" HIGH AS PER SKETCH - MARBLE, GRANITE OR QUARTZ - IF CONSTRUCTION PERMITS				
08Nov23 Note: SUPPLY & INSTALL				

DOORS AND TRIM

1 - INTERIOR DOOR LEVERS WHERE APPLICABLE - HALIFAX SQUARE - #15 SATIN NICKEL FINISH				
08Nov23 Note:				
1 - FRONT DOOR GRIP SET - TAVARIS - #15 SATIN NICKEL FINISH				
08Nov23 Note:				
1 - INTERIOR DOORS - UPGRADE INTERIOR DOOR STYLE THROUGHOUT WHERE APPLICABLE - FOR 9' MAIN FLOOR - LOGAN				
08Nov23 Note:				
1 - TRIM - 7 1/4 INCH BASEBOARD AND 3 1/4 INCH BB CASING - STEP				
08Nov23 Note:				

ELECTRICAL

1 - KITCHEN - FAN INSERT FOR UPGRADE 36" HOOD - CYCLONE BX600-34 SS INSERT				
08Nov23 Note:				
1 - KITCHEN - SHIFT FRIDGE TO ACCOMODATE BUILT-IN TOWER - SEE SKETCH				
08Nov23 Note:				
1 - KITCHEN - VALANCE LIGHTING - LED LIGHTING				
08Nov23 Note:				
1 - BEDROOM 2 ENSUITE - ADD CEILING LIGHT - SEE SKETCH				
08Nov23 Note:				
2 - LIGHT AND SWITCH - ADD ADDITIONAL WALL SCONCE LIGHT ABOVE VANITY MIRROR (LIGHT ABOVE EACH SINK) - MASTER ENSUITE & BEDROOM 3/4 SHARED ENSUITE				
SEE SKETCH				
08Nov23 Note:				
2 - POT LIGHT - TUB/SHOWER POT LIGHT - BEDROOM 2 ENSUITE & BEDROOM 3/4 SHARED ENSUITE				
08Nov23 Note:				
10 - POT LIGHT - LED - SECOND FLOOR INSTALLATION - SEE SKETCH				
08Nov23 Note:				
1 - PLUG - ELECTRICAL PLUG - TO BE INSTALLED OVER FIREPLACE - FAMILY ROOM				
08Nov23 Note:				
1 - LIGHT AND SWITCH - NO FIXTURE INCLUDED - LAUNDRY ROOM - SEE SKETCH - 2 CEILING LIGHTS TOTAL				
08Nov23 Note:				
1 - POWDER ROOM - ADD WALL SCONCE LIGHT ABOVE VANITY MIRROR - SEE SKETCH				
08Nov23 Note:				

CONSTRUCTION SUMMARY

Palmetto - Zadorra Estates Corp.

PURCHASER: INVENTORY HOME_104

TEL:

LOT / PHASE	REG. PLAN #	HOUSE TYPE		
104 / 1		Penrose 1 Elev 1		

1 - ABOVE KITCHEN ISLAND - RELOCATE STANDARD KITCHEN LIGHT TO BE ABOVE ISLAND AND ADD AN ADDITIONAL LIGHT - 2 LIGHTS TOTAL - SEE SKETCH
08Nov23 Note:

1 - STANDARD DINING ROOM LIGHT TO BE CENTERED BETWEEN LIVING AND DINING ROOM
08Nov23 Note:

21 - POT LIGHT - LED - FIRST FLOOR INSTALLATION - SEE SKETCH
08Nov23 Note:

6 - POT LIGHT - EXTERIOR - SOFFIT MOUNT - REGULAR VOLTAGE - SEE SKETCH
08Nov23 Note:

2 - LIGHT - EXTERIOR WALL SCONE LIGHTS AT FRONT PORCH ON EXISTING SWITCH - SEE SKETCH
08Nov23 Note: RELOCATE STANDARD PORCH LIGHT TO CEILING

1 - ELECTRICAL SKETCH - REFER TO ELECTRICAL SKETCH FOR STANDARD LIGHT LOCATIONS & POT LIGHT PLAN - SEE SKETCH
08Nov23 Note:

FIREPLACE AND ACCESSORIES

1 - CASTSTONE FIREPLACE MANTEL - AEQUALITAS 3 - WHITE
08Nov23 Note:

HARDWOOD FLOORING

1 - HARDWOOD - GROUP C SERIES 5 INCH - UPPER LEVEL IN NON TILED AREAS
08Nov23 Note:

1 - HARDWOOD - GROUP C SERIES 5 INCH - FIRST FLOOR HARDWOOD AREAS INCLUDING STAIR LANDINGS
08Nov23 Note:

MIRRORS AND GLASS

1 - MASTER ENSUITE - FRAMELESS GLASS SHOWER ENCLOSURE - INCLUDES BRUSHED NICKEL D-RING HANDLE AND BRUSHED NICKEL HINGES
08Nov23 Note:

PLASTER MOULDINGS

1 - CORNICE MOULDING FOR MAIN LEVEL AS PER SKETCH
08Nov23 Note:

PLUMBING

6 - ALL BATH VANITY SINKS - SINK - UNDERMOUNT SINK - TECO BATH #4815
08Nov23 Note:

1 - KITCHEN SINK - UNDERMOUNT SINK - TECO KITCHEN #602
08Nov23 Note:

1 - MOEN - VOSS - ECO-PERFORMANCE POSI-TEMP TUB/SHOWER FAUCET #T2693EPBN/62320 - BRUSHED NICKEL FINISH
BEDROOM 3/4 SHARED ENSUITE
08Nov23 Note:

1 - MOEN - VOSS - ECO-PERFORMANCE POSI-TEMP SHOWER ONLY #T2692EPBN/62320 - BRUSHED NICKEL FINISH
MASTER ENSUITE
08Nov23 Note:

CONSTRUCTION SUMMARY				
PURCHASER: INVENTORY HOME_104				TEL:
LOT / PHASE 104 / 1	REG. PLAN #	HOUSE TYPE Penrose 1 Elev 1		
1 - MOEN - VOSS - TWO HANDLE ROMAN TUB FAUCET #T693BN/4796 - BRUSHED NICKEL FINISH MASTER ENSUITE 08Nov23 Note:				
5 - MOEN - VOSS TWO HANDLE 8" WIDESPREAD LAVATORY FAUCET #T6905BN/69000 - BRUSHED NICKEL FINISH POWDER ROOM X1 MASTER ENSUITE X2 SHARED ENSUITE BED 3/4 X2 08Nov23 Note:				
1 - MOEN - KURV KITCHEN SINGLE HANDLE HIGH ARC PULLDOWN KITCHEN FAUCET #9126SRS - SPOT RESIST STAINLESS FINISH 08Nov23 Note:				

STAIRS AND RAILINGS

1 - STAINED STAIRS - PREMIUM STAIN - STANDARD STAIRCASE 08Nov23 Note: INCLUDING STEPS TO LOWER LANDING	
1 - PICKETS - EUROLINE 0 - BLACK PICKETS 08Nov23 Note:	
1 - HANDRAIL - V-GROOVE HANDRAIL 08Nov23 Note:	
1 - POSTS - 4X4 POSTS - BOX POST 08Nov23 Note:	

This Document is Extremely Time Sensitive - Printed 8 Nov 23 at 14:55

Purchaser:

INVENTORY HOME_104

Telephone Res. / Bus:

/

Decor Advisor:

Aly Aversa

Lock Date:

8-Nov-23

Property: 104

Project: Zadorra Estates Corp.

Model and Elevation: Penrose 1 Elev 1

Plan #:

1. Cabinetry

	Style and Colour	Hardware
Kitchen / Breakfast	HAMPTON 350 PLATINUM SILVER	738SD
Laundry Room	ELISSE	468SA
Powder Room	HAMPTON 350 PLATINUM SILVER	468SA
Master Ensuite Bathroom	HAMPTON DRIFTWOOD	468SA
Ensuite Bath - Bedroom 2	ARUBA 689 METALLICA	468SA
Ensuite Bath - Bedroom 3/4	DORAL SUMMIT WHITE	468SA

Stove Opening

36"

NOTE: If not specified, opening will be set to builder's standard opening of approximately 30" width

Fridge Opening

NOTE: If not specified, opening will be set to builder's standard opening of approximately 37" width x 74" height

** Refer to Construction Summary

2. Counters

	Counter	Edge	Niche
Kitchen / Breakfast	QUARTZ- ATMOSPHERA WHITE FEATHER	#360 EDGE	
Laundry Room	N/A		
Powder Room	QUARTZ- ATMOSPHERA WHITE FEATHER	#360 EDGE	
Master Ensuite Bathroom	QUARTZ- ATMOSPHERA WHITE FEATHER	#360 EDGE	quartz-atmosfera white feather
Ensuite Bath - Bedroom 2	QUARTZ- ATMOSPHERA WHITE FEATHER	#360 EDGE	
Ensuite Bath - Bedroom 3/4	QUARTZITE- TAJ MAHAL	#360 EDGE	
Kitchen Backsplash	QUARTZ- ATMOSPHERA WHITE FEATHER- FULL HEIGHT		

** Refer to Construction Summary **ALL BATHROOM VANITIES COUNTERTOPS TO HAVE 3" BACKSPLASH RETURN

Purchaser:

INVENTORY HOME_104

Telephone Res. / Bus:

/

Decor Advisor:

Aly Aversa

Lock Date:

8-Nov-23

Property: 104

Project: Zadorra Estates Corp.

Model and Elevation: Penrose 1 Elev 1

Plan #:

3. Ceramic Flooring

Entrance Vestibule	TILE- AZUVI- CLASS BIANCO 12X24	At a 45
Main Hall	HARDWOOD	
Kitchen / Breakfast	TILE- AZUVI- CLASS BIANCO 12X24	
Laundry Room	TILE- STONE WHITE 12X24	
Powder Room	TILE- AZUVI- CLASS BIANCO 12X24	
Master Ensuite Bathroom	TILE- AGATA WHITE 12X24	
Ensuite Bath - Bedroom 2	TILE- TRAVERTINO MOMENTO BIANCO 12X24	
Ensuite Bath - Bedroom 3/4	TILE- CLASSIC CALCATTA 12X24	

** Refer to Construction Summary ** METAL STRIP THRESHOLD WHERE APPLICABLE UNLESS SPECIFIED **

4. Ceramic Wall Tile

Master Ensuite Bathroom	Selection	Describe
Tub Deck Wall		
Shower Stall	TILE- AGATA WHITE 12X24	
Bathtub Enclosure Walls		
Ensuite Bath - Bedroom 2	TILE- TRAVERTINO MOMENTO BIANCO 12X24	
Ensuite Bath - Bedroom 3/4	TILE- CLASSIC CALCATTA 12X24	
Kitchen Backsplash		

** Refer to Construction Summary - STANDARD GROUT THROUGHOUT UNLESS SPECIFIED

5. Trim Carpentry

Interior Doors	LOGAN-SMOOTH
Interior Trim	3 1/4" BB CASING WITH 7 1/4" BASEBOARD - ONE STEP

** Refer to Construction Summary

6. Plaster Mouldings and Medallions

Entrance Vestibule	UP033		Kitchen/Breakfast	UP033	
Main Hall	UP033		Den/Library		
Living Room	UP033		Lower Landing	UP033	
Dining Room	UP033				
Family Room	UP033				

** Refer to Construction Summary SEE FLOOR PLAN FOR MARKED AREAS WITH MOULDINGS

Purchaser:

INVENTORY HOME_104

Telephone Res. / Bus:

/

Decor Advisor:

Aly Aversa

Lock Date:

8-Nov-23

Property: 104

Project: Zadorra Estates Corp.

Model and Elevation: Penrose 1 Elev 1

Plan #:

7. Other Flooring

Main Hall	HARDWOOD- VINTAGE- WHITE OAK- N.S.S- ATLANTIS 5"- WIRE BRUSHED CHARACTER - UVF
Living Room	HARDWOOD- VINTAGE- WHITE OAK- N.S.S- ATLANTIS 5"- WIRE BRUSHED CHARACTER - UVF
Dining Room	HARDWOOD- VINTAGE- WHITE OAK- N.S.S- ATLANTIS 5"- WIRE BRUSHED CHARACTER - UVF
Family Room	HARDWOOD- VINTAGE- WHITE OAK- N.S.S- ATLANTIS 5"- WIRE BRUSHED CHARACTER - UVF
Den / Library / Study	N/A
Basement Landing(If Applies)	N/A
Lower Landing (If Applies)	HARDWOOD- VINTAGE- WHITE OAK- N.S.S- ATLANTIS 5"- WIRE BRUSHED CHARACTER - UVF
Upper Landing	HARDWOOD- VINTAGE- WHITE OAK- N.S.S- ATLANTIS 5"- WIRE BRUSHED CHARACTER - UVF
Upper Hall	HARDWOOD- VINTAGE- WHITE OAK- N.S.S- ATLANTIS 5"- WIRE BRUSHED CHARACTER - UVF
Master Bedroom	HARDWOOD- VINTAGE- WHITE OAK- N.S.S- ATLANTIS 5"- WIRE BRUSHED CHARACTER - UVF
Bedroom #2	HARDWOOD- VINTAGE- WHITE OAK- N.S.S- ATLANTIS 5"- WIRE BRUSHED CHARACTER - UVF
Bedroom #3	HARDWOOD- VINTAGE- WHITE OAK- N.S.S- ATLANTIS 5"- WIRE BRUSHED CHARACTER - UVF
Bedroom #4	HARDWOOD- VINTAGE- WHITE OAK- N.S.S- ATLANTIS 5"- WIRE BRUSHED CHARACTER - UVF
Bedroom #5	

Underpad

Standard ☐

Upgrade

** Refer to Construction Summary

8. Railings and Pickets

Railing Type	V-GROOVE WITH 4X4 BOX POSTS	Colour	PREMIUM STAIN- VINTAGE- ATLANTIS
Picket Type	EUROLINE 0	Colour	BLACK
Stringer / Riser	AS PER CONSTRUCTION SPECIFICATIONS	Colour	PREMIUM STAIN- VINTAGE- ATLANTIS
Treads	AS PER CONSTRUCTION SPECIFICATIONS	Colour	PREMIUM STAIN- VINTAGE- ATLANTIS

Red Oak Stairs as Per Vendor's Standard

** Refer to Construction Summary THE STAIN COLOURS OR FINISH AVAILABLE ON RISERS, TREADS, PICKETS AND RAILS (STAIRCASES), WILL NOT BE AN EXACT MATCH TO PREFINISHED HARDWOOD OR LAMINATE FLOORS.

9. Wall Paint Flat Finish

Main & Upper Hall	43 BIRCH WHITE	Master Bedroom	43 BIRCH WHITE
Living Room	43 BIRCH WHITE	Bedroom #2	43 BIRCH WHITE
Dining Room	43 BIRCH WHITE	Bedroom #3	43 BIRCH WHITE
Kitchen / Breakfast	43 BIRCH WHITE	Bedroom #4	43 BIRCH WHITE
Family Room	43 BIRCH WHITE	Bedroom #5	
Powder Room	43 BIRCH WHITE	Master Ensuite	43 BIRCH WHITE
Laundry Room	43 BIRCH WHITE	Ensuite Bath - Bedroom 2	43 BIRCH WHITE
Den/Library		Ensuite Bath - Bedroom 3/4	43 BIRCH WHITE
Trim & Door Paint-Semi Gloss	43 BIRCH WHITE		

** Refer to Construction Summary

Purchaser:	INVENTORY HOME_104	Property:	104
Telephone Res. / Bus:	/	Project:	Zadorra Estates Corp.
Decor Advisor:	Aly Aversa	Model and Elevation:	Penrose 1 Elev 1
Lock Date:	8-Nov-23	8-Nov-23	Plan #:

10. Fireplace

	Living Room			Family Room			Other Room - Specify		
	Purchased	As Per Plan	N/A	Purchased	As Per Plan	N/A	Purchased	As Per Plan	N/A
	☐	☐	☒	☐	☒	☐	☐	☐	☒
Fireplace Type				FLAT ON WALL					
Mantle Type				CASTONE- AEQUALITAS 3					
Colour / Stain				WHITE					
Surround				N/A					
Hearth				N/A					
** Refer to Construction Summary									

11. Air Conditioning

Air Conditioning	YES
Comment	
** Refer to Construction Summary	

12. General Comments

** Refer to Construction Summary


Disclaimers and Notes

1) Colours of all materials are as close as possible to builder's selection, but not necessarily identical due to variances in manufacturing. 2) Any extras listed above are null and void unless accompanied by a separate invoice/amendment. Said invoice must be paid in full. 3) The Purchaser agrees that this colour selection is final and that no changes will be permitted, unless required by the Vendor. 4) The Purchaser acknowledges reading and accepting document which contains other miscellaneous disclaimers. 5) In the event of a conflict between the Standard Features schedule of the Agreement of Purchase and Sale and the Interior Colour Scheme, the Interior Colour Scheme shall prevail. Signature:_____ Date: _____

Lot # 104

Legend

- ⊕ ceiling fixture
- Pot light
- W wall sconce
- ⊕ plug

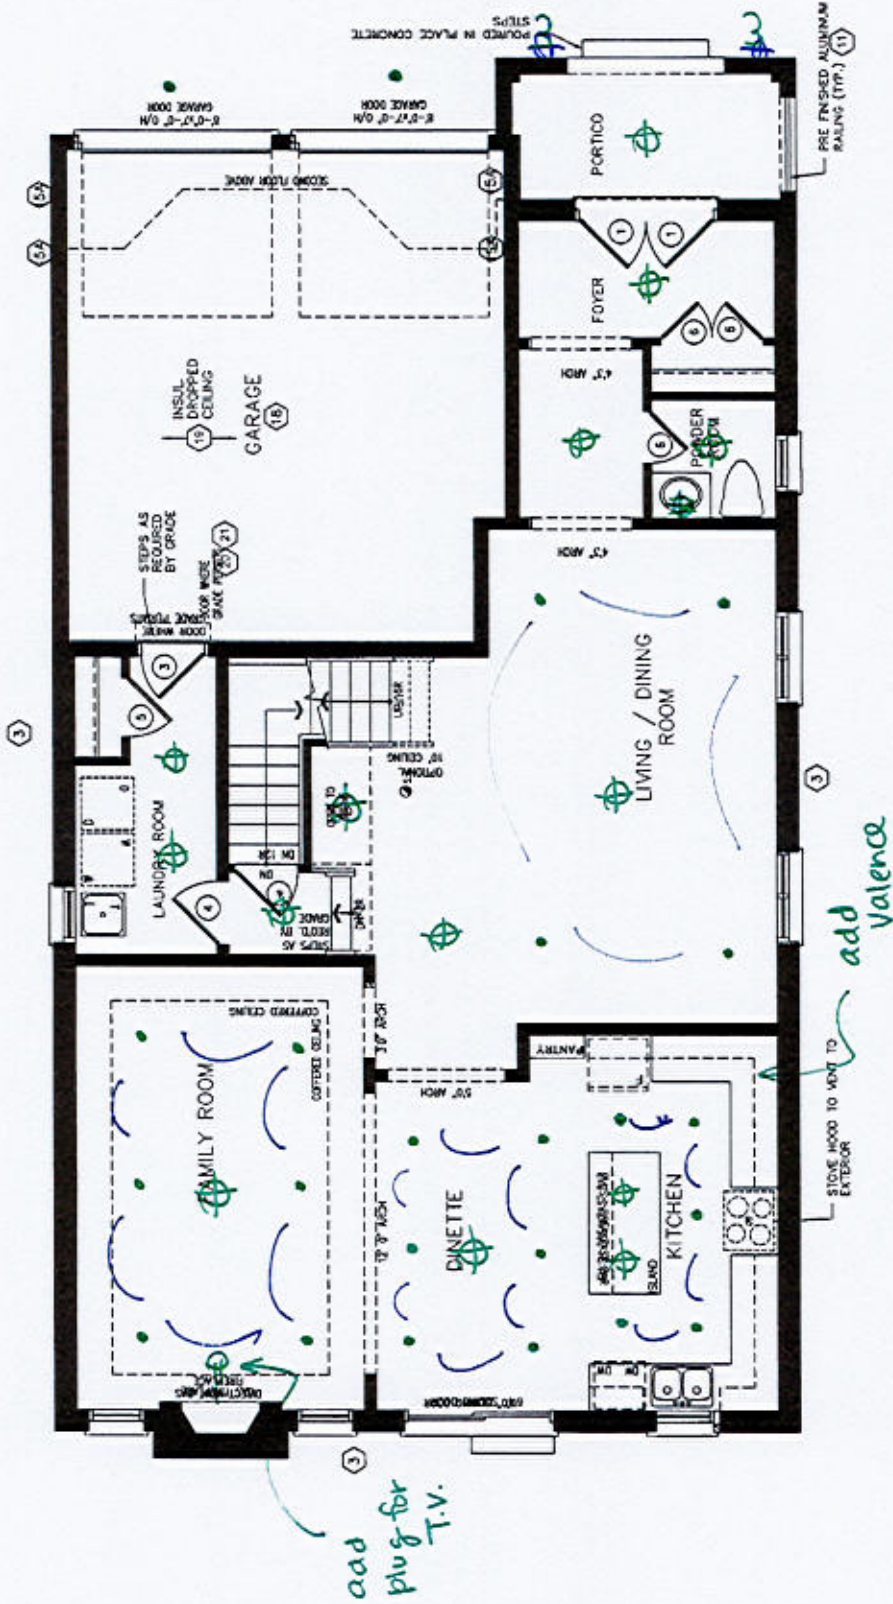

FIRST FLOOR PLAN 1


REFER TO SHEET NO. 0 FOR UNITS, BEAMS AND DOOR SIZES

SPACE CONVENTIONAL FLOOR JOISTS @ 12" O.C. BELOW ALL CERAMIC TILE AREAS. PROVIDE 1 ROW BRIDGING FOR SPANS OF 5'-7', 2 ROWS FOR SPANS GREATER THAN 7'


REFER TO FLOOR FRAMING SHOP DRAWINGS FOR ENGINEERED FRAMING LAYOUTS

ALL SUBFLOORS TO BE 5/8" PLYWOOD AND TO BE GULF AND NAILED ON THIS FLOOR

Lot # 104

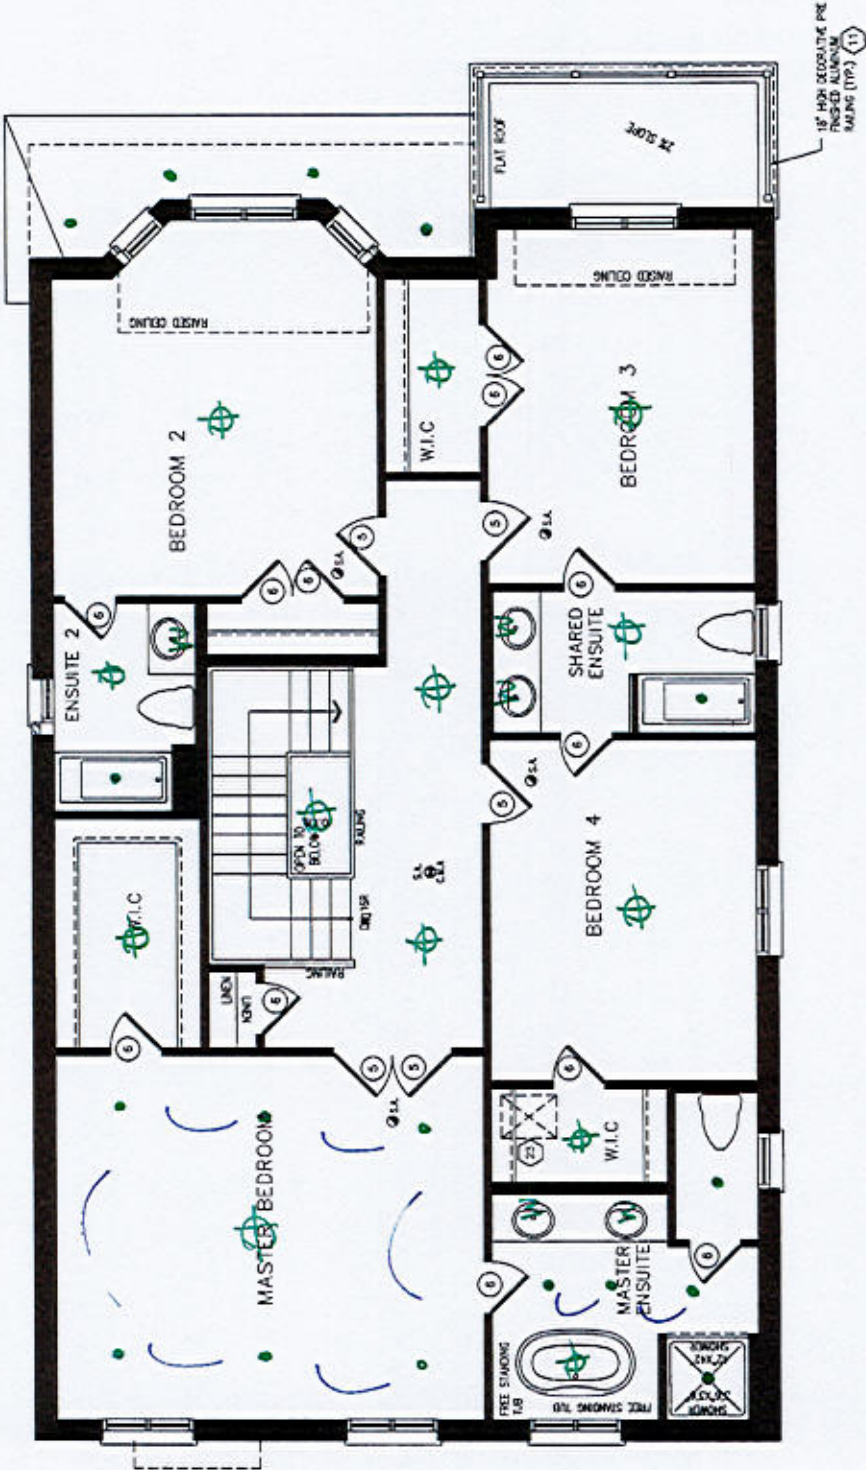

SECOND FLOOR PLAN 1

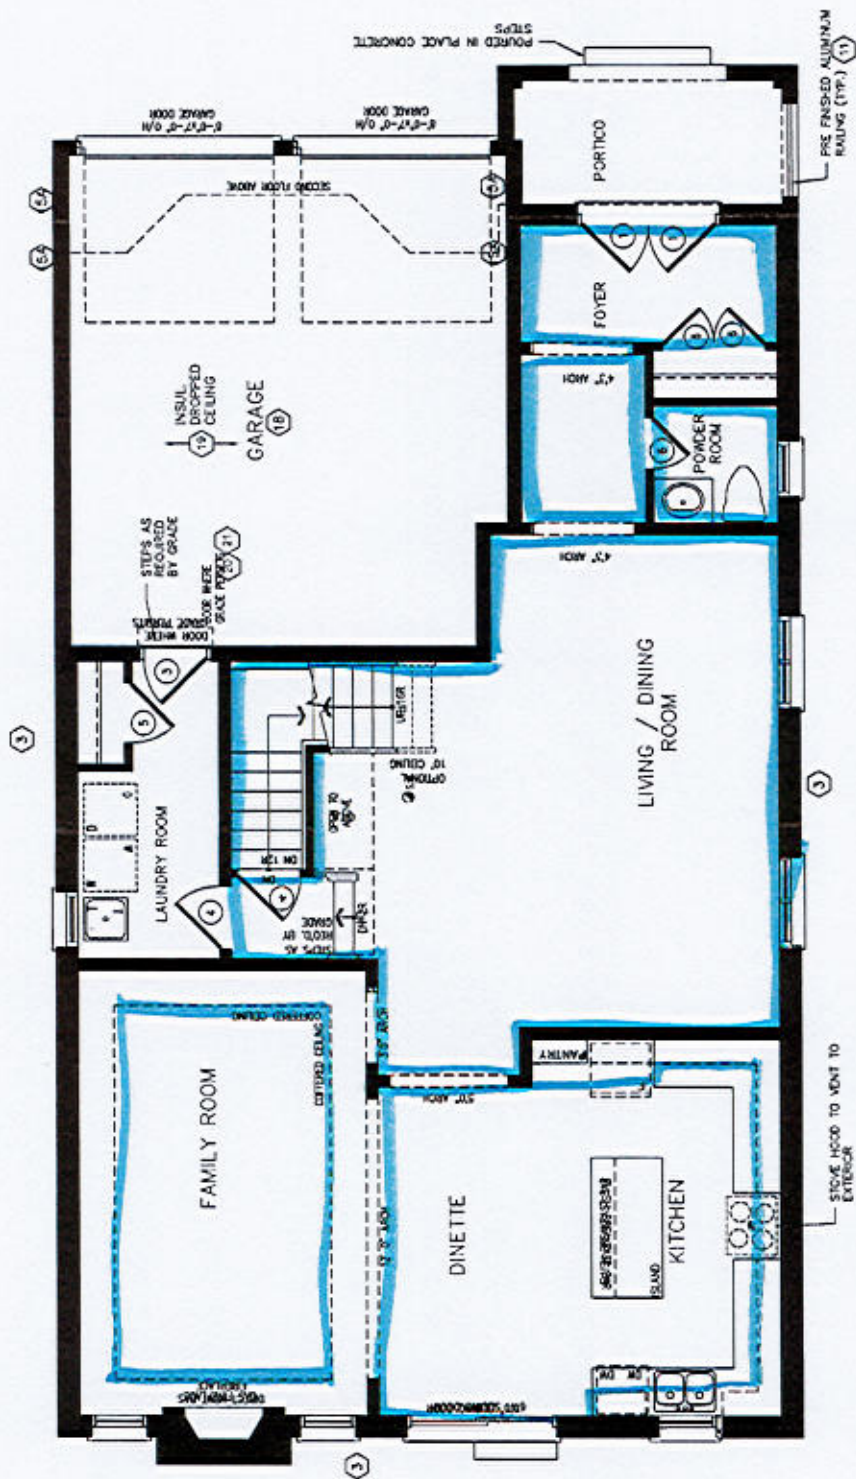

- Crown

Lot # 104

FIRST FLOOR PLAN 1

REFER TO SHEET NO. 0 FOR UNTEL, BEAMS AND DOOR SIZES

REFER TO FLOOR FRAMING SHOP DRAWINGS FOR ENGINEERED FRAMING LAYOUTS

SPACE CONVENTIONAL FLOOR JOISTS @ 12" O.C. BELOW ALL CERAMIC TILE AREAS.
PROVIDE 1 ROW BRIDGING FOR SPANS OF 5'-7", 2 ROWS FOR SPANS GREATER THAN 7'


ALL SUBFLOORS TO BE 5/8" PLYWOOD AND TO BE GLUED AND NAILED ON THIS FLOOR.


FILE NAME: ZADORRA LOT 104 NOV 9 23
BM/NOV 9 23

*UPG 2 HAMPTON
THROUGHOUT KITCHEN

*UP2 HARDWARE

* LIGHT VALANCE THROUGHOUT KITCHEN ONLY

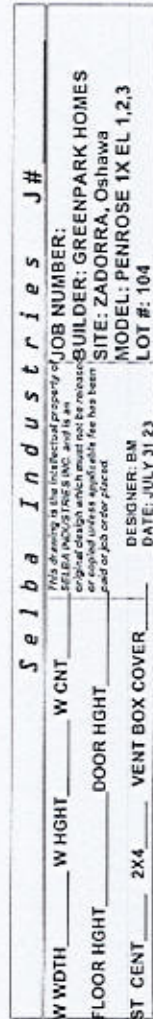


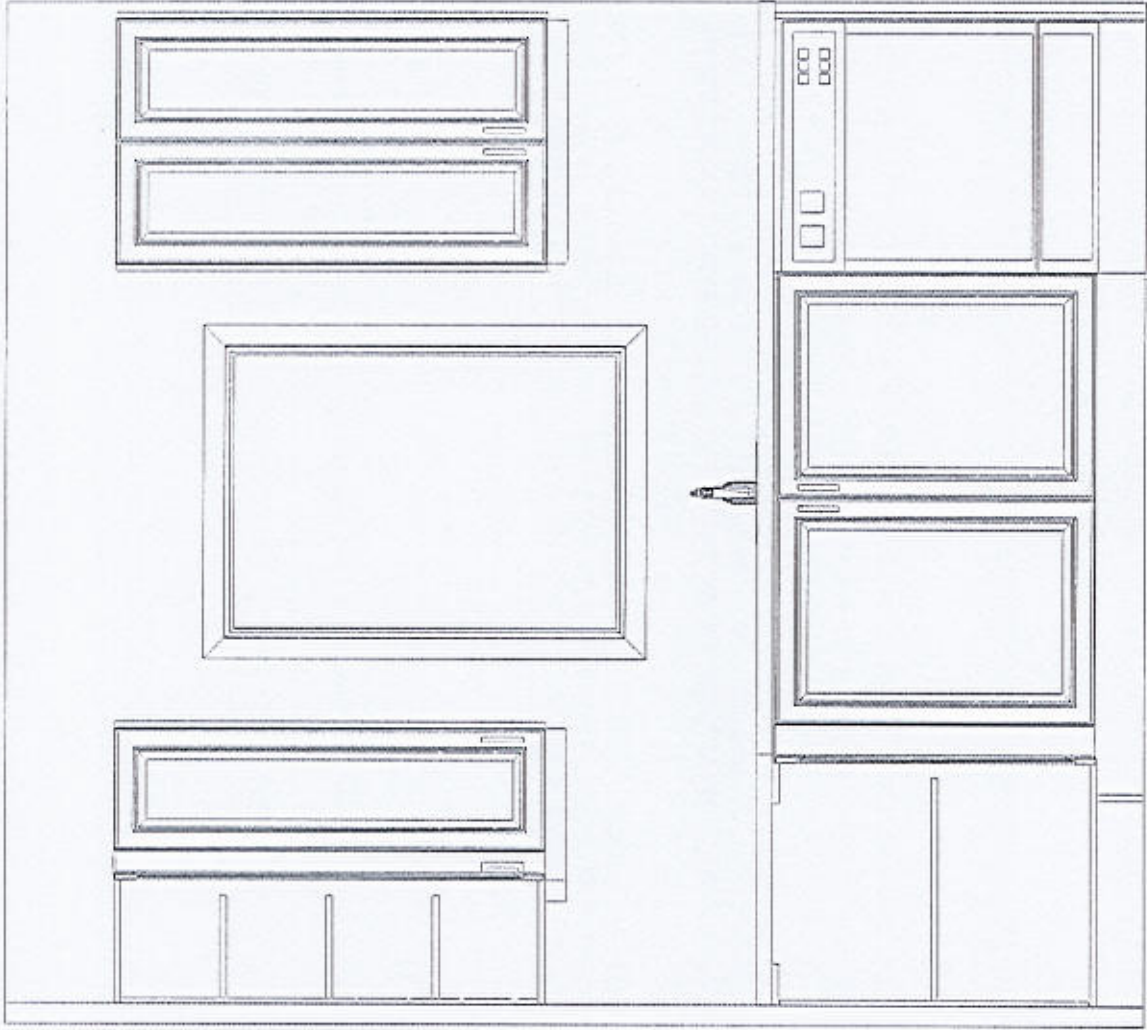

This drawing is the intellectual property of
SELBA INDUSTRIES INC. and is an
artistic
interpretation of the general
appearance of the design. It is
not meant to be an exact rendition.



Designed: 11/8/2023
Printed: 11/9/2023

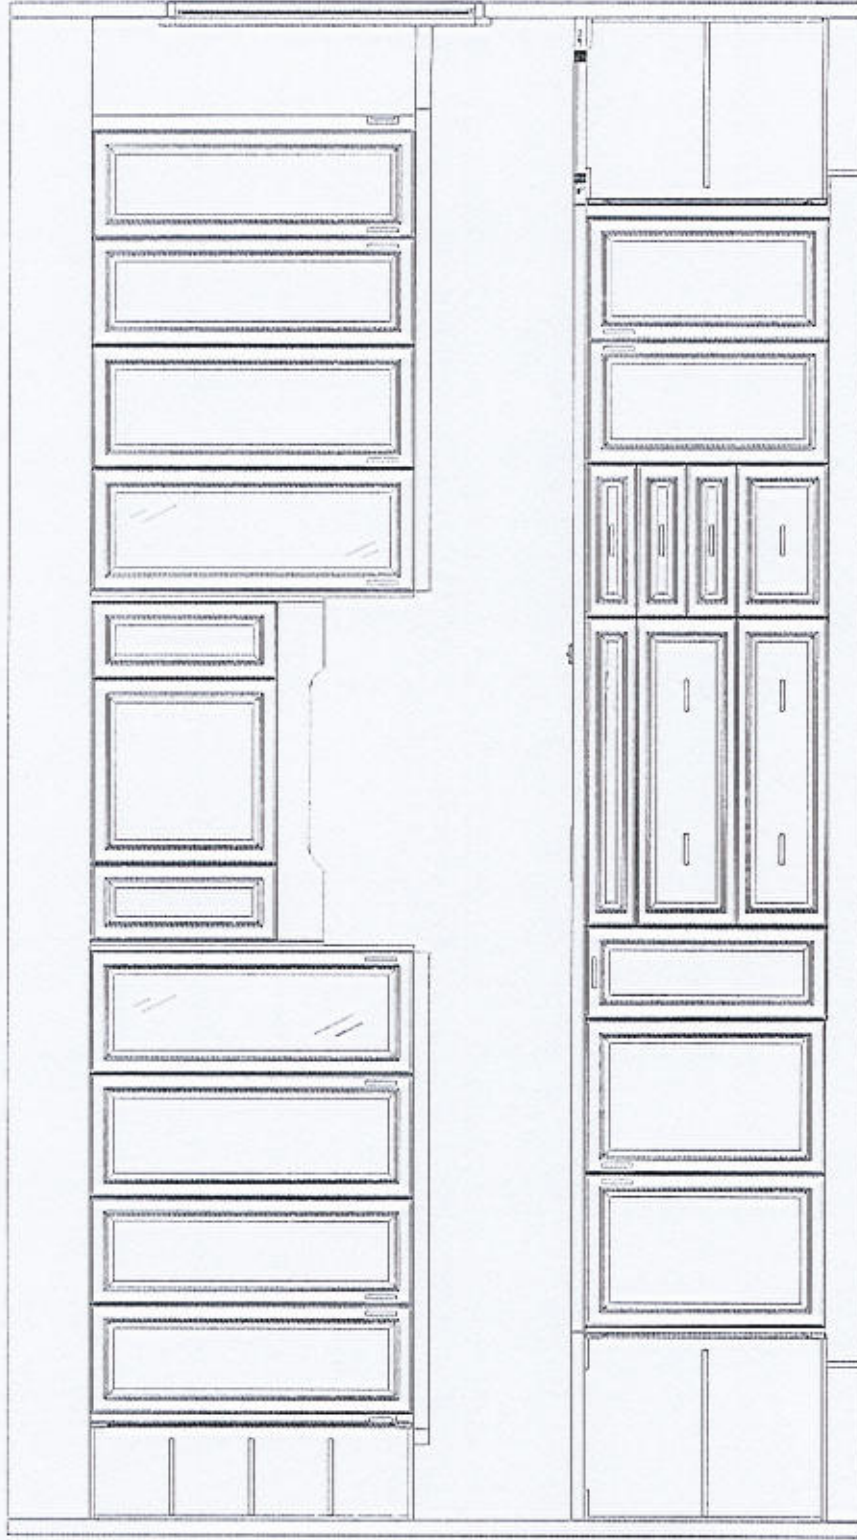

This drawing is the intellectual property of
SELBA INDUSTRIES INC. and is an
artistic
interpretation of the general
appearance of the design. It is
not meant to be an exact rendition.




Designed: 11/8/2023
Printed: 11/9/2023

ZADORRA LOT 104 NOV 9 23

LAYOUT

Drawing #: 1

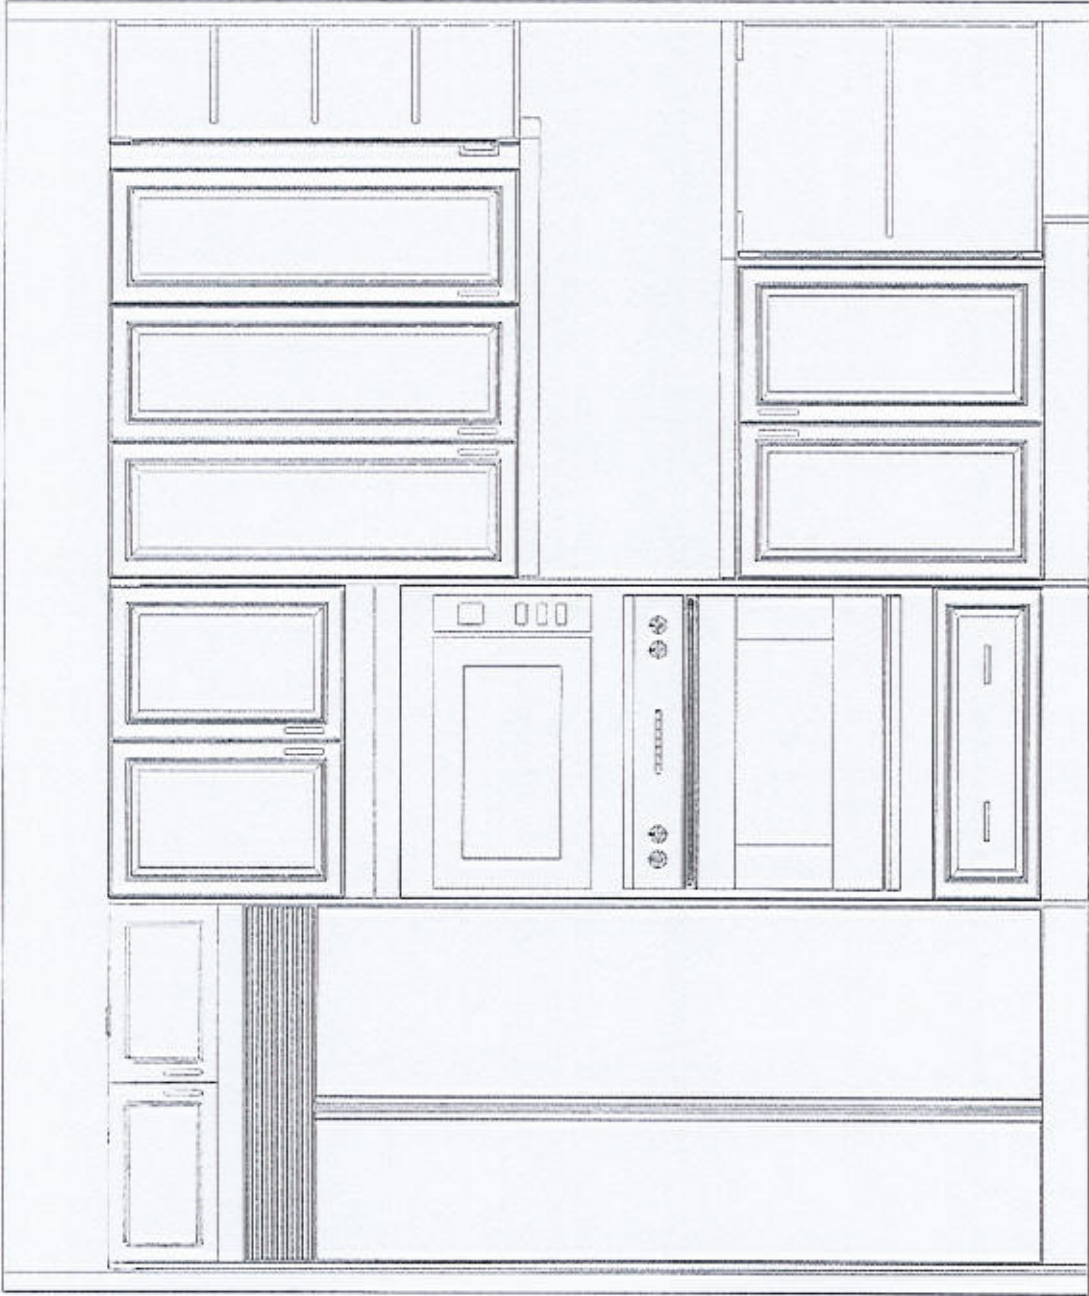

Designed: 11/9/2023
Printed: 11/9/2023




Küchen + Bath Designs

This drawing is the intellectual property of
SELBA INDUSTRIES INC. and is an
artistic
interpretation of the general
appearance of the design. It is
not meant to be an exact rendition.


ZADORRA LOT 104 NOV 9 23

LAYOUT


Drawing #: 1

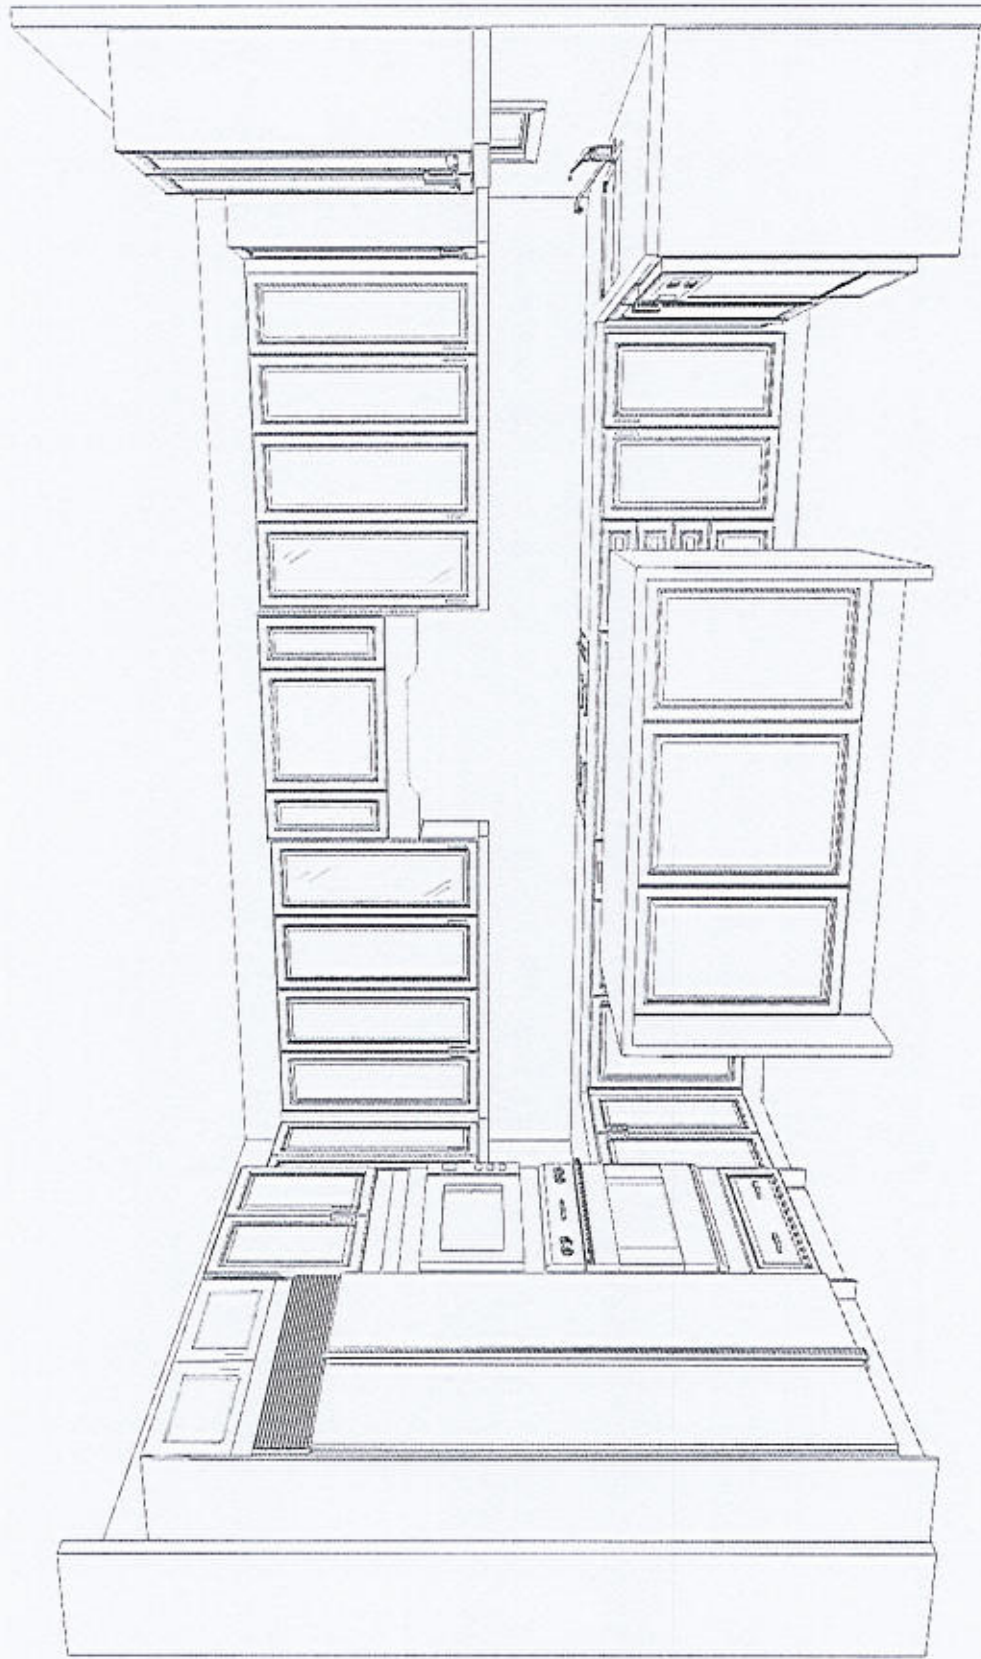

This drawing is the intellectual property of SELBA INDUSTRIES INC. and is an artistic interpretation of the general appearance of the design. It is not meant to be an exact rendition.	 Kitchen + Bath Designs	Designed: 11/9/2023 Printed: 11/9/2023
		LAYOUT
ZADORRA LOT 104 NOV 9 23		Drawing #: 1

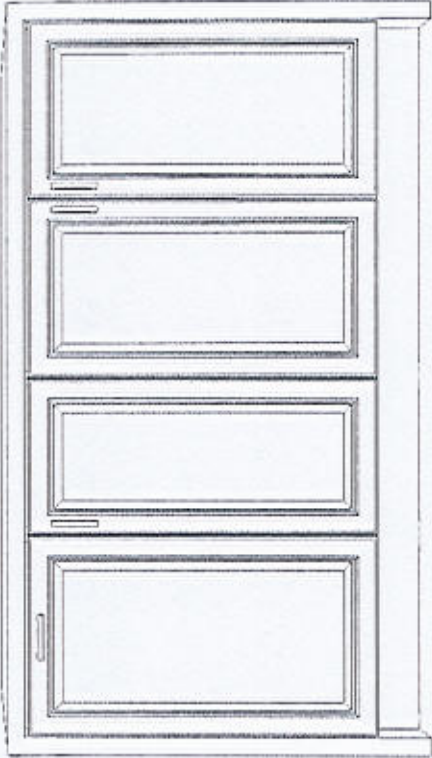

This drawing is the intellectual property of SELBA INDUSTRIES INC. and is an artistic interpretation of the general appearance of the design. It is not meant to be an exact rendition.	 Kitchen • Bath Designs	Designed: 11/8/2023 Printed: 11/9/2023
		LAYOUT
ZADORRA LOT 104 NOV 9 23		Drawing #: 1

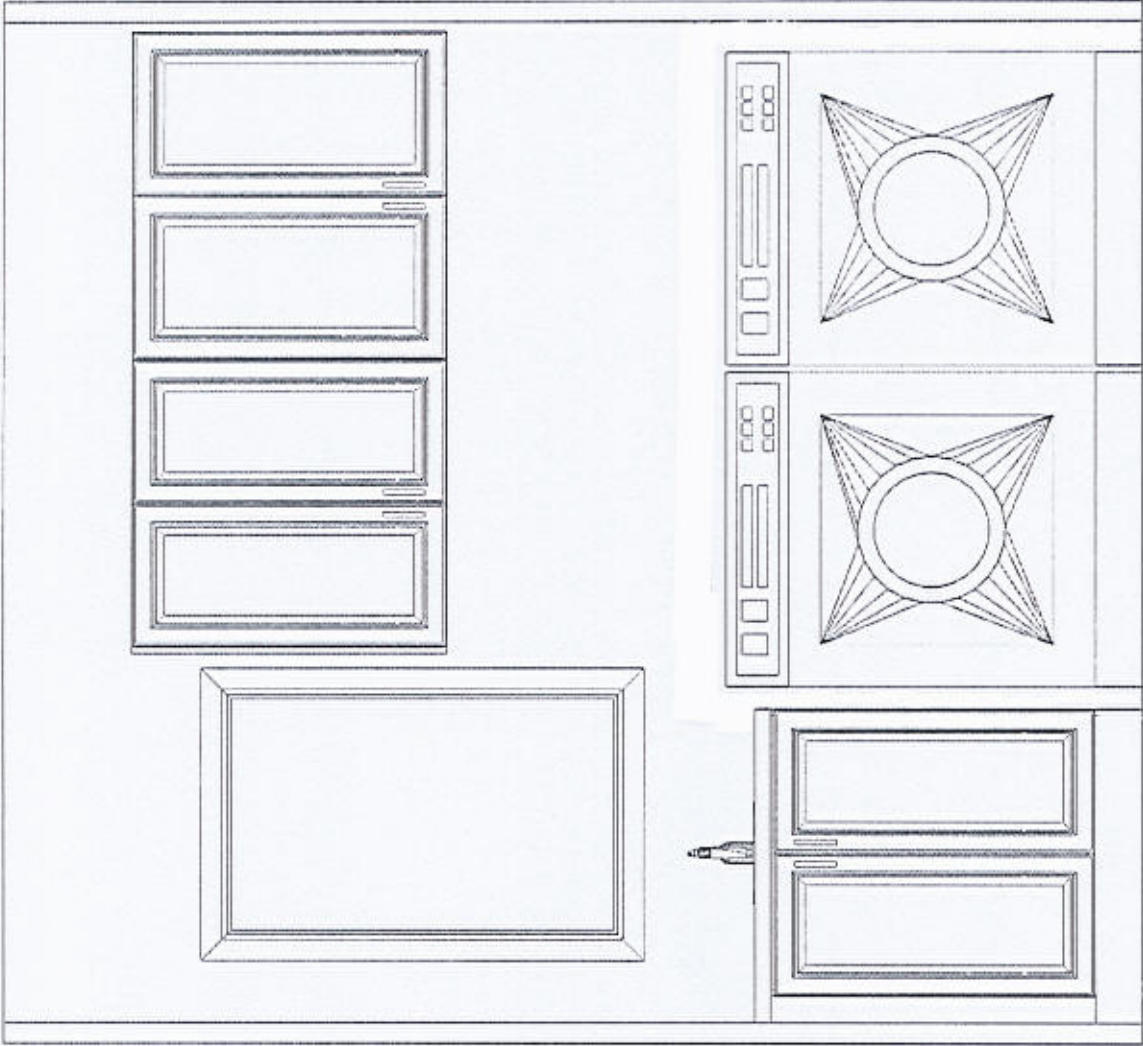

This drawing is the intellectual property of
SELBA INDUSTRIES INC. and is an
artistic
interpretation of the general
appearance of the design. It is
not meant to be an exact rendition.



Kitchen • Bath Designs



Designed: 11/8/2023
Printed: 11/9/2023

ZADORRA LOT 104 NOV 9 23

LAYOUT

Drawing #: 1

AEQUALITAS III

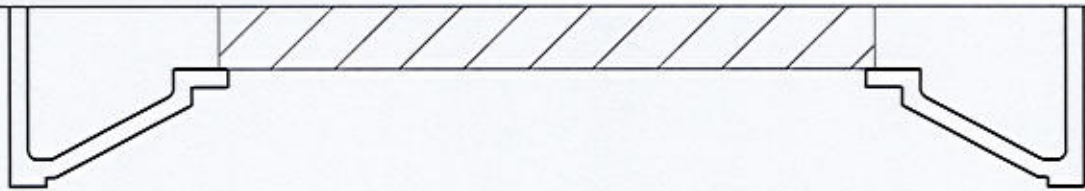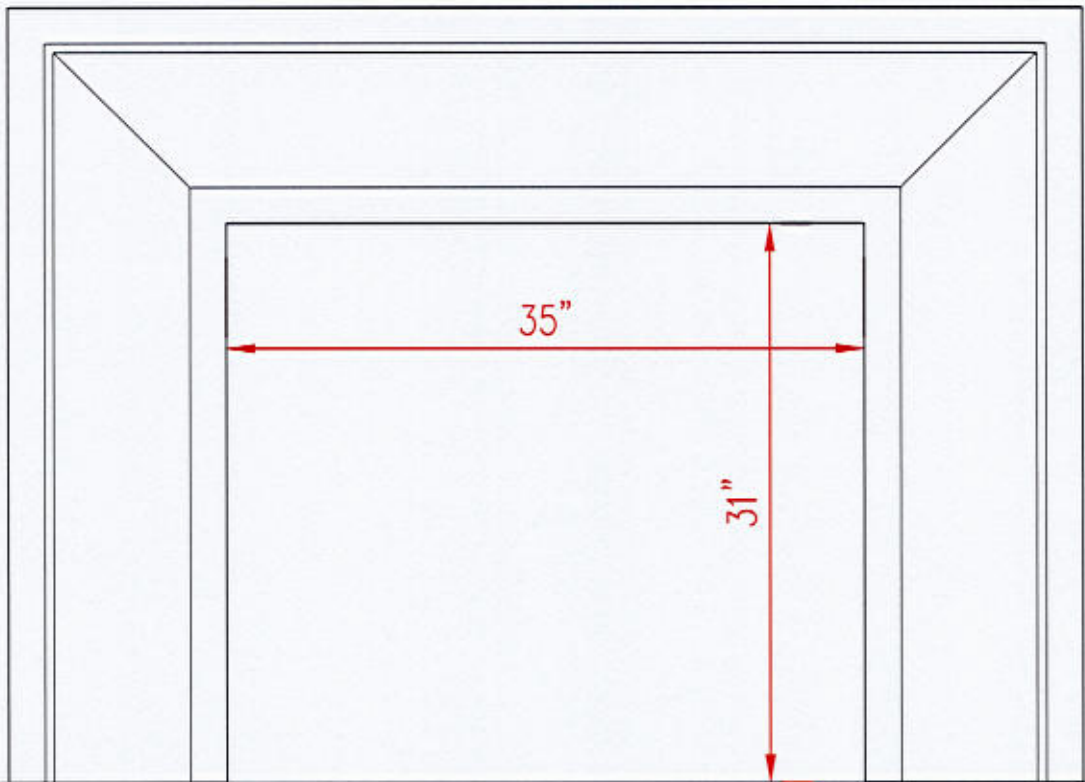



Model: 9126SRS

Kurv Spot Resist Stainless One-Handle High Arc Pulldown Kitchen Faucet

Inspired by natural shapes and organic forms, the KURV pulldown faucet outfits your kitchen with a versatile design to fit any style. The dramatic receptor compliments a tapered handle and flared wand for a simple, yet eye-catching, elegance. Curved lines and a fluid, flowing overall style complete KURV’s design.

Where to Buy



**Kurv Spot Resist Stainless
One-Handle High Arc
Pulldown Kitchen Faucet**

GALLERY 

Where to Buy



Model: T6905BN

Voss Brushed Nickel Two-Handle High Arc Bathroom Faucet

Crisp edges and uncomplicated style features give the Voss collection an ageless, yet fashion-forward, presence. Each silhouette brings a confident Transitional style to the bath.

Where to Buy



Required for Installation

Valve

Valve

Valve

Valve



Voss Brushed Nickel Two-Handle High Arc Bathroom Faucet

GALLERY 

Where to Buy



Model: T693BN

Voss Brushed Nickel Two-Handle High Arc Roman Tub Faucet

Crisp edges and uncomplicated style features give the Voss collection an ageless, yet fashion-forward, presence. Each silhouette brings a confident Transitional style to the bath.

Where to Buy



Required for Installation

Valve

Valve

Valve

Please select 



Model: T2692BN

Voss Brushed Nickel Posi-Temp® Shower Only

Crisp edges and uncomplicated style features give the Voss collection an ageless, yet fashion-forward, presence. Each silhouette brings a confident Transitional style to the bath.

Where to Buy



Required for Installation

Valve

Valve

Please select 



Model: T2693BN

Voss Brushed Nickel Posi-Temp® Tub/Shower

Crisp edges and uncomplicated style features give the Voss collection an ageless, yet fashion-forward, presence. Each silhouette brings a confident Transitional style to the bath.

Where to Buy



Required for Installation

Valve

Valve

Please select 