

CONSTRUCTION SUMMARY				
Legacy Hill - Trinigroup Development Inc.				
PURCHASER: Jing WANG			RECEIVED DEC 21 2023	TEL:
LOT / PHASE 47 / 1	REG. PLAN #	HOUSE TYPE Villa 6 Elev 2		

CONSTRUCTION


1 - ENLARGED BASEMENT WINDOWS (MAY REQUIRE WINDOW WELLS) - WINDOW IS 30 INCHES X 24 INCHES 21Dec23 Note:	
1 - LOWER LEVEL - BASEMENT 8 FOOT 6 INCH CONCRETE POUR - MEASURED FROM TOP OF FOOTING TO TOP OF FOUNDATION WALL 21Dec23 Note:	
1 - FIRST FLOOR INCREASE CEILING HEIGHT FROM 9 FEET TO 10 FEET 21Dec23 Note:	

PROMOTIONAL

1 - LESS CREDIT FROM PURCHASER EXTRA SHEET IN OFFER 21Dec23 Note:	
--	--


This Document is Extremely Time Sensitive - Printed 21 Dec 23 at 11:21

LOT #47


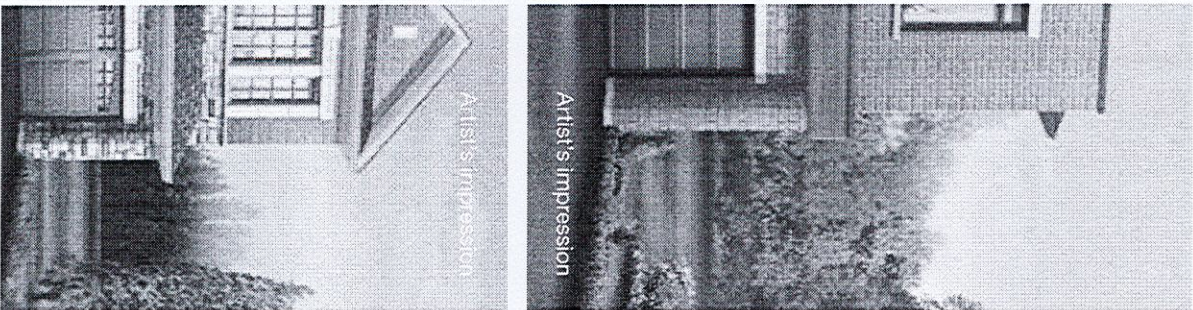


Villa 6 36' Lot

Elev. 1: 3,038 sq.ft. Elev. 2: 3,047 sq.ft. Elev. 3: 3,047 sq.ft.

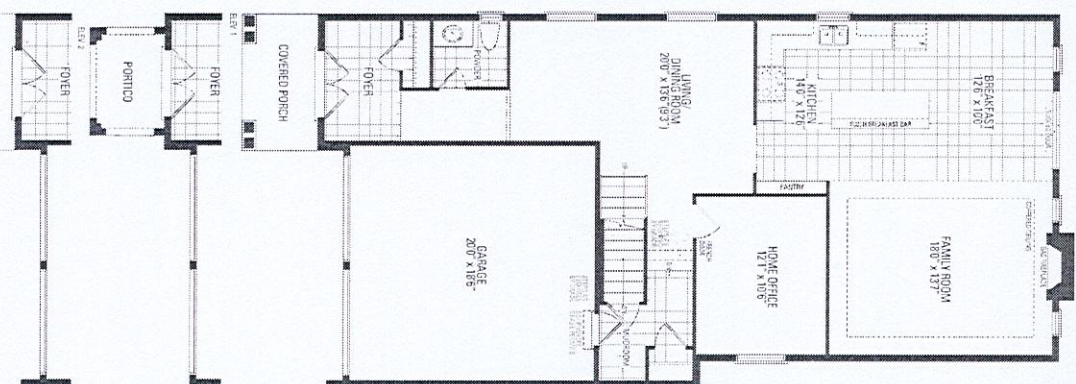

Enlarge
window

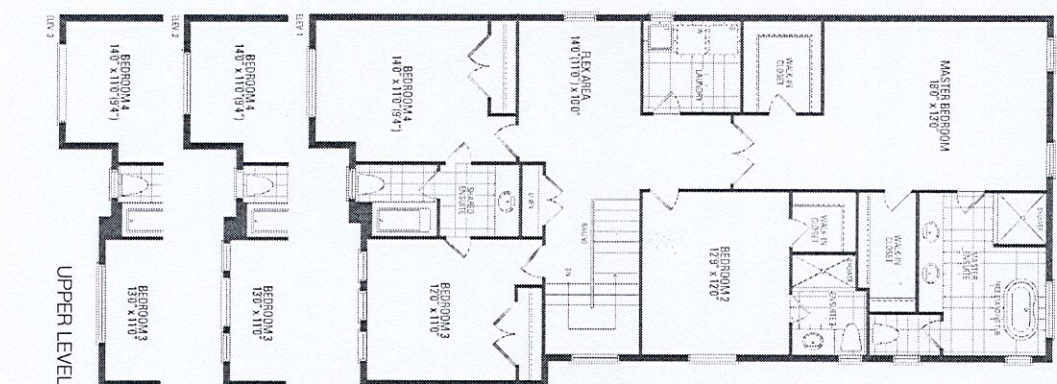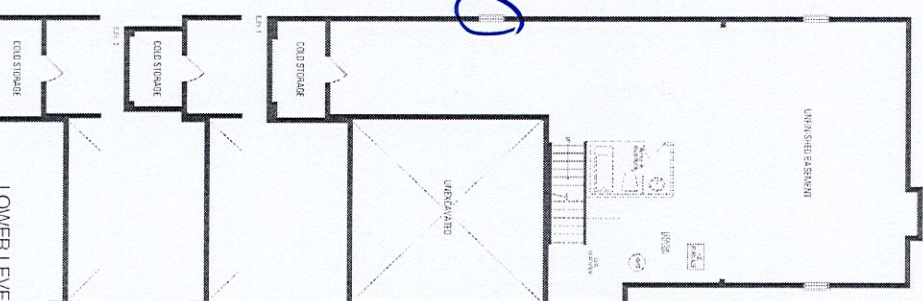

*10' ceiling height - 1st floor

*8'-6" concrete pour

LOWER LEVEL

UPPER LEVEL