

★ Cons-gas line
r/i for stove added

CONSTRUCTION SUMMARY - PARTIAL ONLY
Palmetto - Zadorra Estates Corp.

PURCHASERS: Akinola Solomon OGUNNUBI and Ogochukwu Elizabeth CHUKWUMA TEL: RES.: 705-350-1521

LOT NUMBER	PHASE	HOUSE TYPE	REG. PLAN #		
10	1	River 1 Elev 1	40M-2763		
INV#	QTY	EXTRA / CHANGE			

Offer	Note:
-------	-------

FIREPLACE AND ACCESSORIES

29,677 19Mar24	1 - GAS LINE ROUGH-IN FOR STOVE (INCLUDES ELECTRICAL OUTLET) - FIRST FLOOR Note:
-------------------	---

New ★


This Document is Extremely Time Sensitive - Printed 19 Mar 24 at 16:56

Cons

RECEIVED
MAR 20 2024

River 1 30' LOT

INCLUDES 18 SQ. FT. OF OPEN AREA

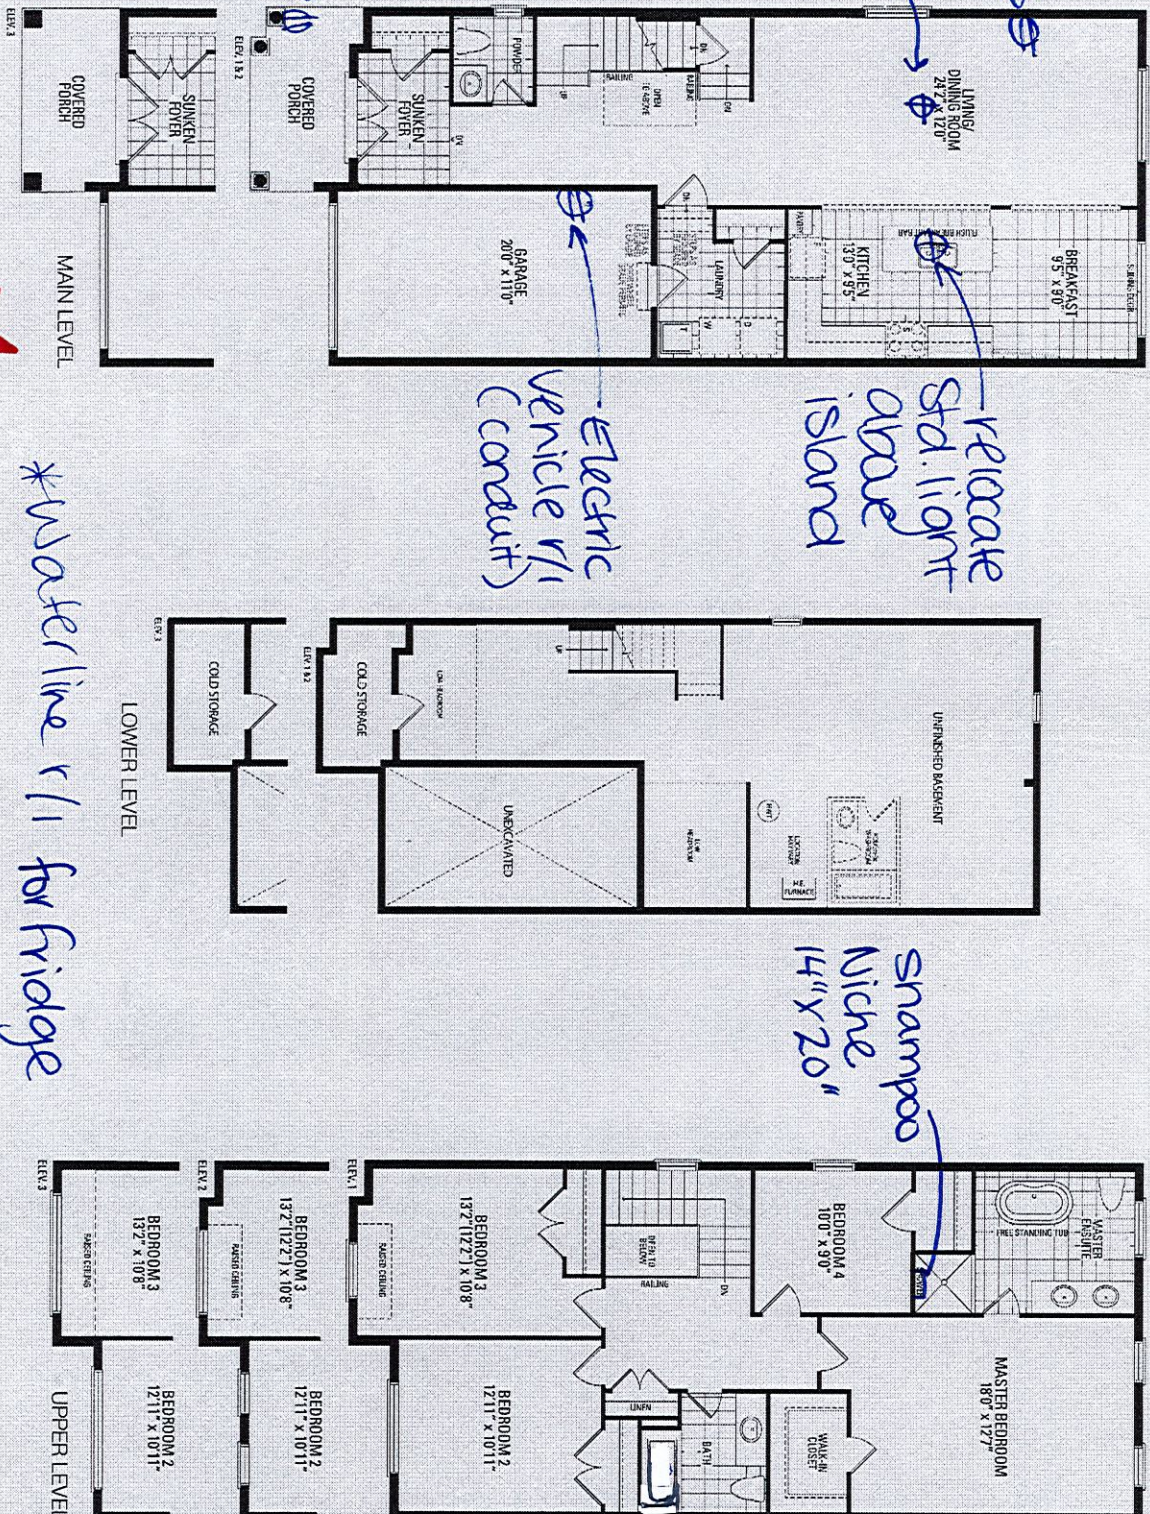

Orientation of home may be reversed and purchaser agrees to accept the same. Steps and porches may vary at any exterior entrance ways due to grading variance. Actual usable floor space may vary from the stated floor areas. All renderings are artist's concept. Dimensions, specifications and architectural detailing subject to modifications. Roofline and adjoining model types may vary due to siting. E. & O. E. May 2023