

CONSTRUCTION SUMMARY				
Palmetto - Zadorra Estates Corp.				
PURCHASERS: Kishore Kumar SENGUTTUVAN and Vandana THANIGAIVEL			RECEIVED APR 05 2024 TEL: RES.: 647-549-5559	
LOT / PHASE 161 / 1	REG. PLAN # 40M-2763	HOUSE TYPE Villa 7 Elev 3		

CABINETRY

1 - KITCHEN - RELOCATE FRIDGE TO END OF STOVE WALL TO ACCOMMODATE BUILT INS 03Apr24 Note:	
1 - CABINETRY - POWDER ROOM HARDWARE - UPGRADE 1 03Apr24 Note:	
1 - CABINETRY - MASTER ENSUITE HARDWARE - UPGRADE 1 03Apr24 Note:	
1 - CABINETRY - KITCHEN - HARDWARE UPGRADE 1 03Apr24 Note: #234SB WITH APPOX. 8" LONG MATCHING PULL ON pot drawers / large drawers	
HARDWARE CODES AS PER PAULINE	
1 - POWDER ROOM - FLOATING VANITY - SUSPENDED VANITY PROVISION 03Apr24 Note:	
1 - CABINETRY - POWDER ROOM VANITY - UPGRADE 3 03Apr24 Note:	
1 - CABINETRY - MASTER ENSUITE VANITY - UPGRADE 3 03Apr24 Note:	
1 - CABINETRY - MASTER ENSUITE RAISE VANITY TO 36" HIGH VANITY IN LIEU OF STANDARD HEIGHT 03Apr24 Note:	
1 - KITCHEN - DELETE CABINETS ABOVE STOVE AND HOOD FAN - VENDOR WILL SUPPLY 6 INCH VENT AS PER CONSTRUCTION SPECIFICATIONS AND VENT MAY NOT BE IN THE APPROPRIATE LOCATION FOR INSTALLATION OF PURCHASER SUPPLIED FAN 03Apr24 Note: PURCHASER TO SUPPLY AND INSTALL OWN FAN AFTER CLOSING	
1 - KITCHEN - SOFT CLOSE DOORS AND DRAWERS 03Apr24 Note:	
1 - CABINETRY - KITCHEN - UPGRADE 2 03Apr24 Note:	

CABINETRY ACCESSORIES

1 - KITCHEN CABINETRY BASE - PULLOUT WIRE SPICE RACK - PRICE IS EACH 03Apr24 Note:	
1 - KITCHEN CABINETRY UPPER - COUNTER TOP HUTCH SINGLE DOOR WITH DRAWER - PRICE IS EACH - UPGRADE 2 - NEXT TO BUILT IN TOWER 03Apr24 Note:	
1 - KITCHEN CABINETRY - BUILT-IN MICROWAVE/OVEN COMBO WITH ONE POT DRAWER - UPGRADE 2 03Apr24 Note:	
1 - KITCHEN CABINETRY BASE - COOKTOP CABINET WITH POT DRAWERS (2 DRAWERS) - UPGRADE 2 03Apr24 Note:	
1 - KITCHEN CABINETRY UPPER - FULL DEPTH ABOVE FRIDGE UPPER WITH GABLES - 650MM DEEP - PRICE IS EACH 03Apr24 Note:	
1 - KITCHEN CABINETRY ACCESSORIES - TOUCH LATCHES FOR DOORS ONLY WHERE APPLICABLE 03Apr24 Note: PIE CUT CABINET AND BLIND CORNERS NOT POSSIBLE	

CONSTRUCTION SUMMARY				
Palmetto - Zadorra Estates Corp.				
PURCHASERS: Kishore Kumar SENGUTTUVAN and Vandana THANIGAIVEL			TEL: RES.: 647-549-5559	
LOT / PHASE	REG. PLAN #	HOUSE TYPE		
161 / 1	40M-2763	Villa 7 Elev 3		
1 - KITCHEN CABINETRY BASE - PIE CUT CORNER CABINET - BASE CABINETRY - UPGRADE 2				
03Apr24 Note:				
1 - KITCHEN CABINETRY UPPER - ANGLED CORNER CABINET - FITS TALL UPPER CABINETS - PER UNIT - UPGRADE 2				
03Apr24 Note:				

CERAMIC TILE

1 - GROUT COLOUR - UPGRADE GROUT COLOUR THROUGHOUT - FLAT FEE	
03Apr24 Note:	
1 - TILE - UPGRADE 4 WALL TILE - MASTER ENSUITE WALL - SHOWER	
03Apr24 Note:	
1 - TILE - UPGRADE 4 FLOOR TILE - MASTER ENSUITE FLOOR	
03Apr24 Note:	
1 - TILE - UPGRADE 1 WALL TILE - BEDROOM 4 ENSUITE WALL - SHOWER	
03Apr24 Note:	
1 - TILE - UPGRADE 1 FLOOR TILE - BEDROOM 4 ENSUITE FLOOR	
03Apr24 Note:	
1 - TILE - UPGRADE 1 WALL TILE - BEDROOM 2/3 SHARED ENSUITE WALL - TUB	
03Apr24 Note:	
1 - TILE - UPGRADE 1 FLOOR TILE - BEDROOM 2/3 SHARED ENSUITE FLOOR	
03Apr24 Note:	
1 - DELETE ALL CERAMIC BATHROOM ACCESSORIES - DELETE TOWEL BAR, PAPER HOLDER & SOAP DISH THROUGHOUT	
03Apr24 Note:	
1 - TILE - UPGRADE 4 FLOOR TILE - LAUNDRY ROOM	
03Apr24 Note:	
1 - TILE - UPGRADE 4 FLOOR TILE - POWDER ROOM	
03Apr24 Note:	
1 - TILE - UPGRADE 4 FLOOR TILE - KITCHEN/BREAKFAST AREA	
03Apr24 Note:	
1 - TILE - UPGRADE 4 FLOOR TILE - GARAGE ENTRANCE/MUD ROOM	
03Apr24 Note:	
1 - TILE - UPGRADE 4 FLOOR TILE - FOYER	
03Apr24 Note:	

CONSTRUCTION

1 - KITCHEN - RELOCATE FRIDGE TO END OF STOVE WALL TO ACCOMMODATE BUILT INS	
03Apr24 Note:	
1 - PROVISION FOR SHAMPOO NICHE APPROX. 14” WIDE X 20” HIGH AS PER SKETCH – IF CONSTRUCTION PERMITS	
ENSUITE 4	
01Nov23 Note:	

CONSTRUCTION SUMMARY				
Palmetto - Zadorra Estates Corp.				
PURCHASERS: Kishore Kumar SENGUTTUVAN and Vandana THANIGAIVEL			TEL: RES.: 647-549-5559	
LOT / PHASE 161 / 1	REG. PLAN # 40M-2763	HOUSE TYPE Villa 7 Elev 3		
1 - FAMILY ROOM - WAFFLE CEILING - SEE SKETCH 01Nov23 Note:				
1 - PRIMARY ENSUITE - PROVISION FOR SHAMPOO NICHE APPROX. 14" WIDE X 20" HIGH AS PER SKETCH – IF CONSTRUCTION PERMITS 01Nov23 Note:				
1 - SMOOTH CEILINGS ON FIRST FLOOR 01Nov23 Note:				

COUNTER TOP

4 - VANITY - ADD 3" BACKSPLASH RETURN ALL WASHROOMS 03Apr24 Note:	
1 - BEDROOM 2/3 SHARED ENSUITE COUNTER TOP - UPGRADE STONE COUNTER TOP 03Apr24 Note:	
1 - BEDROOM 4 ENSUITE COUNTER TOP - UPGRADE STONE COUNTER TOP 03Apr24 Note:	
1 - POWDER ROOM COUNTER TOP - UPGRADE STONE COUNTER TOP 03Apr24 Note:	
1 - MASTER ENSUITE COUNTER TOP - UPGRADE STONE COUNTER TOP 03Apr24 Note:	
1 - KITCHEN BACKSPLASH EXTRA AREA FOR QUARTZ BACKSPLASH - EXTRA AREA BEHIND CHIMNEY HOOD FAN TO CEILING - FOR 9 FOOT CEILING 03Apr24 Note:	
1 - KITCHEN BACKSPLASH FULL HEIGHT - UPGRADE STONE COUNTER TOP 03Apr24 Note: DOES NOT INCLUDE AREA BEHIND CHIMNEY HOOD TO CEILING	
1 - KITCHEN COUNTER TOP - UPGRADE STONE COUNTER TOP 03Apr24 Note:	
2 - PRIMARY ENSUITE - SHAMPOO NICHE 14" WIDE X 20" HIGH AS PER SKETCH – MARBLE, GRANITE OR QUARTZ – IF CONSTRUCTION PERMITS - REQUIRES PROVISION FROM CONSTRUCTION PRIMARY ENSUITE & ENSUITE 4 01Nov23 Note: SUPPLY & INSTALL	

DOORS AND TRIM

1 - TRIM - 7 1/4 INCH BASEBOARD AND 3 1/4 INCH BB CASING - STEP 03Apr24 Note:	
---	--

ELECTRICAL

1 - FAMILY ROOM - PLUG - ELECTRICAL PLUG 5FT FROM FLOOR FOR FUTURE TV - SEE SKETCH 03Apr24 Note:	
1 - BUILT IN OVEN AND COOKTOP PROVISION - PROVISION ONLY - ELECTRICAL ONLY 03Apr24 Note:	

CONSTRUCTION SUMMARY				
Palmetto - Zadorra Estates Corp.				
PURCHASERS: Kishore Kumar SENGUTTUVAN and Vandana THANIGAIVEL			TEL: RES.: 647-549-5559	
LOT / PHASE	REG. PLAN #	HOUSE TYPE		
161 / 1	40M-2763	Villa 7 Elev 3		
1 - ELECTRIC VEHICLE ROUGH-IN PROVISION ONLY FOR FUTURE ELECTRIC CAR (CONDUIT FROM BASEMENT INTO JUNCTION BOX IN GARAGE WITH PULL STRING, NO WIRE)				
01Nov23 Note:				
1 - FAMILY ROOM - ADD LIGHT AND SWITCH - NO FIXTURE INCLUDED				
01Nov23 Note:				
1 - PLUG - ELECTRICAL PLUG - TO BE INSTALLED OVER FIREPLACE				
01Nov23 Note:				
1 - ABOVE KITCHEN ISLAND - ADD LIGHT AND SWITCH - NO FIXTURE INCLUDED				
01Nov23 Note:				
FIREPLACE AND ACCESSORIES				
1 - GAS LINE ROUGH-IN FOR STOVE (INCLUDES ELECTRICAL OUTLET) - FIRST FLOOR				
01Nov23 Note:				
HARDWOOD FLOORING				
1 - LAMINATE – UPGRADE TO PARKLANE SERIES IN LIEU OF STANDARD LAMINATE				
03Apr24 Note:				
1 - HARDWOOD - GROUP A SERIES 5 INCH - FIRST FLOOR HARDWOOD AREAS INCLUDING STAIR LANDINGS				
03Apr24 Note:				
MIRRORS AND GLASS				
1 - SHOWER DOOR HANDLE - D-RING/TOWEL BAR COMBO - MATTE BLACK FINISH				
03Apr24 Note: INCLUDES CLIPS IN MATTE BLACK FINISH				
1 - REMOVE VANITY MIRRORS AS PER PURCHASER REQUEST - DO NOT SUPPLY OR INSTALL				
MASTER ENSUITE & POWDER ROOM				
03Apr24 Note:				
1 - MASTER ENSUITE - FRAMELESS GLASS SHOWER DOOR FOR 5 FOOT PAN				
03Apr24 Note:				
MISCELLANEOUS				
1 - FURTHER VENDOR DISCOUNT				
03Apr24 Note:				
PAINTING				
1 - PAINT PACKAGE - UPGRADE TRIM PAINT PACKAGE COLOUR TO WHITE INCLUDING BASEBOARDS, TRIMS, DOORS & FIREPLACE				
03Apr24 Note:				
PLASTER MOULDINGS				
1 - FOYER/MAIN HALL/ MUDROOM WHERE APPLIC.				
03Apr24 Note:				
1 - DINING ROOM - CORNICE MOLDING				
03Apr24 Note:				

CONSTRUCTION SUMMARY				
Palmetto - Zadorra Estates Corp.				
PURCHASERS: Kishore Kumar SENGUTTUVAN and Vandana THANIGAIVEL			TEL: RES.: 647-549-5559	
LOT / PHASE 161 / 1	REG. PLAN # 40M-2763	HOUSE TYPE Villa 7 Elev 3		
1 - KITCHEN/BREAKFAST - CORNICE MOLDING 03Apr24 Note:				

PLUMBING

1 - POWDER ROOM - MOEN RIZON CHROME ONE-HANDLE HIGH ARC VESSEL BATHROOM FAUCET 03Apr24 Note:	
1 - POWDER ROOM - PROVISION FOR FLOATING VANITY 03Apr24 Note:	
2 - MASTER ENSUITE - SINK - UNDERMOUNT SINK - CONTRAC COLLETTE #4220CIY 03Apr24 Note:	
3 - ENSUITE 2/3 & ENSUITE 4 - SINK - UNDERMOUNT SINK - TECO BATH #4815 03Apr24 Note:	
1 - POWDER ROOM - SINK - VESSEL SINK - AVENUE SQUARE 13-1517A-W 03Apr24 Note:	
1 - SINK - UNDERMOUNT SINK - TECO KITCHEN #170 03Apr24 Note:	
1 - KITCHEN - MOEN SOAP DISPENSER - MOEN TRANSITIONAL #3944 - CHROME INSTALL LEFT SIDE OF SINK FAUCET 03Apr24 Note:	
2 - TOE TESTER - ADD TOE TESTER TO SHOWER PRIMARY ENSUITE & ENSUITE 4 01Nov23 Note:	
1 - WATER LINE FOR FRIDGE - ROUGH-IN ONLY 01Nov23 Note:	
1 - ENSUITE 2/3 - TUB TO SHOWER CONVERSION - 5 FOOT SHOWER WITH SLIDING GLASS CHROME DOORS IN LIEU OF TUB INCLUDES SHOWER POT LIGHT 01Nov23 Note:	

PROMOTIONAL

1 - LESS CREDIT FROM PURCHASER EXTRA SHEET IN OFFER 01Nov23 Note:	
---	--

STAIRS AND RAILINGS

1 - PICKETS - EUROLINE 1 - BLACK PICKETS 03Apr24 Note:	
1 - HANDRAIL - V-GROOVE HANDRAIL 03Apr24 Note:	
1 - STAINED STAIRS - STANDARD STAIRCASE 03Apr24 Note: INCLUDING STEPS TO LOWER LANDING	

CONSTRUCTION SUMMARY

Palmetto - Zadorra Estates Corp.

PURCHASERS: Kishore Kumar SENGUTTUVAN and Vandana THANIGAIVEL

TEL: RES.: 647-549-5559

LOT / PHASE 161 / 1	REG. PLAN # 40M-2763	HOUSE TYPE Villa 7 Elev 3		
------------------------	-------------------------	------------------------------	--	--

EXTRAS AS PER OFFER

The Vendor agrees that notwithstanding any other term or provision in this Agreement included in the Purchase Price and in addition to those items detailed in Schedule GP to the Agreement of Purchase and Sale, the Purchaser is entitled to a credit of Fif <i>Worksheet</i> Note:	
--	--

This Document is Extremely Time Sensitive - Printed 3 Apr 24 at 16:15

Purchasers: Kishore Kumar SENGUTTUVAN & Vandana THA

Property: 161

Telephone Res. / Bus: (647) 549-5559 /

Project: Zadorra Estates Corp.

Decor Advisor: Ida Viola

Model and Elevation: Villa 7 Elev 3

Lock Date: 3-Apr-24

3-Apr-24

Plan #: 40M-2763

1. Cabinetry

	Style and Colour	Hardware
Kitchen / Breakfast	ARUBA 723 JET BLACK	See Below
Laundry Room	ELISSE	Standard
Powder Room	SENOSA N 8421 BLACK	234SB
Master Ensuite Bathroom	SENOSA N 8421 BLACK	234SB
Ensuite Bath - Bedroom 2/3	MONACO 904 INK	464SA
Ensuite Bath - Bedroom 4	MONACO 904 INK	464SA
Stove Opening	36"	NOTE: If not specified, opening will be set to builder's standard opening of approximately 30" width
Fridge Opening		NOTE: If not specified, opening will be set to builder's standard opening of approximately 37" width x 74" height

** Refer to Construction Summary KITCHEN HARDWARE ON BANK OF DRAWERS # 234SB & MATCHING APPOX.8" LONG PULL ON POT DRAWERS – BASE PIE CUT CABINET HARDWARE - #234SB

2. Counters

	Counter	Edge	Niche
Kitchen / Breakfast	QUARTZ - ETESIA 5U5	#360 EDGE	
Laundry Room	N/A		
Powder Room	QUARTZ-NERO STARDUST T603	#360 EDGE	
Master Ensuite Bathroom	QUARTZ-NERO STARDUST T603	#360 EDGE	NERO STARDUST T603
Ensuite Bath - Bedroom 2/3	QUARTZ-NERO STARDUST T603	#360 EDGE	
Ensuite Bath - Bedroom 4	QUARTZ-NERO STARDUST T603	#360 EDGE	NERO STARDUST T603
Kitchen Backsplash	QUARTZ-MISTRAL FULL HEIGHT		

** Refer to Construction Summary ALL BATHROOM COUNTERS TO HAVE 3" BACKSPLASH

Initials:

SV

KJ

Purchasers: Kishore Kumar SENGUTTUVAN & Vandana THAProperty: 161

Telephone Res. / Bus: (647) 549-5559 / Project: Zadorra Estates Corp.

Decor Advisor: Ida Viola Model and Elevation: Villa 7 Elev 3

Lock Date: 3-Apr-24 3-Apr-24 Plan #: 40M-2763

3. Ceramic Flooring

At a 45

Entrance Vestibule	TILE-DOZZA WHITE 24X24	☐
Main Hall	HARDWOOD	☐
Kitchen / Breakfast	TILE-DOZZA WHITE 24X24	☐
Laundry Room	TILE-DOZZA WHITE 24X24	☐
Powder Room	TILE-DOZZA WHITE 24X24	☐
Master Ensuite Bathroom	TILE-B27 KAIROS GRAPHITE MATT 24X24	☐
Ensuite Bath - Bedroom 2/3	TILE-AXIS LIGHT GREY 12X24	☐
Ensuite Bath - Bedroom 4	TILE-QUARTZITE NOIR 12X24	☐
Mud Room	TILE-DOZZA WHITE 24X24	☐
		☐
		☐

** Refer to Construction Summary ** METAL STRIP THRESHOLD WHERE APPLICABLE UNLESS SPECIFIED **

GROUT - MAIN FLOOR - TITANIUM 50

MASTER ENSUITE FLOOR - 4 CHARCOAL

ENSUITE 2/3 FLOOR - 45 WINTER SKY

ENSUITE 4 FLOOR - 4 CHARCOAL

LAUNDRY - TITANIUM 50

4. Ceramic Wall Tile

Master Ensuite Bathroom	Selection	Describe
Tub Deck Wall		
Shower Stall	TILE-B27 KAIROS GREY MATT 24X24	
Bathtub Enclosure Walls		
Ensuite Bath - Bedroom 2/3	TILE-AXIS BIANCO WHITE 12X24	
Ensuite Bath - Bedroom 4	TILE-QUARTZITE GRIS CLAIR 12X24	
Mud Room	N/A	
Kitchen Backsplash	QUARTZ - MISTRAL	

** Refer to Construction Summary - GROUT - MASTER ENSUITE WALL - STANDARD SILVER

ENSUITE 2/3 WALL - TITANIUM

ENSUITE 4 WALL - STANDARD SILVER

5. Trim Carpentry

Interior Doors	CARRARA-SMOOTH
Interior Trim	3 1/4" BB CASING WITH 7 1/4" BASEBOARD - ONE STEP

** Refer to Construction Summary

6. Plaster Mouldings and Medallions

Entrance Vestibule	UP714		Kitchen/Breakfast	UP714	
Main Hall	UP714		Den/Library	N/A	
Living Room	N/A		Lower Landing	N/A	
Dining Room	UP714		Mud Room	UP714	
Family Room	WAFFLE				

** Refer to Construction Summary

Purchasers:Kishore Kumar SENGUTTUVAN & Vandana THAProperty: 161

Telephone Res. / Bus: (647) 549-5559 /Project: Zadorra Estates Corp.

Decor Advisor: Ida ViolaModel and Elevation: Villa 7 Elev 3

Lock Date: 3-Apr-243-Apr-24Plan #: 40M-2763

7. Other Flooring

Main Hall	HARDWOOD-MIRAGE GRAPHITE RED OAK EXCLUSIVE 5" CASHMERE
Living Room	N/A
Dining Room	HARDWOOD-MIRAGE GRAPHITE RED OAK EXCLUSIVE 5" CASHMERE
Family Room	HARDWOOD-MIRAGE GRAPHITE RED OAK EXCLUSIVE 5" CASHMERE
Den / Library / Study	N/A
Basement Landing(If Applies)	N/A
Lower Landing (If Applies)	HARDWOOD-MIRAGE GRAPHITE RED OAK EXCLUSIVE 5" CASHMERE
Upper Landing	HARDWOOD-MIRAGE GRAPHITE RED OAK EXCLUSIVE 5" CASHMERE
Upper Hall	LAMINATE-PARKLANE NEWCASTLE OAK DARK TL EL 3581
Master Bedroom	LAMINATE-PARKLANE NEWCASTLE OAK DARK TL EL 3581
Bedroom #2	LAMINATE-PARKLANE NEWCASTLE OAK DARK TL EL 3581
Bedroom #3	LAMINATE-PARKLANE NEWCASTLE OAK DARK TL EL 3581
Bedroom #4	LAMINATE-PARKLANE NEWCASTLE OAK DARK TL EL 3581
Bedroom #5	N/A

UnderpadStandard☐Upgrade

** Refer to Construction Summary

8. Railings and Pickets

Railing Type	V-GROOVE	Colour	MIRAGE GRAPHITE RED OAK
Picket Type	EUROLINE 1	Colour	BLACK
Stringer / Riser	AS PER CONSTRUCTION SPECIFICATIONS	Colour	MIRAGE GRAPHITE RED OAK
Treads	AS PER CONSTRUCTION SPECIFICATIONS	Colour	MIRAGE GRAPHITE RED OAK

Red Oak Stairs as Per Vendor's Standard

** Refer to Construction Summary THE STAIN COLOURS OR FINISH AVAILABLE ON RISERS, TREADS, PICKETS AND RAILS (STAIRCASES), WILL NOT BE AN EXACT MATCH TO PREFINISHED HARDWOOD OR LAMINATE FLOORS.

9. Wall Paint Flat Finish

Main & Upper Hall	22 WARM GREY	Master Bedroom	22 WARM GREY
Living Room	N/A	Bedroom #2	22 WARM GREY
Dining Room	22 WARM GREY	Bedroom #3	22 WARM GREY
Kitchen / Breakfast	22 WARM GREY	Bedroom #4	22 WARM GREY
Family Room	22 WARM GREY	Bedroom #5	N/A
Powder Room	22 WARM GREY	Master Ensuite	22 WARM GREY
Laundry Room	22 WARM GREY	Ensuite Bath - Bedroom 2/3	22 WARM GREY
Den/Library	N/A	Ensuite Bath - Bedroom 4	22 WARM GREY
Trim & Door Paint-Semi Gloss	WHITE	Mud Room	22 WARM GREY
			22 WARM GREY

** Refer to Construction Summary

Purchasers: Kishore Kumar SENGUTTUVAN & Vandana THA

Property: 161

Telephone Res. / Bus: (647) 549-5559 /

Project: Zadorra Estates Corp.

Decor Advisor: Ida Viola

Model and Elevation: Villa 7 Elev 3

Lock Date: 3-Apr-24

3-Apr-24

Plan #: 40M-2763

10. Fireplace

	Living Room			Family Room			Other Room - Specify		
	Purchased	As Per Plan	N/A	Purchased	As Per Plan	N/A	Purchased	As Per Plan	N/A
	☐	☐	☐	☐	☒	☐	☐	☐	☐
Fireplace Type				As Per Construction Specifications					
Mantle Type				MANTLE M2-STANDARD					
Colour / Stain				WHITE					
Surround				NERO					
Hearth				NO					
** Refer to Construction Summary									

11. Air Conditioning

Air Conditioning

Comment

** Refer to Construction Summary

12. General Comments

** Refer to Construction Summary

Disclaimers and Notes


1) Colours of all materials are as close as possible to builder's selection, but not necessarily identical due to variances in manufacturing.


2) Any extras listed above are null and void unless accompanied by a separate invoice/amendment. Said invoice must be paid in full.

3) The Purchaser agrees that this colour selection is final and that no changes will be permitted, unless required by the Vendor.






4) The Purchaser acknowledges reading and accepting document which contains other miscellaneous disclaimers.

5) In the event of a conflict between the Standard Features schedule of the Agreement of Purchase and Sale and the Interior Colour Scheme, the Interior Colour Scheme shall prevail.

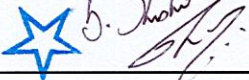
Signature:  Date: 03/04/2024

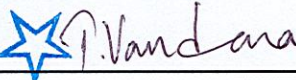Signature:  Date: 03/04/2024

Hardware on bank of
drawers - #234SB & Hutch drawer
upmatching Long pull 8" on
pot drawers below cooktop
and below built in oven.
Base pie hardware - #234SB

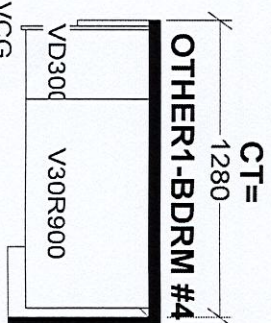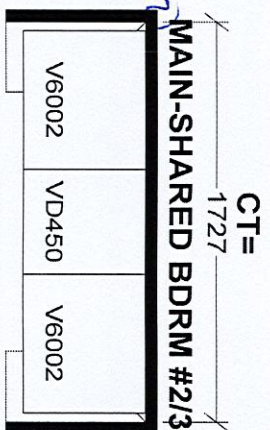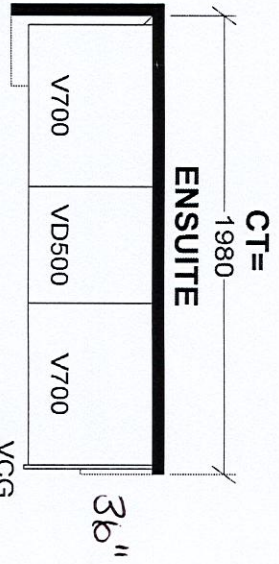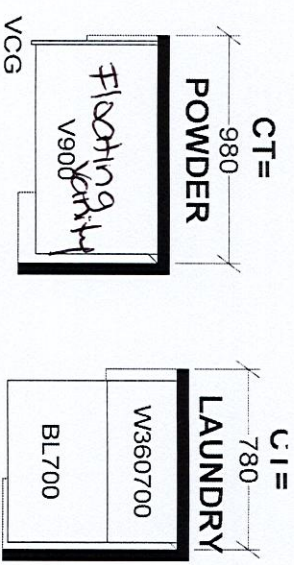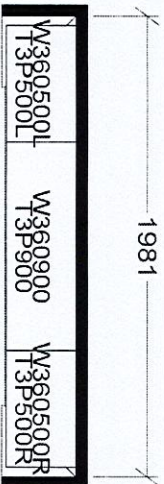

* Relocate
Fridge to
end of stove wall
to acc. Built ins.
Soft close doors
& drawers

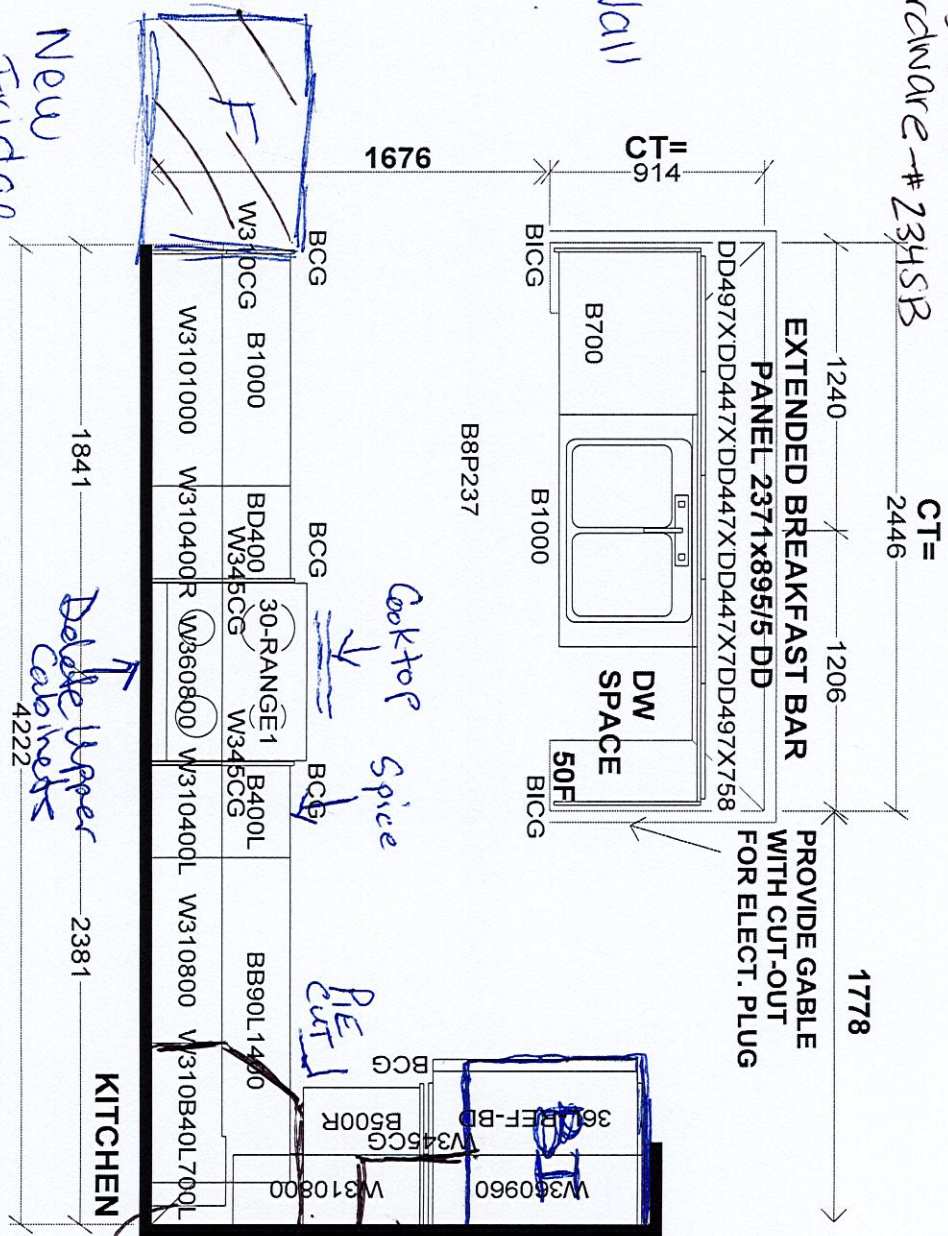

Full depth
New Fridge location




Double upper
cabinets
4222

Selba Industries				J #
W WIDTH	W HGHT	W CNT	This drawing is the intellectual property of Selba Industries Inc. and is an original design which must not be released or copied unless applicable fee has been paid or job order placed.	
FLOOR HGHT	DOOR HGHT		DESIGNER: BM	
ST CENT	2X4	VENT BOX COVER	DATE: AUG 4 23	
JOB NUMBER:			BUILDER: GREENPARK HOMES	
SITE: ZADORA, Oshawana			MODEL: VILLA 7X EL 1,2,3	
LOT #:				

Villa 7 36' LOT


Lot 161 Zadora

ELEVATION 1 2,783 sq.ft. • ELEVATION 2 2,783 sq.ft. • ELEVATION 3 2,783 sq.ft.
INCLUDES 20 SQ.FT. OF OPEN AREA

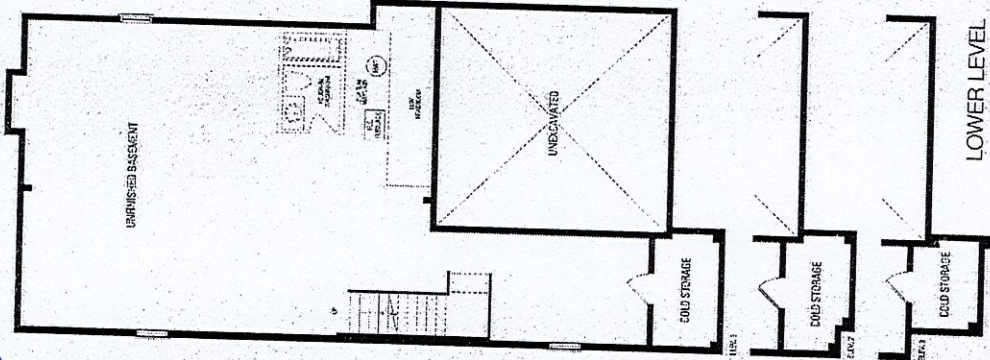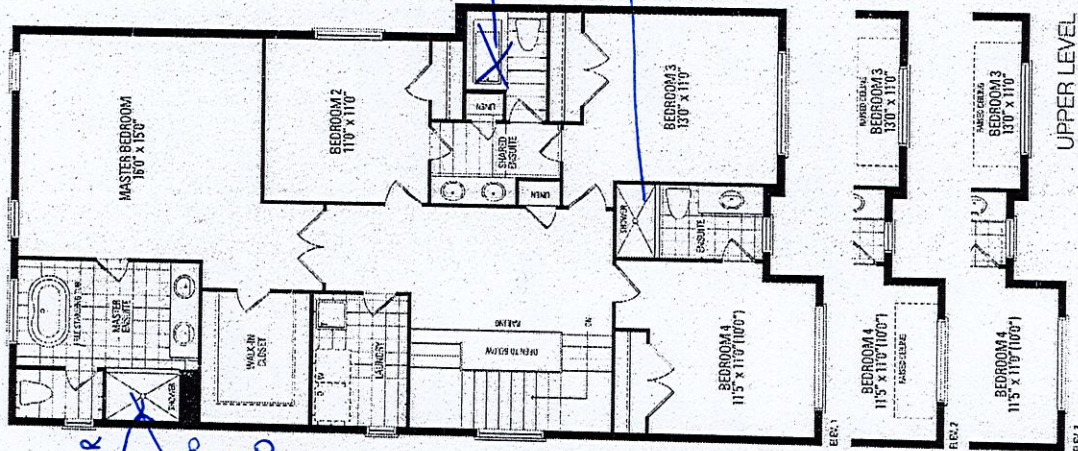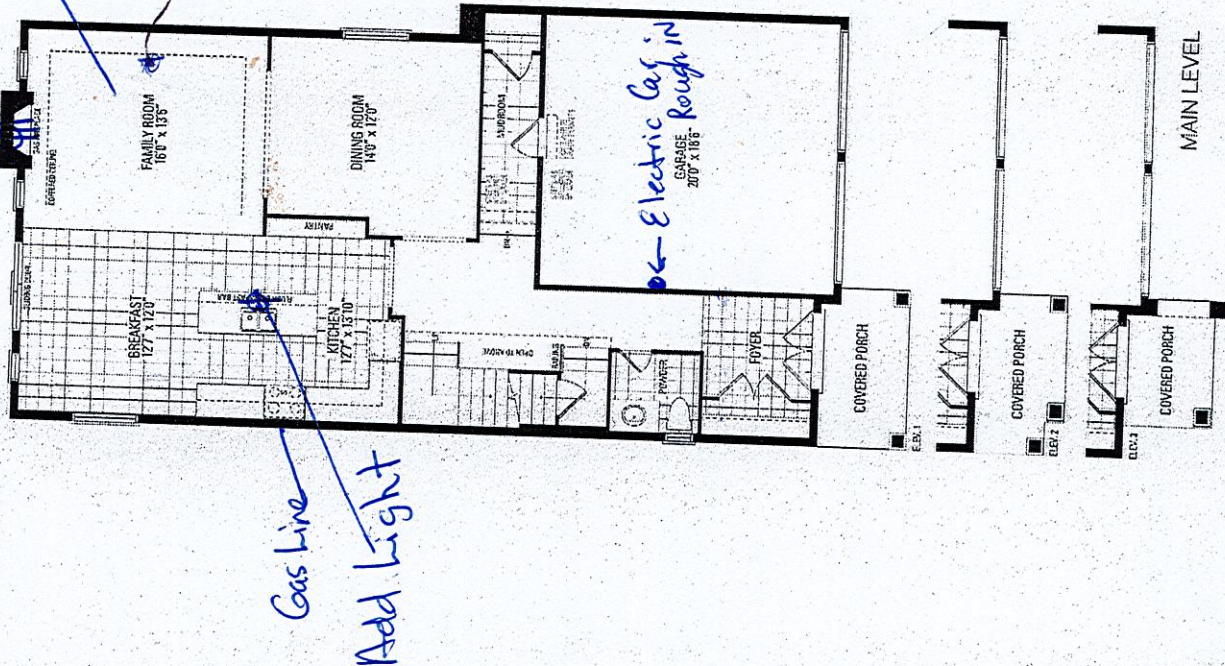

* Smooth Ceilings 1st Fl *

Lot 161 Zadorra

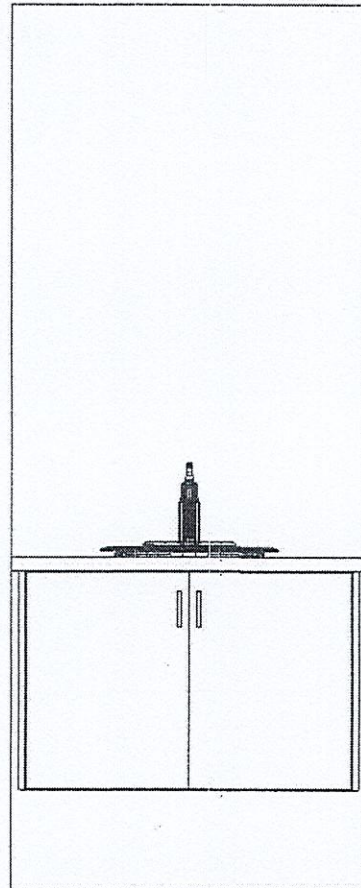

SUSPENDED VANITY DETAILS

602 HIGH BASE CABINET=598H DOOR
CABINETS TO HAVE SOLID 16 OR 19 BACKING

STANDARD INSTALLATION DETAIL
INSTALL AT 781 (36" HIGH VANITY)


SOLID 2X4 STUDS AND OR PLYWOOD ON WALLS
REQUIRED ON SITE TO SUPPORT VANITIES

Powder Room

This drawing is the intellectual property of
SELBA INDUSTRIES INC. and is an
artistic
interpretation of the general
appearance of the design. It is
not meant to be an exact rendition.

SUSPENDED VANITIES

MADISON

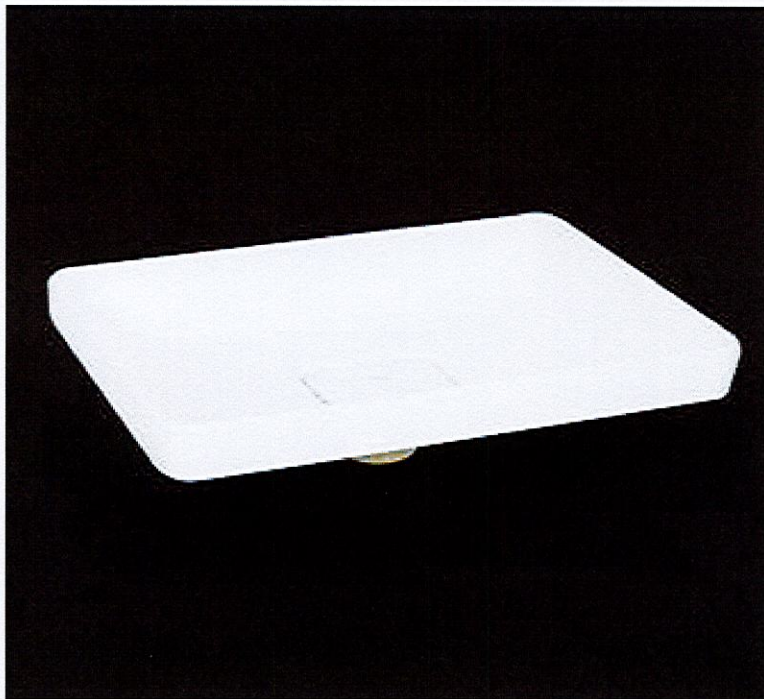

RECTANGULAR SEMI-RECESSED VESSEL SINK

13-0087A-W

Fine Fire Clay
Avenue white
Prim Rim profile
Ceramic cover plate supplied
Template included
Outer Dimensions:
20 1/4" (W) x 15 1/8" (D) x 5 1/2" (H)
515mm (W) x 385mm (D) x 140mm (H)



SQUARE VESSEL SINK

13-1517A-W-LP



Fine Fire Clay
Avenue white
Prim Rim profile
Template included
Pop-up not included
Outer Dimensions:
15 3/4" (W) x 15 3/4" (D) x 6" (H)
400mm (W) x 400mm (D) x 150mm (H)

Lot 161 Zadorra



Model: 6911

Moen - **Rizon Chrome One-Handle High Arc Vessel Bathroom Faucet**

Polished smooth with clean, horizontal lines, Rizon faucets and accessories demonstrate that simple sophistication is often all you need to make a Bath complete.

Powder Room

Where to Buy



Rizon Chrome One-Handle High Arc Vessel Bathroom Faucet

GALLERY 

Where to Buy