

<div>CONSTRUCTION SUMMARY</div> <div>Legacy Hill - Trinigroup Development Inc.</div>					<div>RECEIVED</div> <div>MAY 16 2024</div>	TEL:
PURCHASER: Le ZHANG						
LOT / PHASE		REG. PLAN #		HOUSE TYPE		
74 / 1				Villa 3 Elev 1		

CONSTRUCTION

<div>1 - FIRST FLOOR INCREASE CEILING HEIGHT FROM 9 FEET TO 10 FEET</div> <div>20Oct23 Note:</div>	
---	--

ELECTRICAL

<div>1 - RELOCATE STANDARD KITCHEN LIGHT TO BE CENTERED OVER ISLAND</div> <div>16May24 Note:</div>	
---	--

PROMOTIONAL

<div>1 - LESS CREDIT FROM PURCHASER EXTRA SHEET IN OFFER</div> <div>20Oct23 Note:</div>	
--	--

EXTRAS AS PER OFFER


<div>The Vendor agrees that notwithstanding any other term or provision in this Agreement included in the Purchase Price and in addition to those items detailed in Schedule GP to the Agreement of Purchase and Sale, the Purchaser is entitled to a credit of Ten</div> <div>Worksheet Note:</div>	
---	--

This Document is Extremely Time Sensitive - Printed 16 May 24 at 9:12


Villa 3 36' Lot

Elev. 1: 2,662 sq.ft. Elev. 2: 2,662 sq.ft. Elev. 3: 2,647 sq.ft.
Includes 15 sq.ft. of Open Area


LOT #74

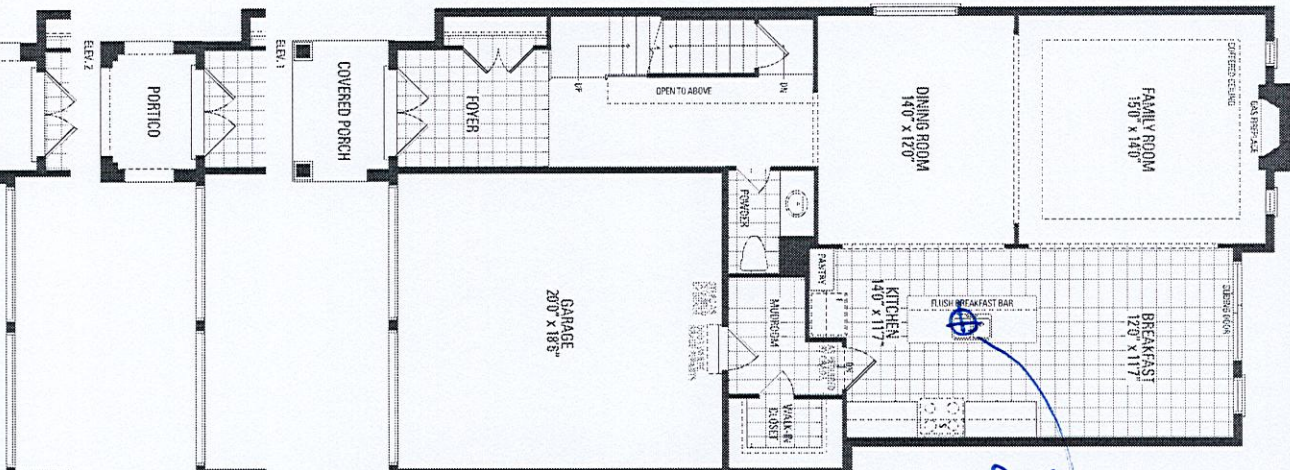

MAIN LEVEL

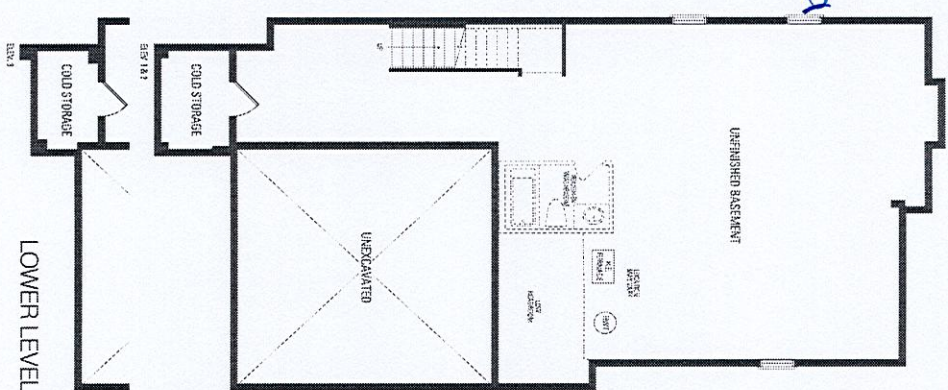

LOWER LEVEL

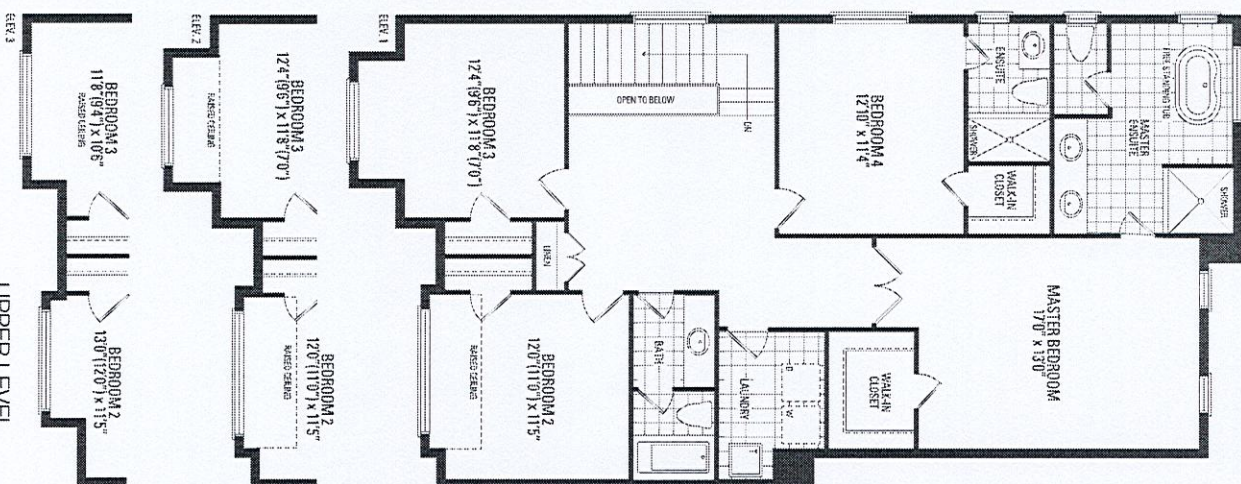

UPPER LEVEL

*10' - ceiling height - 1st Floor