

PURCHASER: XIUDAN WANG		CONSTRUCTION SUMMARY Legacy Hill - Trinigroup Development Inc.		RECEIVED JUL 03 2024		TEL:
------------------------	--	---	--	-------------------------	--	------

LOT / PHASE 88 / 1	REG. PLAN #	HOUSE TYPE Villa 12 Elev 2		
-----------------------	-------------	-------------------------------	--	--

CONSTRUCTION

4 - ENLARGED BASEMENT WINDOWS (MAY REQUIRE WINDOW WELLS) - WINDOW IS 30 INCHES X 24 INCHES 02Jul24 Note:	
--	--

PROMOTIONAL

1 - PARTIAL REDEMPTION OF PROMOTIONAL PACKAGE \$2,600 BALANCE FORWARD \$7,400 TO BE USED AT A LATER DATE. ORIGINAL PROMOTIONAL PACKAGE OF \$10,000 AS PER SCHEDULE PE. 02Jul24 Note:	
---	--


This Document is Extremely Time Sensitive - Printed 2 Jul 24 at 14:44

Villa 12 36' Lot

Elev. 1: 2,811 sq.ft. Elev. 2: 2,811 sq.ft. Elev. 3: 2,784 sq.ft.



Lot # 88
trinigroup

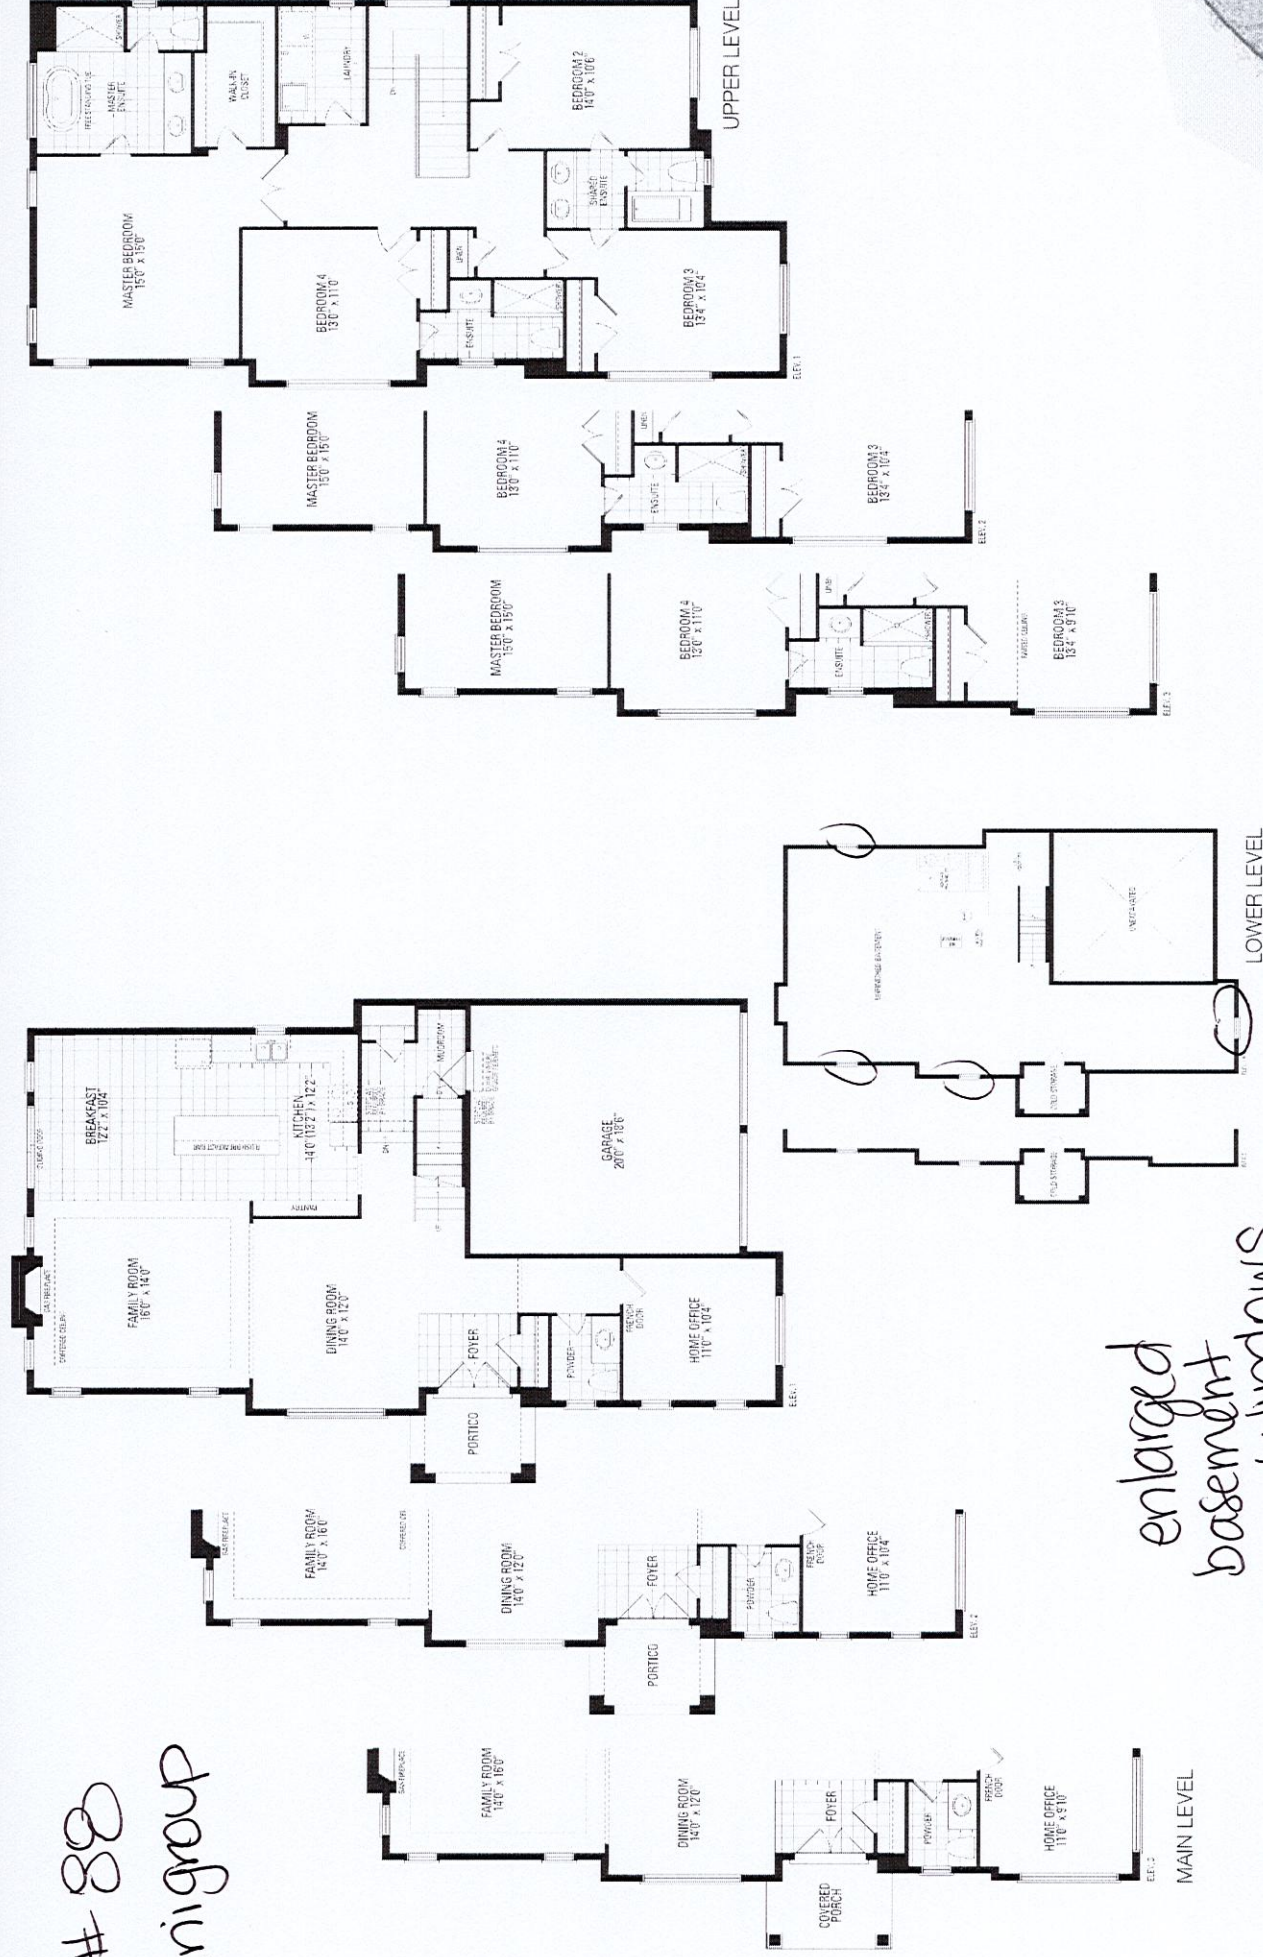

Orientation of home may be reversed and purchaser agrees to accept the same. Steps and porches may vary at any exterior entrance ways due to grading variance. Actual usable floor space may vary from the stated floor areas. All renderings are artist's concept. Dimensions, specifications and architectural detailing subject to modifications. Roofline and adjoining model types may vary due to siting. E. & O. E. September 2023