

CONSTRUCTION SUMMARY - PARTIAL ONLY
Legacy Hill - Trinigroup Development Inc.

RECEIVED

AUG 22 2024
TEL: RES.: 647-297-5506

PURCHASER: Xian ZHAO

LOT NUMBER	PHASE	HOUSE TYPE	REG. PLAN #		
45	1	Villa 6 Elev 3			
INV#	QTY	EXTRA / CHANGE			

Offer	Note:
-------	-------

ELECTRICAL




29,814 15May24	8 - FAMILY ROOM - POT LIGHT - LED - FIRST FLOOR INSTALLATION NoteSTANDARD LIGHT ON SEPARATE SWITCH
29,963 21Aug24	1 - ELECTRIC VEHICLE ROUGH-IN PROVISION ONLY FOR FUTURE ELECTRIC CAR (CONDUIT FROM BASEMENT INTO JUNCTION BOX IN GARAGE WITH PULL STRING, NO WIRE) Note: NEW ★ ★ ★
29,814 15May24	4 - HOME OFFICE - POT LIGHT - LED - FIRST FLOOR INSTALLATION NoteSTANDARD LIGHT ON SEPARATE SWITCH
29,814 15May24	4 - LIVING ROOM - POT LIGHT - LED - FIRST FLOOR INSTALLATION NoteSTANDARD LIGHT ON SEPARATE SWITCH
29,814 15May24	4 - DINING ROOM - POT LIGHT - LED - FIRST FLOOR INSTALLATION NoteSTANDARD LIGHT ON SEPARATE SWITCH
29,814 15May24	4 - BREAKFAST AREA - POT LIGHT - LED - FIRST FLOOR INSTALLATION NoteSTANDARD LIGHT ON SEPARATE SWITCH
29,814 15May24	6 - KITCHEN - POT LIGHT - LED - FIRST FLOOR INSTALLATION NoteSTANDARD LIGHT ON SEPARATE SWITCH
29,814 15May24	1 - RELOCATE STANDARD KITCHEN LIGHT TO BE CENTERED OVER ISLAND Note:
29,814 15May24	1 - PLUG - ELECTRICAL PLUG - ADD TO ISLAND Note:
29,814 15May24	1 - FAMILY ROOM - PLUG - ELECTRICAL PLUG - TO BE INSTALLED OVER FIREPLACE Note:

This Document is Extremely Time Sensitive - Printed 21 Aug 24 at 14:55

Villa 6 36' Lot

Elev. 1: 3,038 sq.ft. Elev. 2: 3,047 sq.ft. Elev. 3: 3,047 sq.ft.

Lot 45 Trinigroup
 Add Plug over fireplace
 4 POTS on 1 switch
 Standard Light
 Add Plug to Island
 Center light over island
 2 POTS on 1 switch
 4 POTS on 1 switch
 4 POTS on 1 switch
 4 POTS on 1 switch
 Relocate Sink and Dishwasher to Island.
 See sketch

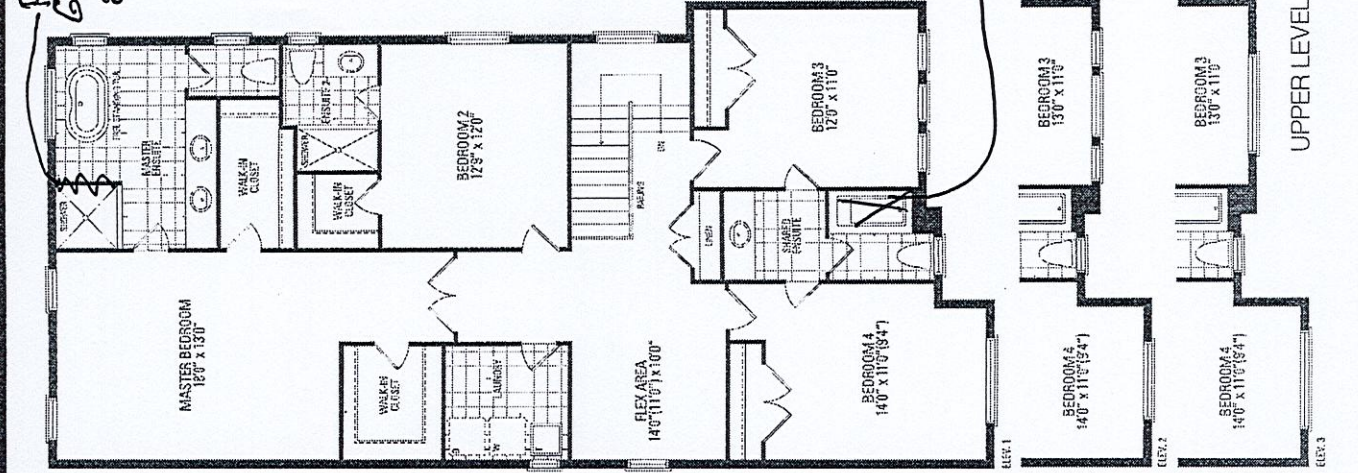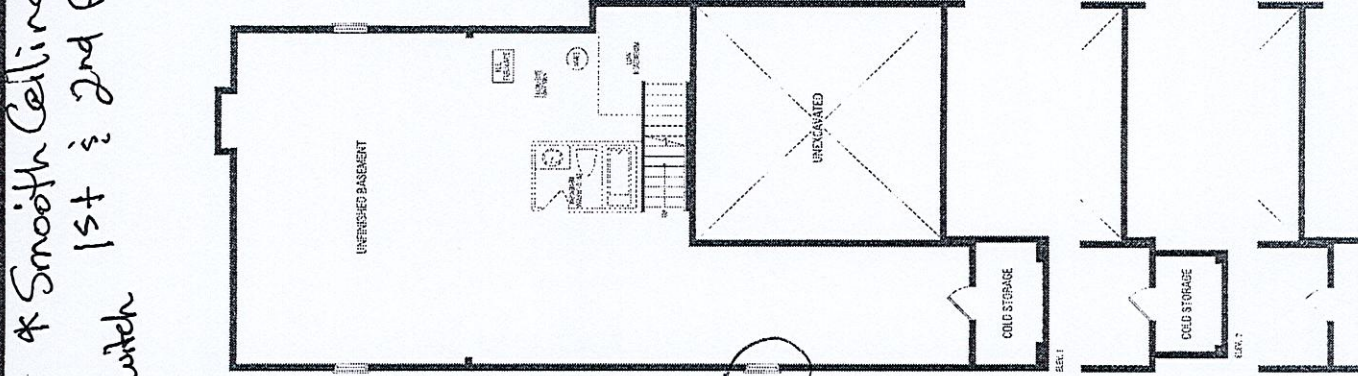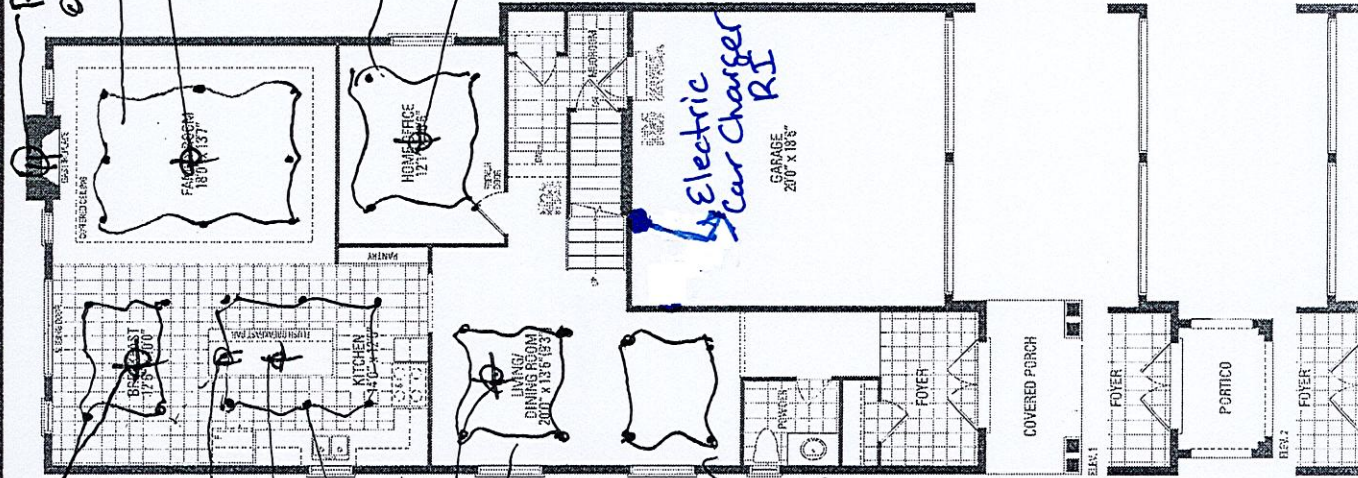

Frameless Glass Shower Enclosure
 Tub to Shower

Frameless Glass Shower Enclosure
 Tub to Shower

Frameless Glass Shower Enclosure
 Tub to Shower