

CONSTRUCTION SUMMARY - PARTIAL ONLY  
Legacy Hill - Trinigroup Development Inc.

PURCHASER: Ke LIU TEL:





LOT NUMBER	PHASE	HOUSE TYPE	REG. PLAN #		
108	1	Villa 6 Elev 3			

INV#	QTY	EXTRA / CHANGE	RECEIVED
------	-----	----------------	----------

SEP 25 2024

Offer	Note: REVISED - BASEMENT WINDOWS
-------	----------------------------------

CONSTRUCTION

29,386 24Oct23	1 - FIRST FLOOR INCREASE CEILING HEIGHT FROM 9 FEET TO 10 FEET Note:
29,868 04Jun24	1 - MASTER ENSUITE - PROVISION FOR FRAMELESS GLASS SHOWER ENCLOSURE - REMOVE SIDE WALL AND REPLACE WITH GLASS TO ACCOMMODATE FRAMELESS GLASS SHOWER ENCLOSURE SEE SKETCH Note:
30,023 24Sep24	2 - ENLARGED BASEMENT WINDOWS (MAY REQUIRE WINDOW WELLS) - WINDOW IS 30 INCHES X 24 INCHES Note:FOR CONFIRMATION PURPOSES ALL BASEMENT WINDOWS TO BE ENLARGED  
29,386 24Oct23	1 - LOWER LEVEL - BASEMENT 8 FOOT 6 INCH CONCRETE POUR - MEASURED FROM TOP OF FOOTING TO TOP OF FOUNDATION WALL Note:
29,386 24Oct23	1 - ENLARGED BASEMENT WINDOWS (MAY REQUIRE WINDOW WELLS) - WINDOW IS 30 INCHES X 24 INCHES Note:  




This Document is Extremely Time Sensitive - Printed 24 Sep 24 at 16:30



Lot 108 Legacy

# Villa 6 36' Lot

Elev. 1: 3,038 sq.ft. Elev. 2: 3,047 sq.ft. Elev. 3: 3,047 sq.ft.

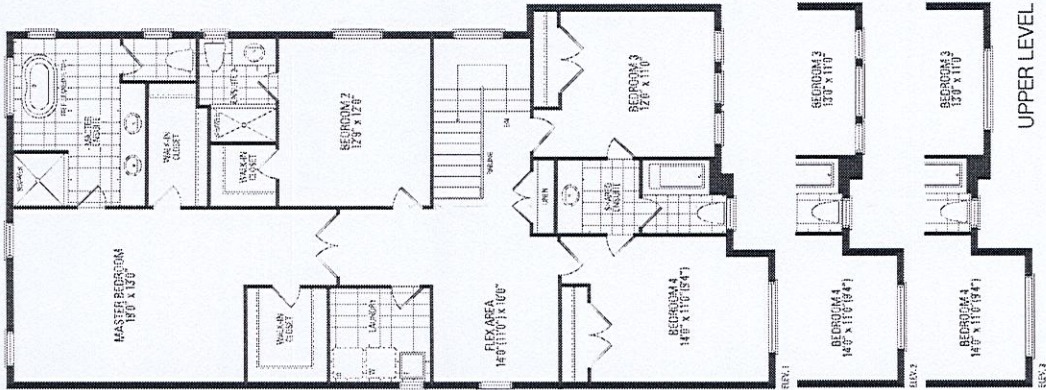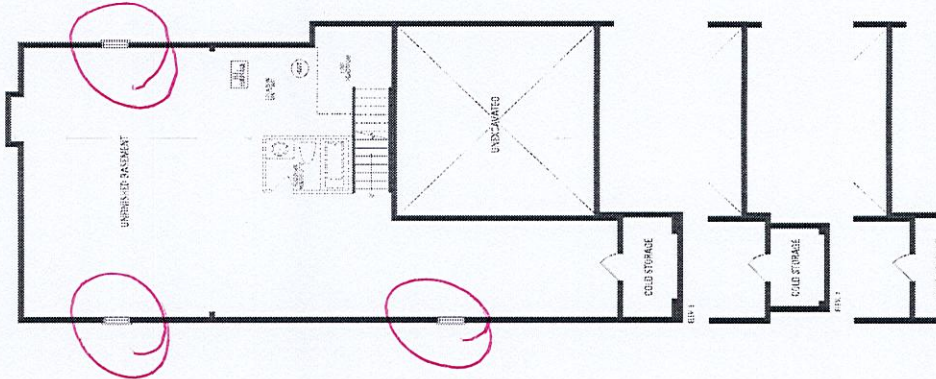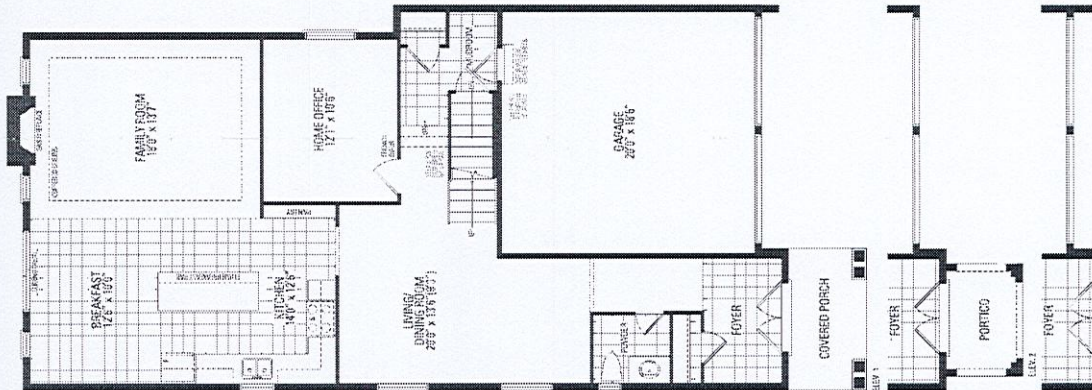

UPPER LEVEL