

CONSTRUCTION SUMMARY - PARTIAL ONLY
Legacy Hill - Trinigroup Development Inc.


PURCHASER: Xian ZHAO TEL: RES.: 647-297-5506

LOT NUMBER	PHASE	HOUSE TYPE	REG. PLAN #		
45	1	Villa 6 Elev 3			
INV#	QTY	EXTRA / CHANGE			COMMENTS

RECEIVED
SEP 27 2024

Offer	Note: REVISED BASEMENT WINDOWS
-------	---------------------------------------


CONSTRUCTION

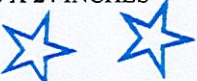29,660 06Mar24	1 - FIRST FLOOR INCREASE CEILING HEIGHT FROM 9 FEET TO 10 FEET Note:
30,021 24Sep24	2 - ENLARGED BASEMENT WINDOWS (MAY REQUIRE WINDOW WELLS) - WINDOW IS 30 INCHES X 24 INCHES NoteFOR CONFIRMATION PURPOSES ALL BASEMENT WINDOWS TO BE ENLARGED 
29,660 06Mar24	1 - ENLARGED BASEMENT WINDOWS (MAY REQUIRE WINDOW WELLS) - WINDOW IS 30 INCHES X 24 INCHES Note: 
29,814 15May24	1 - SMOOTH CEILINGS ON FIRST FLOOR Note:
29,814 15May24	1 - SMOOTH CEILING ON SECOND FLOOR Note:
29,814 15May24	1 - MASTER ENSUITE - PROVISION FOR FRAMELESS GLASS SHOWER ENCLOSURE - REMOVE SIDE WALL AND REPLACE WITH GLASS TO ACCOMMODATE FRAMELESS GLASS SHOWER ENCLOSURE SEE SKETCH Note:
29,814 15May24	1 - KITCHEN - RELOCATE SINK AND DISHWASHER TO ISLAND Note: SEE SKETCH


This Document is Extremely Time Sensitive - Printed 24 Sep 24 at 15:50




lot 45
Legacy

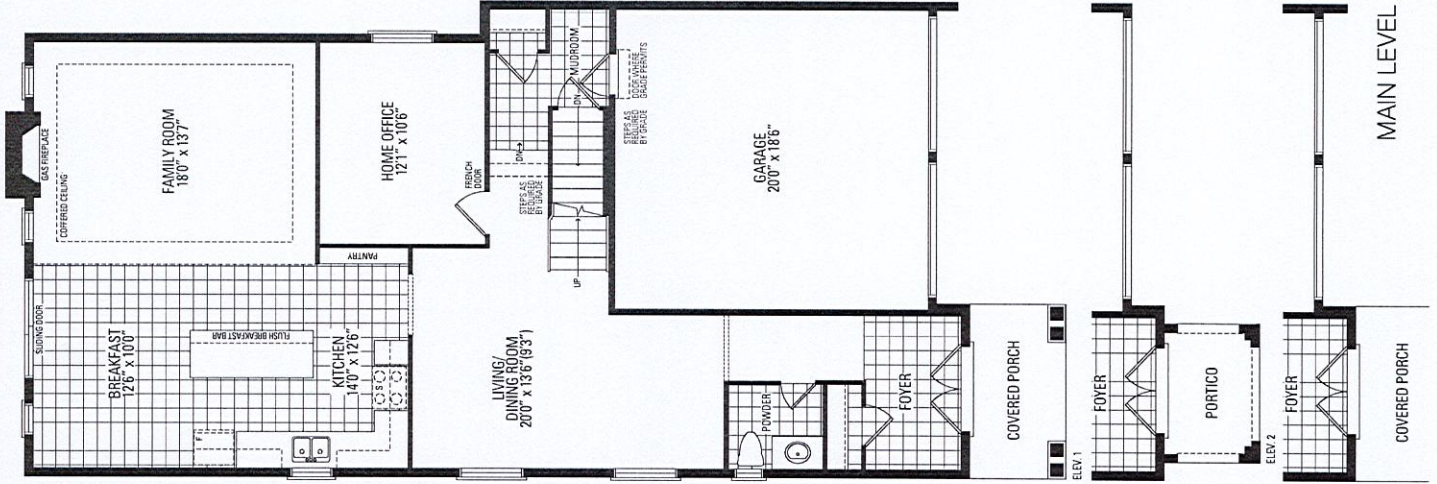

MAIN LEVEL

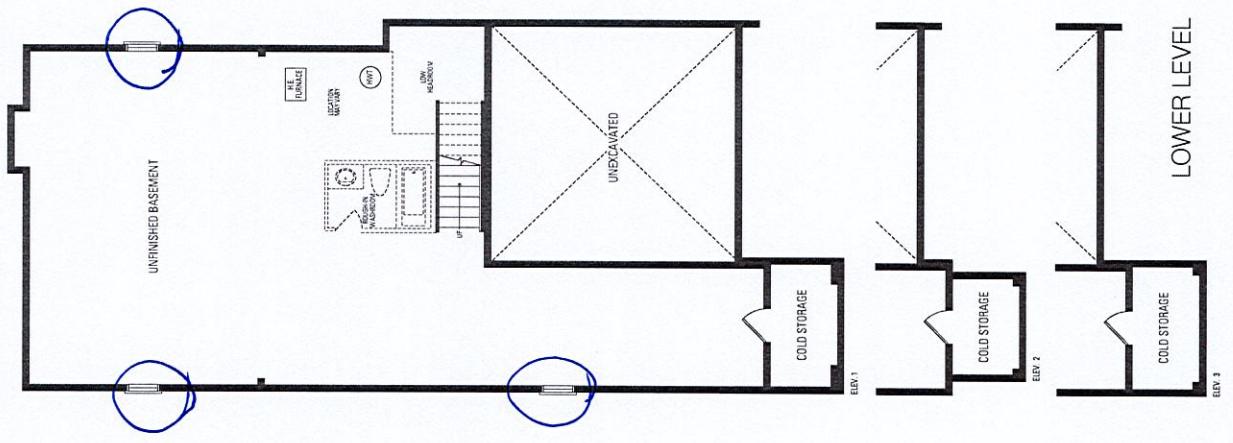

LOWER LEVEL

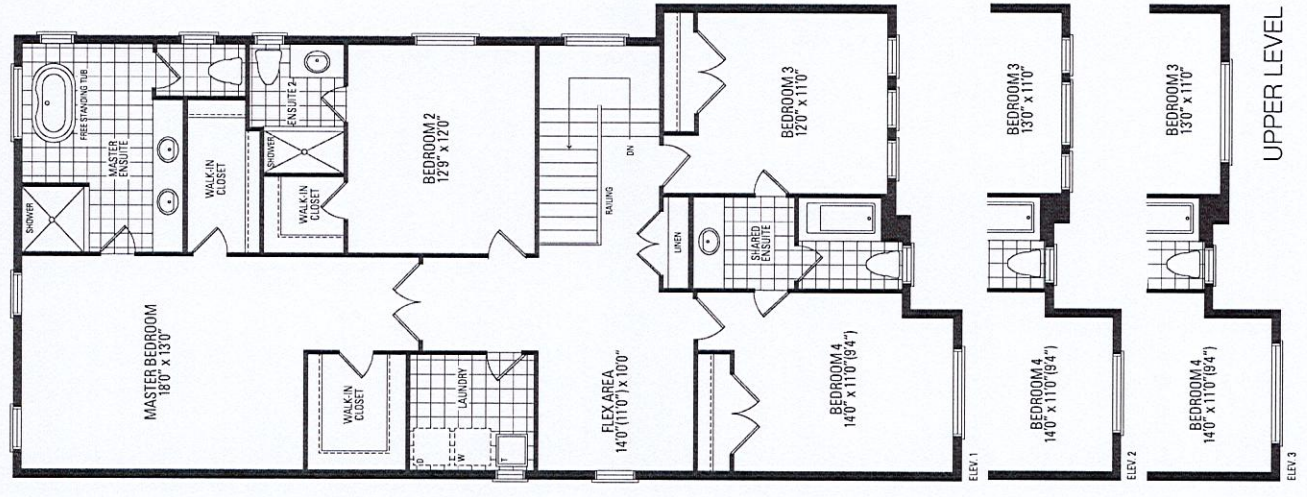

UPPER LEVEL