

CONSTRUCTION SUMMARY - PARTIAL ONLY
Legacy Hill - Trinigroup Development Inc.

PURCHASERS: Pauline M.YAP and Dalton Frances YAP TEL:

LOT NUMBER	PHASE	HOUSE TYPE	REG. PLAN #		
98	1	Villa 12 Elev 2			

INV#	QTY	EXTRA / CHANGE	RECEIVED	COMMENTS
------	-----	----------------	----------	----------

SEP 27 2024

Offer	Note: REVISED - BASEMENT WINDOWS
-------	---

CONSTRUCTION


29,887 21Jun24	2 - ENLARGED BASEMENT WINDOWS (MAY REQUIRE WINDOW WELLS) - WINDOW IS 30 INCHES X 24 INCHES Note:  
29,911 24Sep24	2 - ENLARGED BASEMENT WINDOWS (MAY REQUIRE WINDOW WELLS) - WINDOW IS 30 INCHES X 24 INCHES Note: FOR CONFIRMATION PURPOSES ALL BASEMENT WINDOWS TO BE ENLARGED  
29,906 18Jul24	1 - PROVISION FOR SHAMPOO NICHE APPROX. 14" WIDE X 20" HIGH AS PER SKETCH – IF CONSTRUCTION PERMITS Note:

This Document is Extremely Time Sensitive - Printed 24 Sep 24 at 14:09

Villa 12 36' Lot

Elev. 1: 2,811 sq.ft. Elev. 2: 2,811 sq.ft. Elev. 3: 2,784 sq.ft.

Lot 98 Legacy

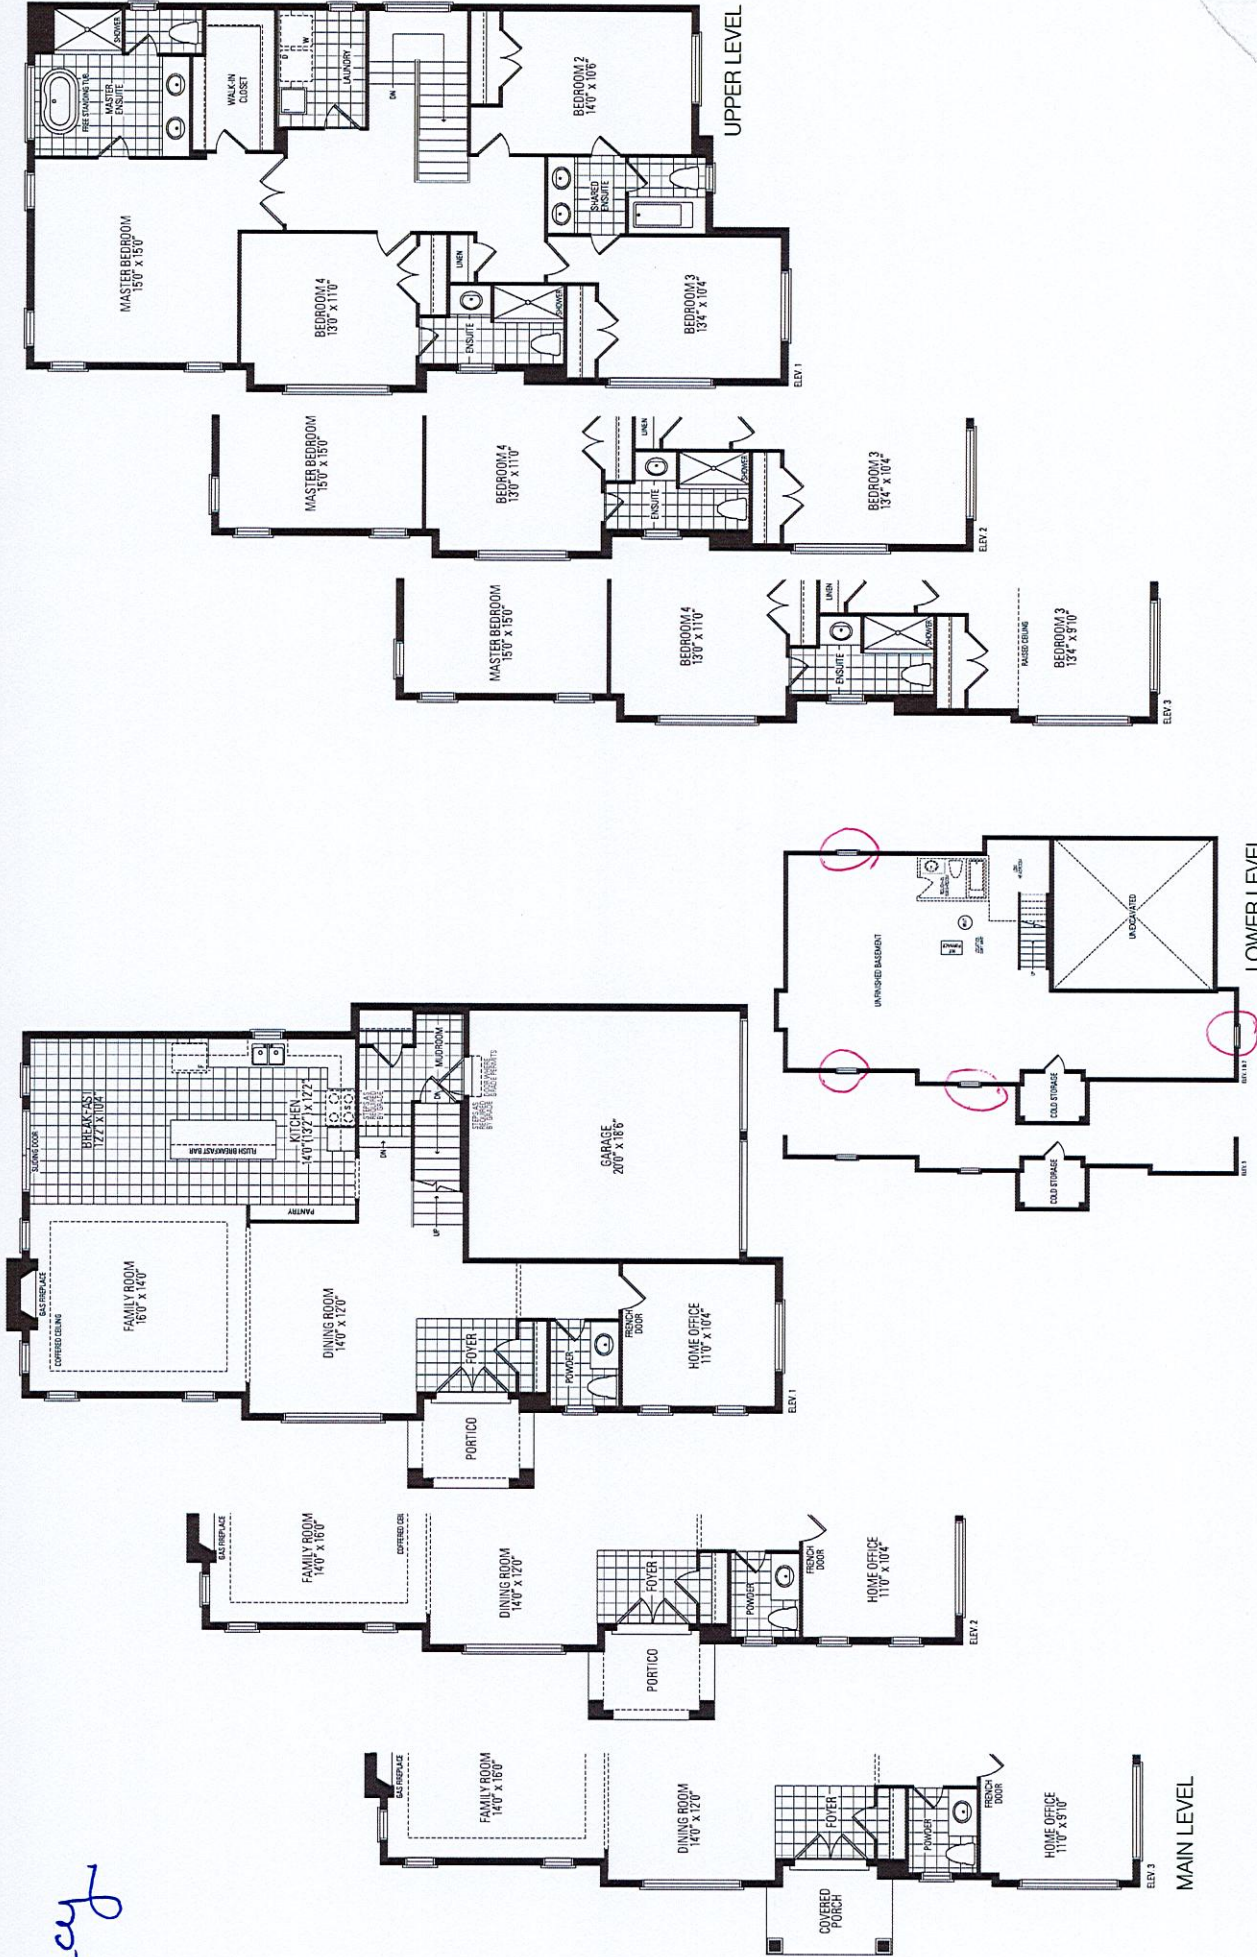

Orientation of home may be reversed and purchaser agrees to accept the same. Steps and porches may vary at any exterior entrance ways due to grading variance. Actual usable floor space may vary from the stated floor areas. All renderings are artist's concept. Dimensions, specifications and architectural detailing subject to modifications. Roofline and adjoining model types may vary due to siting. E. & O. E. September 2023