

CONSTRUCTION SUMMARY - PARTIAL ONLY
Legacy Hill - Trinigroup Development Inc.

PURCHASER: Kai WAN TEL:

LOT NUMBER	PHASE	HOUSE TYPE	REG. PLAN #		
107	1	Villa 12 Elev 3			
INV#	QTY	EXTRA / CHANGE		RECEIVED	

OCT 03 2024

Offer	Note: REVISED- BASEMENT WINDOWS
-------	---------------------------------

CONSTRUCTION

29,367 19Oct23	1 - FIRST FLOOR INCREASE CEILING HEIGHT FROM 9 FEET TO 10 FEET Note:
30,037 02Oct24	2 - ENLARGED BASEMENT WINDOWS (MAY REQUIRE WINDOW WELLS) - WINDOW IS 30 INCHES X 24 INCHES Note:  
29,367 19Oct23	1 - LOWER LEVEL - BASEMENT 8 FOOT 6 INCH CONCRETE POUR - MEASURED FROM TOP OF FOOTING TO TOP OF FOUNDATION WALL Note:
29,367 19Oct23	2 - ENLARGED BASEMENT WINDOWS (MAY REQUIRE WINDOW WELLS) - WINDOW IS 30 INCHES X 24 INCHES Note:  


This Document is Extremely Time Sensitive - Printed 2 Oct 24 at 11:41

Villa 12 36' Lot

Elev. 1: 2,811 sq.ft. Elev. 2: 2,811 sq.ft. Elev. 3: 2,784 sq.ft.



Lot 107 Legacy

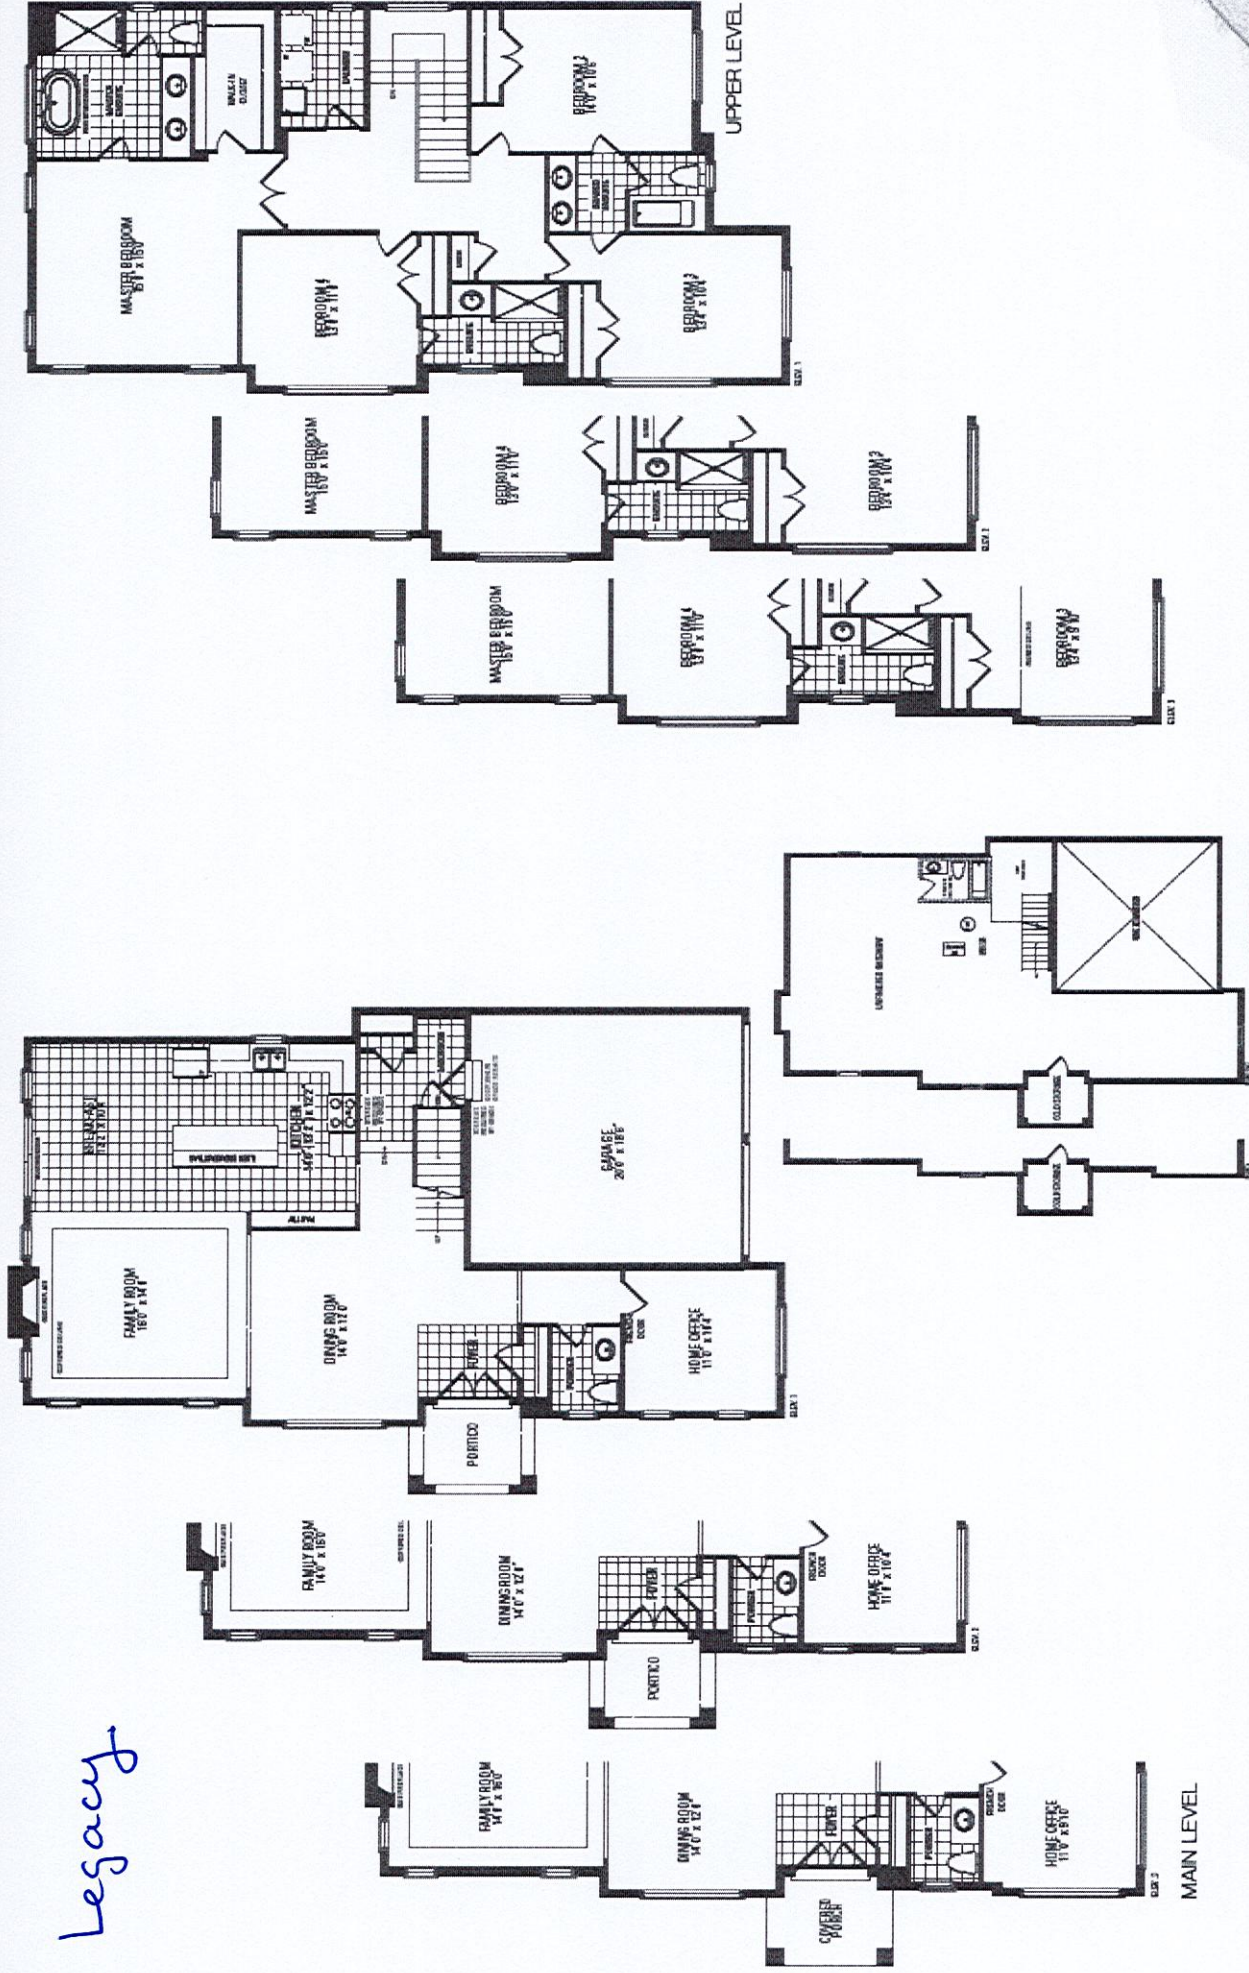

Orientation of home may be reversed and purchaser agrees to accept the same. Steps and porches may vary at any exterior entrance ways due to grading variance. Actual usable floor space may vary from the stated floor areas. All renderings are artist's concept. Dimensions, specifications and architectural detailing subject to modifications. Roofline and adjoining model types may vary due to siting. E. & O. E. September 2023