

CONSTRUCTION SUMMARY - PARTIAL ONLY

Palmetto - Zadorra Estates Corp.

PURCHASERS: Ajit Singh PARASHAR and Neelam SHARMA

RECEIVED

OCT 07 2024

TEL: RES.: 416-902-0276

LOT NUMBER	PHASE	HOUSE TYPE	REG. PLAN #		
147	1	Villa 12 Elev 3	40M-2763		
INV#	QTY	EXTRA / CHANGE			

Offer	Note: REVISED NEW BACKSPLASH AREA ADDED IN
-------	--

COUNTER TOP

KITCHEN

30,038 03Oct24	1 - KITCHEN - STONE BACKSPLASH TO BE INSTALLED AROUND WINDOW ABOVE KITCHEN SINK Note:	
28,779 25Oct23	3 - PRIMARY ENSUITE - SHAMPOO NICHE 14" WIDE X 20" HIGH AS PER SKETCH – MARBLE, GRANITE OR QUARTZ – IF CONSTRUCTION PERMITS - REQUIRES PROVISION FROM CONSTRUCTION PRIMARY ENSUITE/ ENSUITE 2/3/ ENSUITE 4 NoteSUPPLY & INSTALL	
29,624 08Feb24	1 - KITCHEN COUNTER TOP - UPGRADE STONE COUNTER TOP Note:	
29,624 08Feb24	1 - KITCHEN BACKSPLASH FULL HEIGHT - UPGRADE STONE COUNTER TOP NotePRICE DOES NOT INCLUDE AREA BEHIND CHIMNEY HOOD TO CEILING - SOLD SEPARATELY	
29,624 08Feb24	1 - KITCHEN BACKSPLASH EXTRA AREA FOR QUARTZ BACKSPLASH - EXTRA AREA BEHIND CHIMNEY HOOD FAN TO CEILING - FOR 9 FOOT CEILING Note:	


This Document is Extremely Time Sensitive - Printed 3 Oct 24 at 16:36

[illegible]

Selba Industries				J #
W WDTH	W HGHT	W GNT	This drawing is the intellectual property of SELBA INDUSTRIES INC. and is an original design which must not be released or copied unless applicable fee has been paid or job order placed.	
FLOOR HGHT	DOOR HGHT	JOB NUMBER: BUILDER: GREENPARK HOMES SITE: ZADORRA, Oshawa MODEL: VILLA 12X EL 3 LOT #:		
ST CENT	2X4	VENT BOX COVER	DESIGNER: BM DATE: AUG 4 23	

Villa 12 36 LOT

ELEVATION 1 2,811 sq.ft. • ELEVATION 2 2,811 sq.ft. • ELEVATION 3 2,784 sq.ft.

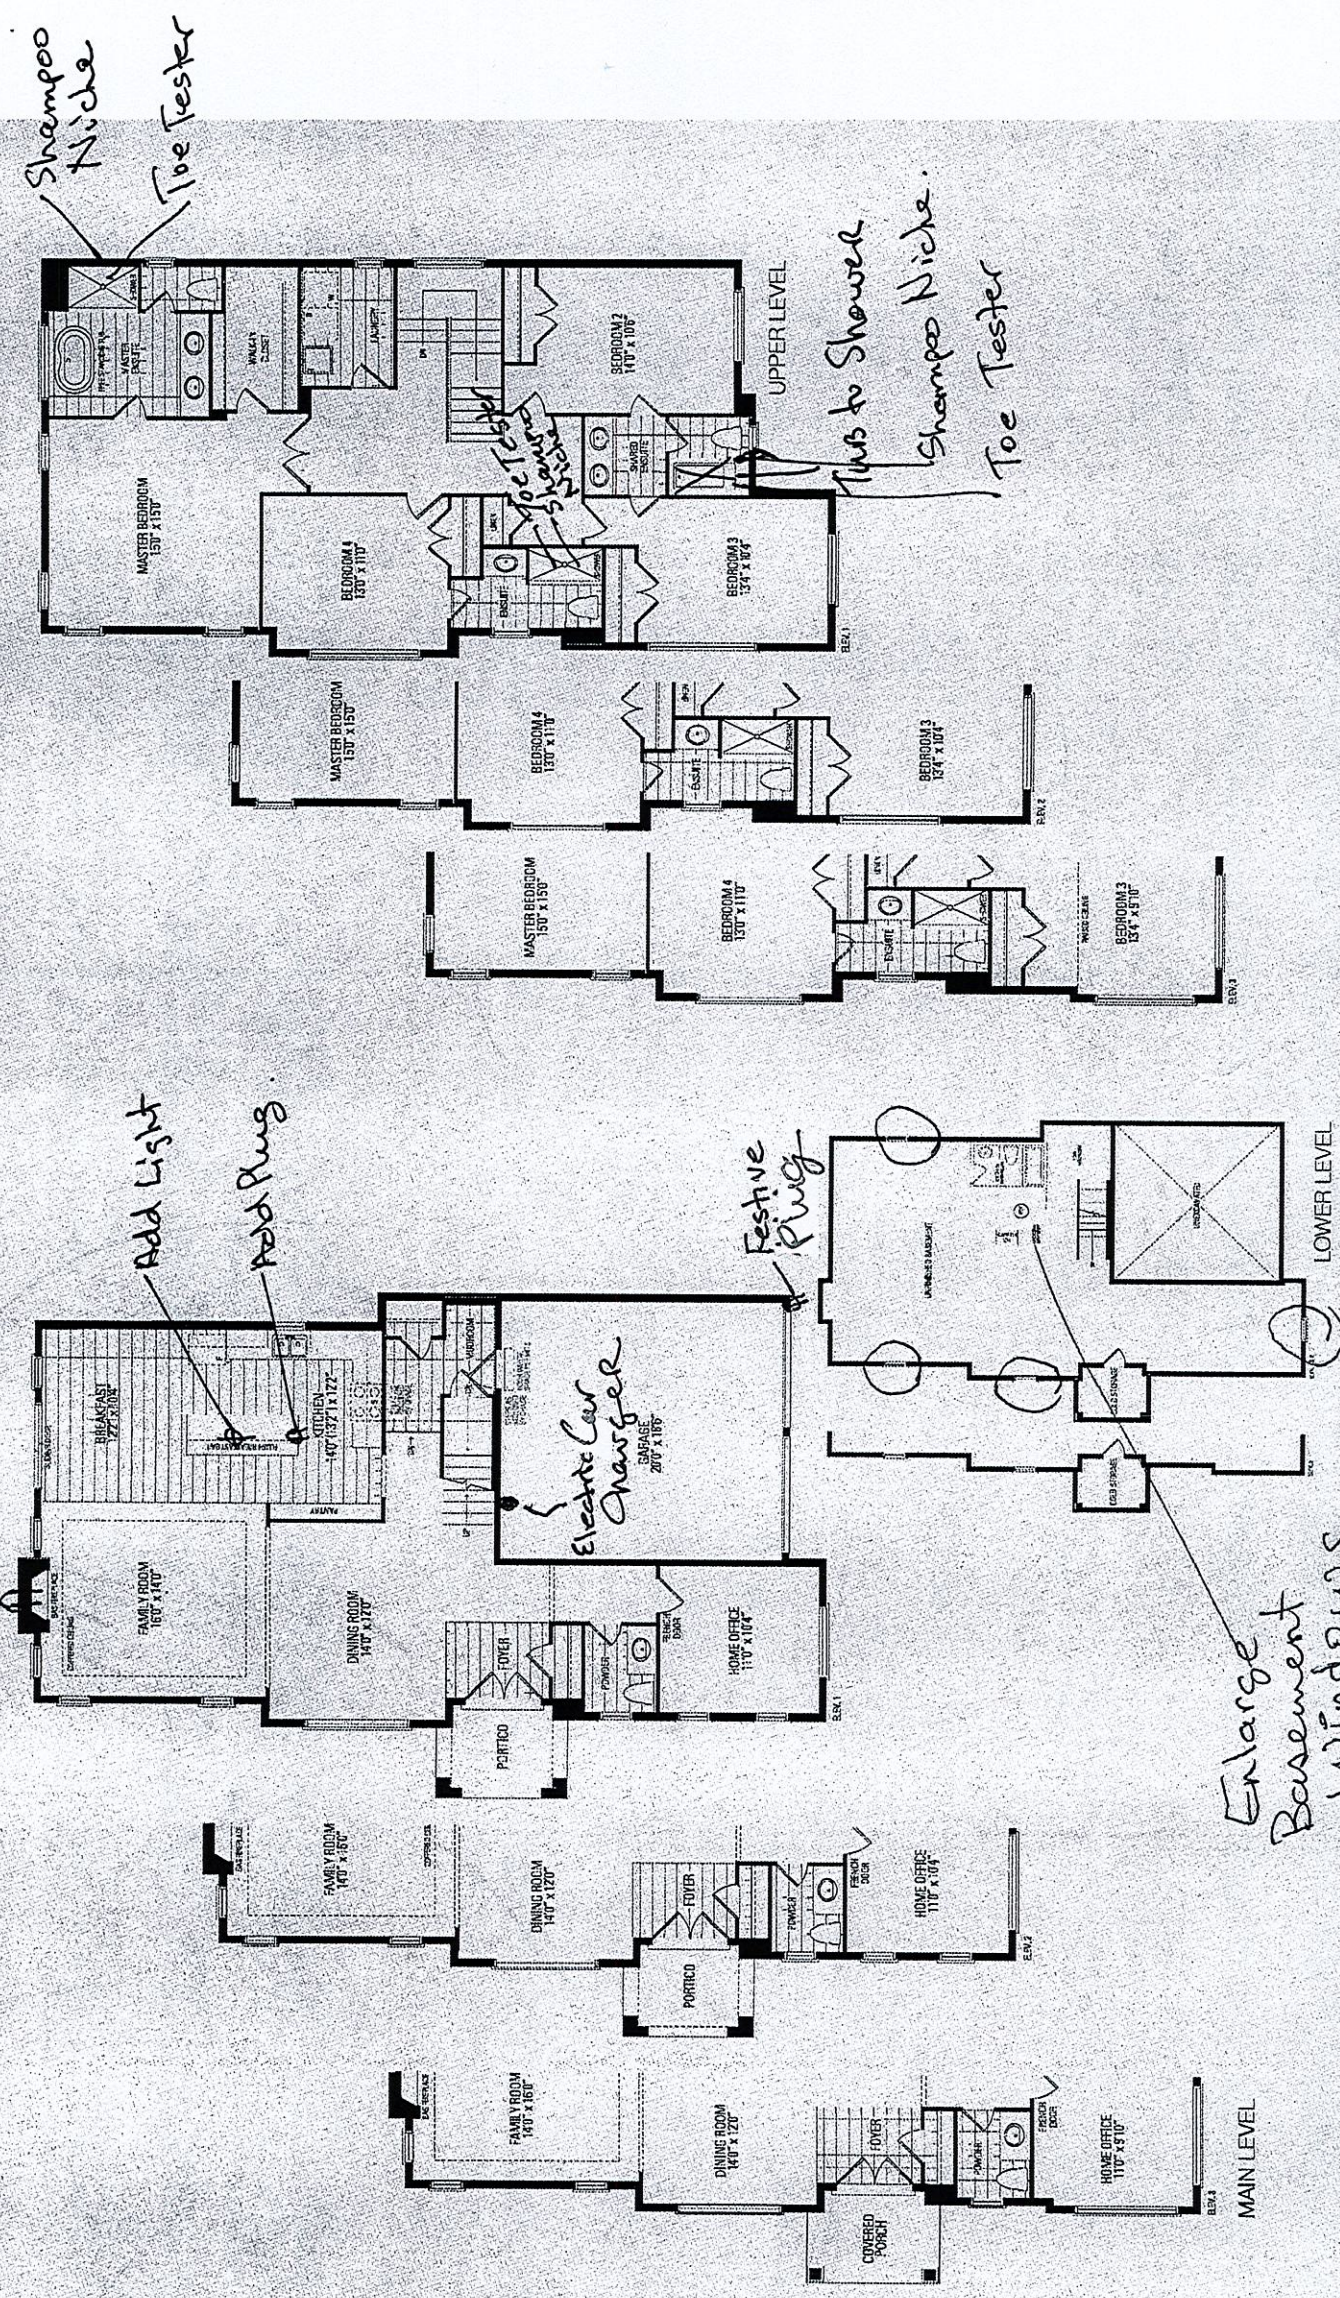

Orientation of home may be reversed and purchaser agrees to accept the same. Steps and porches may vary at any exterior entrance ways due to grading variance. Actual usable floor space may vary from the stated floor areas. All renderings are artist's concept. Dimensions, specifications and architectural detailing subject to modifications. Roofline and adjoining model types may vary due to siting. E. & O. E. May 2023