

CONSTRUCTION SUMMARY - PARTIAL ONLY  
Palmetto - Zadorra Estates Corp.

PURCHASERS: Deviranie KUBEER and Deoraj KALPOO TEL: RES.: 905-441-9075

| LOT NUMBER | PHASE | HOUSE TYPE                | REG. PLAN # |  |  |
|------------|-------|---------------------------|-------------|--|--|
| 111        | 1     | Rose 6 Elev 3 (5 Bedroom) | 40M-2763    |  |  |

| INV# | QTY | EXTRA / CHANGE | RECEIVED |
|------|-----|----------------|----------|
|------|-----|----------------|----------|

OCT 17 2024

|       |       |                         |
|-------|-------|-------------------------|
| Offer | Note: | Revised: added area Kt. |
|-------|-------|-------------------------|

COUNTER TOP

Backsplash

|                   |                                                                                             |
|-------------------|---------------------------------------------------------------------------------------------|
| 29,734<br>17Oct24 | 1 - KITCHEN - STONE BACKSPLASH TO BE INSTALLED AROUND WINDOW ABOVE SINK IN KITCHEN<br>Note: |
|-------------------|---------------------------------------------------------------------------------------------|




|                   |                                                                         |
|-------------------|-------------------------------------------------------------------------|
| 29,510<br>22Nov23 | 1 - KITCHEN BACKSPLASH FULL HEIGHT - UPGRADE STONE COUNTER TOP<br>Note: |
|-------------------|-------------------------------------------------------------------------|

This Document is Extremely Time Sensitive - Printed 17 Oct 24 at 13:08



Lot 111 Zadorra

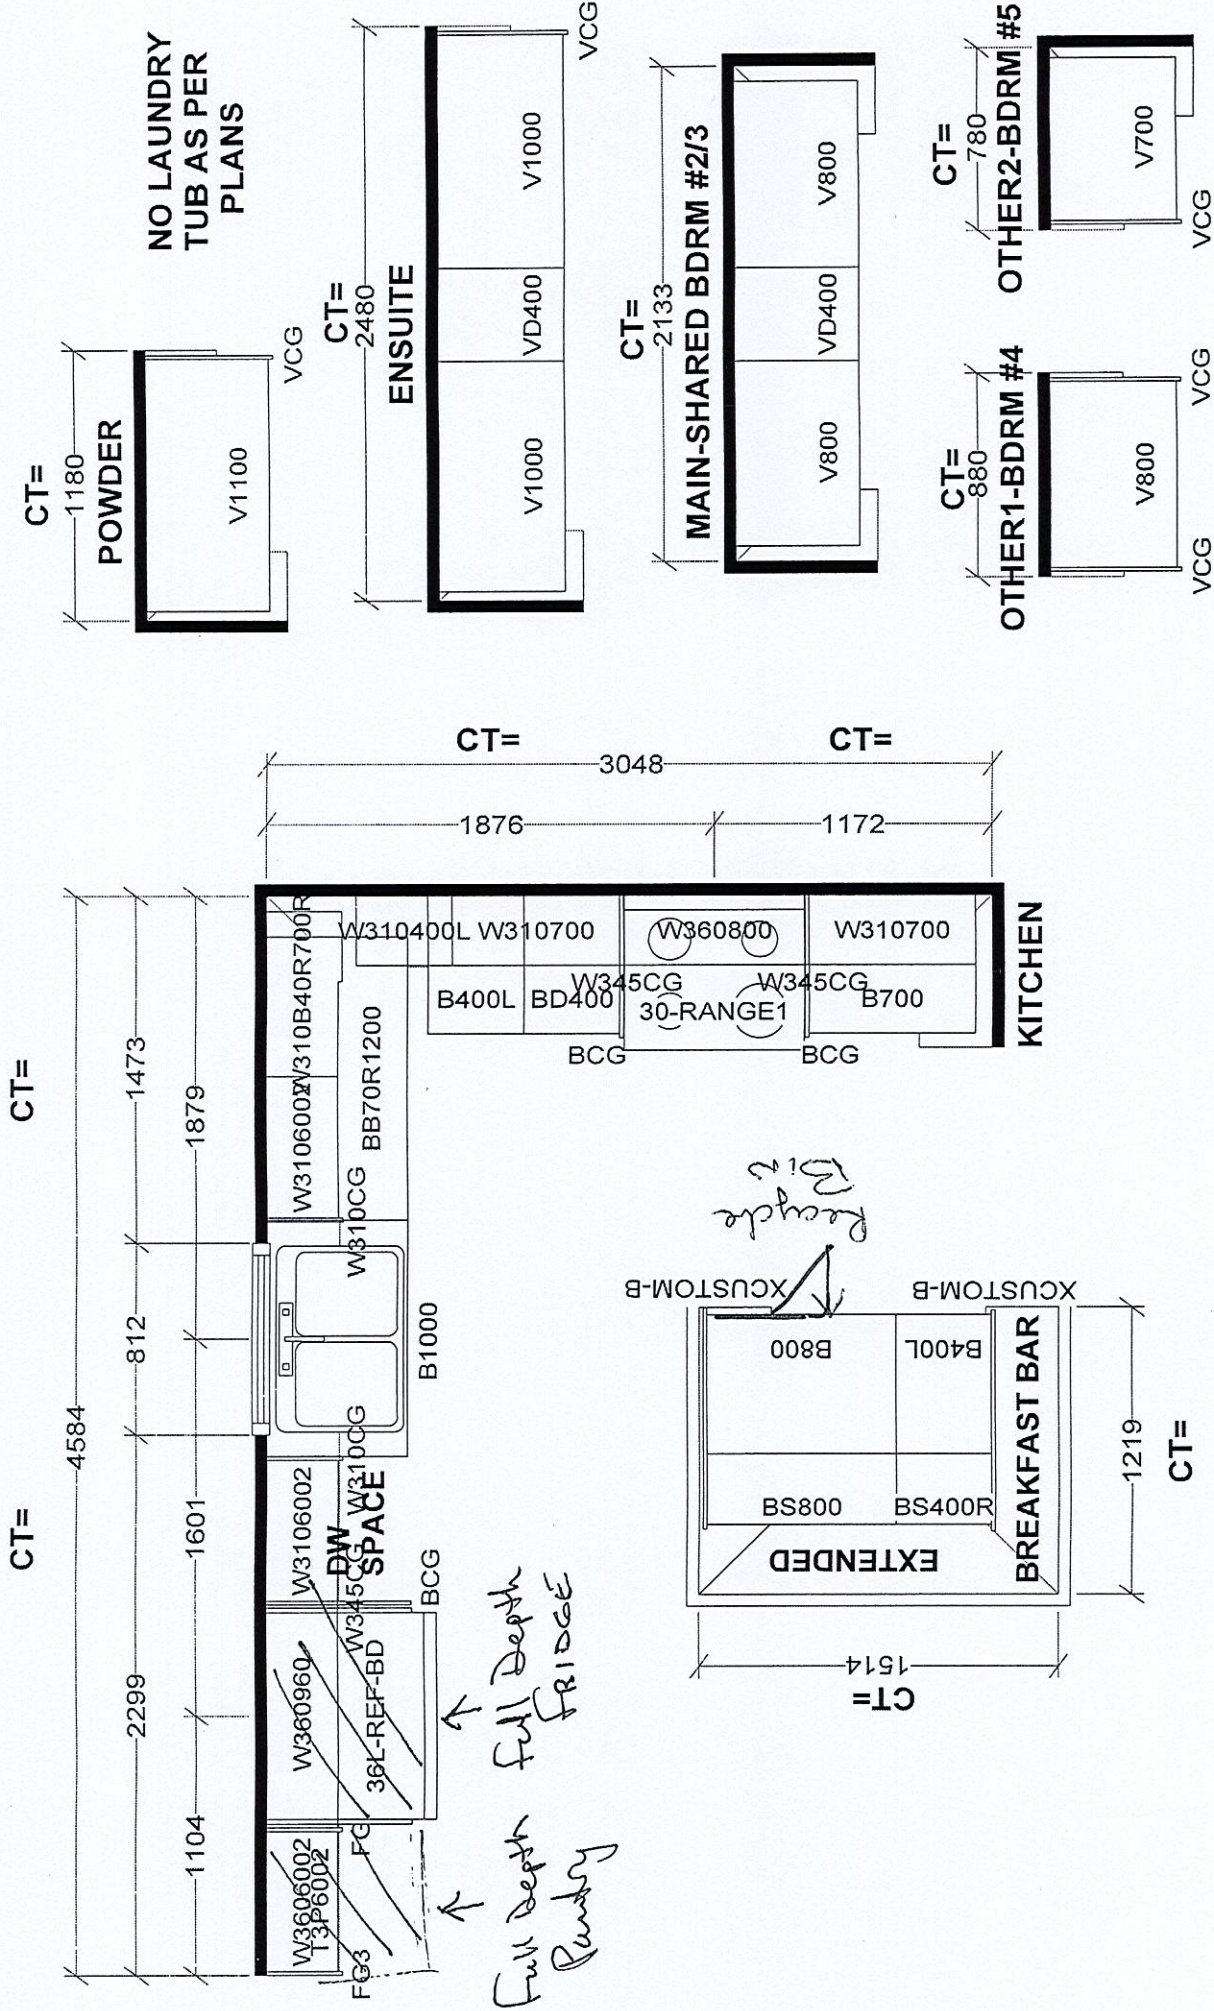

| Selba Industries |           |                |                                                                                                                                                                                            | J # |
|------------------|-----------|----------------|--------------------------------------------------------------------------------------------------------------------------------------------------------------------------------------------|-----|
| W WDTH           | W HGHT    | W CNT          | This drawing is the intellectual property of SELBA INDUSTRIES INC. and is an original design which must not be released or copied unless applicable fee has been paid or job order placed. |     |
| FLOOR HGHT       | DOOR HGHT |                |                                                                                                                                                                                            |     |
| ST CENT          | 2X4       | VENT BOX COVER |                                                                                                                                                                                            |     |
|                  |           | DESIGNER: BM   |                                                                                                                                                                                            |     |
|                  |           | DATE: AUG 3 23 | JOB NUMBER:<br>BUILDER: GREENPARK HOMES<br>SITE: ZADORRA, Oshawana<br>MODEL: ROSE 6X OPT 5 BD EL 1,2,3<br>LOT #:                                                                           |     |



Lot 111 Zadorra

ROSE 6 40' LOT

ELEVATION 1 3,215 sq.ft. • ELEVATION 2 3,197 sq.ft. • ELEVATION 3 3,197 sq.ft.  
INCLUDES 11 SQ.F.T. OF OPEN AREA.

Add Plug above  
Fireplace



Waterline for fridge  
Add Plug to  
Island

Dimmer  
Switch

Add  
Light  
to  
Living  
Room

Electric  
Car Charger

Garage  
Door  
Opener  
x2

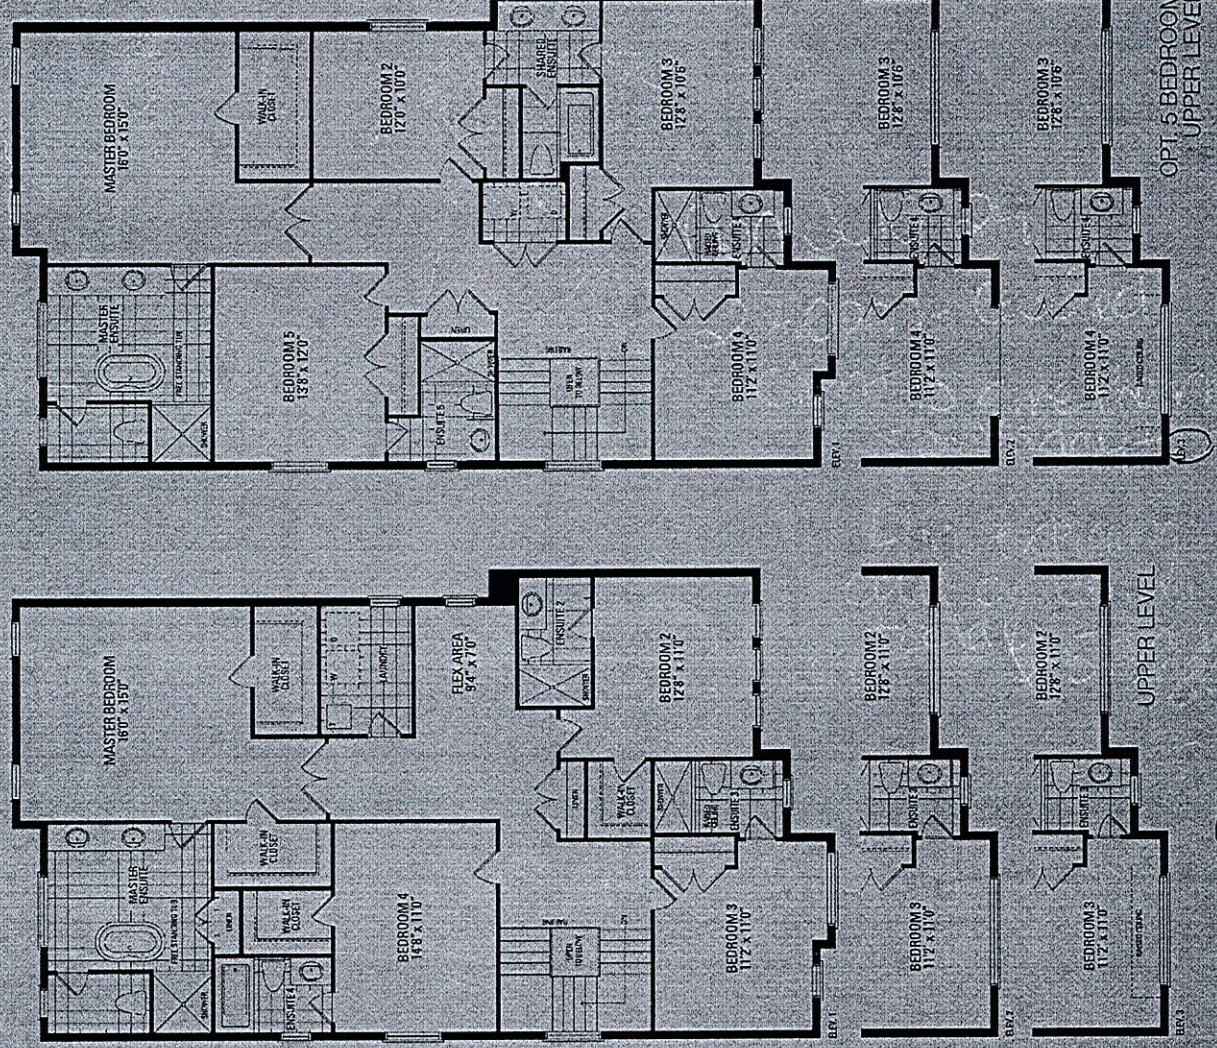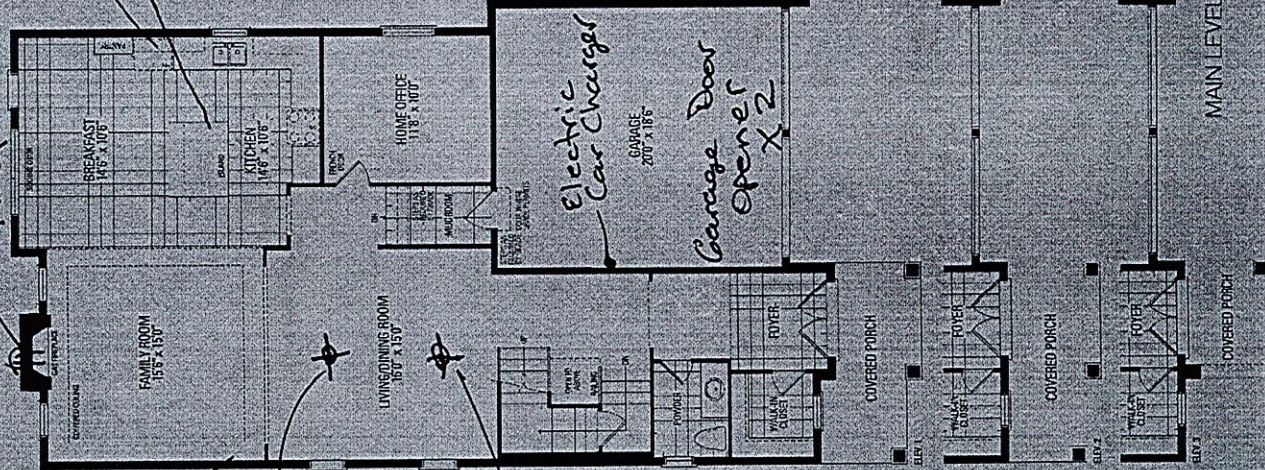

\* Smooth Ceilings 1st floor \*