

CONSTRUCTION SUMMARY - PARTIAL ONLY

Legacy Hill - Trinigroup Development Inc.

PURCHASER: May LUI

TEL:

LOT NUMBER	PHASE	HOUSE TYPE	REG. PLAN #		
1	1	Villa 12 Elev 1	65M-4818		

INV#	QTY	EXTRA / CHANGE
------	-----	----------------

RECEIVED

OCT 29 2024

Offer	Note:
-------	-------

Revised Shower Niche location

CONSTRUCTION


30,080 29Oct24	1 - MASTER ENSUITE SHOWER- CHANGE LOCATION OF NICHE TO BACK WALL- SEE SKETCH Note:
29,733 02May24	1 - SMOOTH CEILINGS ON FIRST FLOOR Note:
29,733 02May24	1 - PROVISION FOR SHAMPOO NICHE APPROX. 14" WIDE X 20" HIGH AS PER SKETCH – IF CONSTRUCTION PERMITS NoteMASTER ENSUITE
29,603 26Jan24	4 - ENLARGED BASEMENT WINDOWS (MAY REQUIRE WINDOW WELLS) - WINDOW IS 30 INCHES X 24 INCHES Note:
29,603 26Jan24	1 - LOWER LEVEL - BASEMENT 8 FOOT 6 INCH CONCRETE POUR - MEASURED FROM TOP OF FOOTING TO TOP OF FOUNDATION WALL Note:
29,603 26Jan24	1 - FIRST FLOOR INCREASE CEILING HEIGHT FROM 9 FEET TO 10 FEET Note:

This Document is Extremely Time Sensitive - Printed 29 Oct 24 at 11:30

LOT #1

Villa 12 36' Lot

Elev. 1: 2,811 sq.ft. Elev. 2: 2,811 sq.ft. Elev. 3: 2,784 sq.ft.

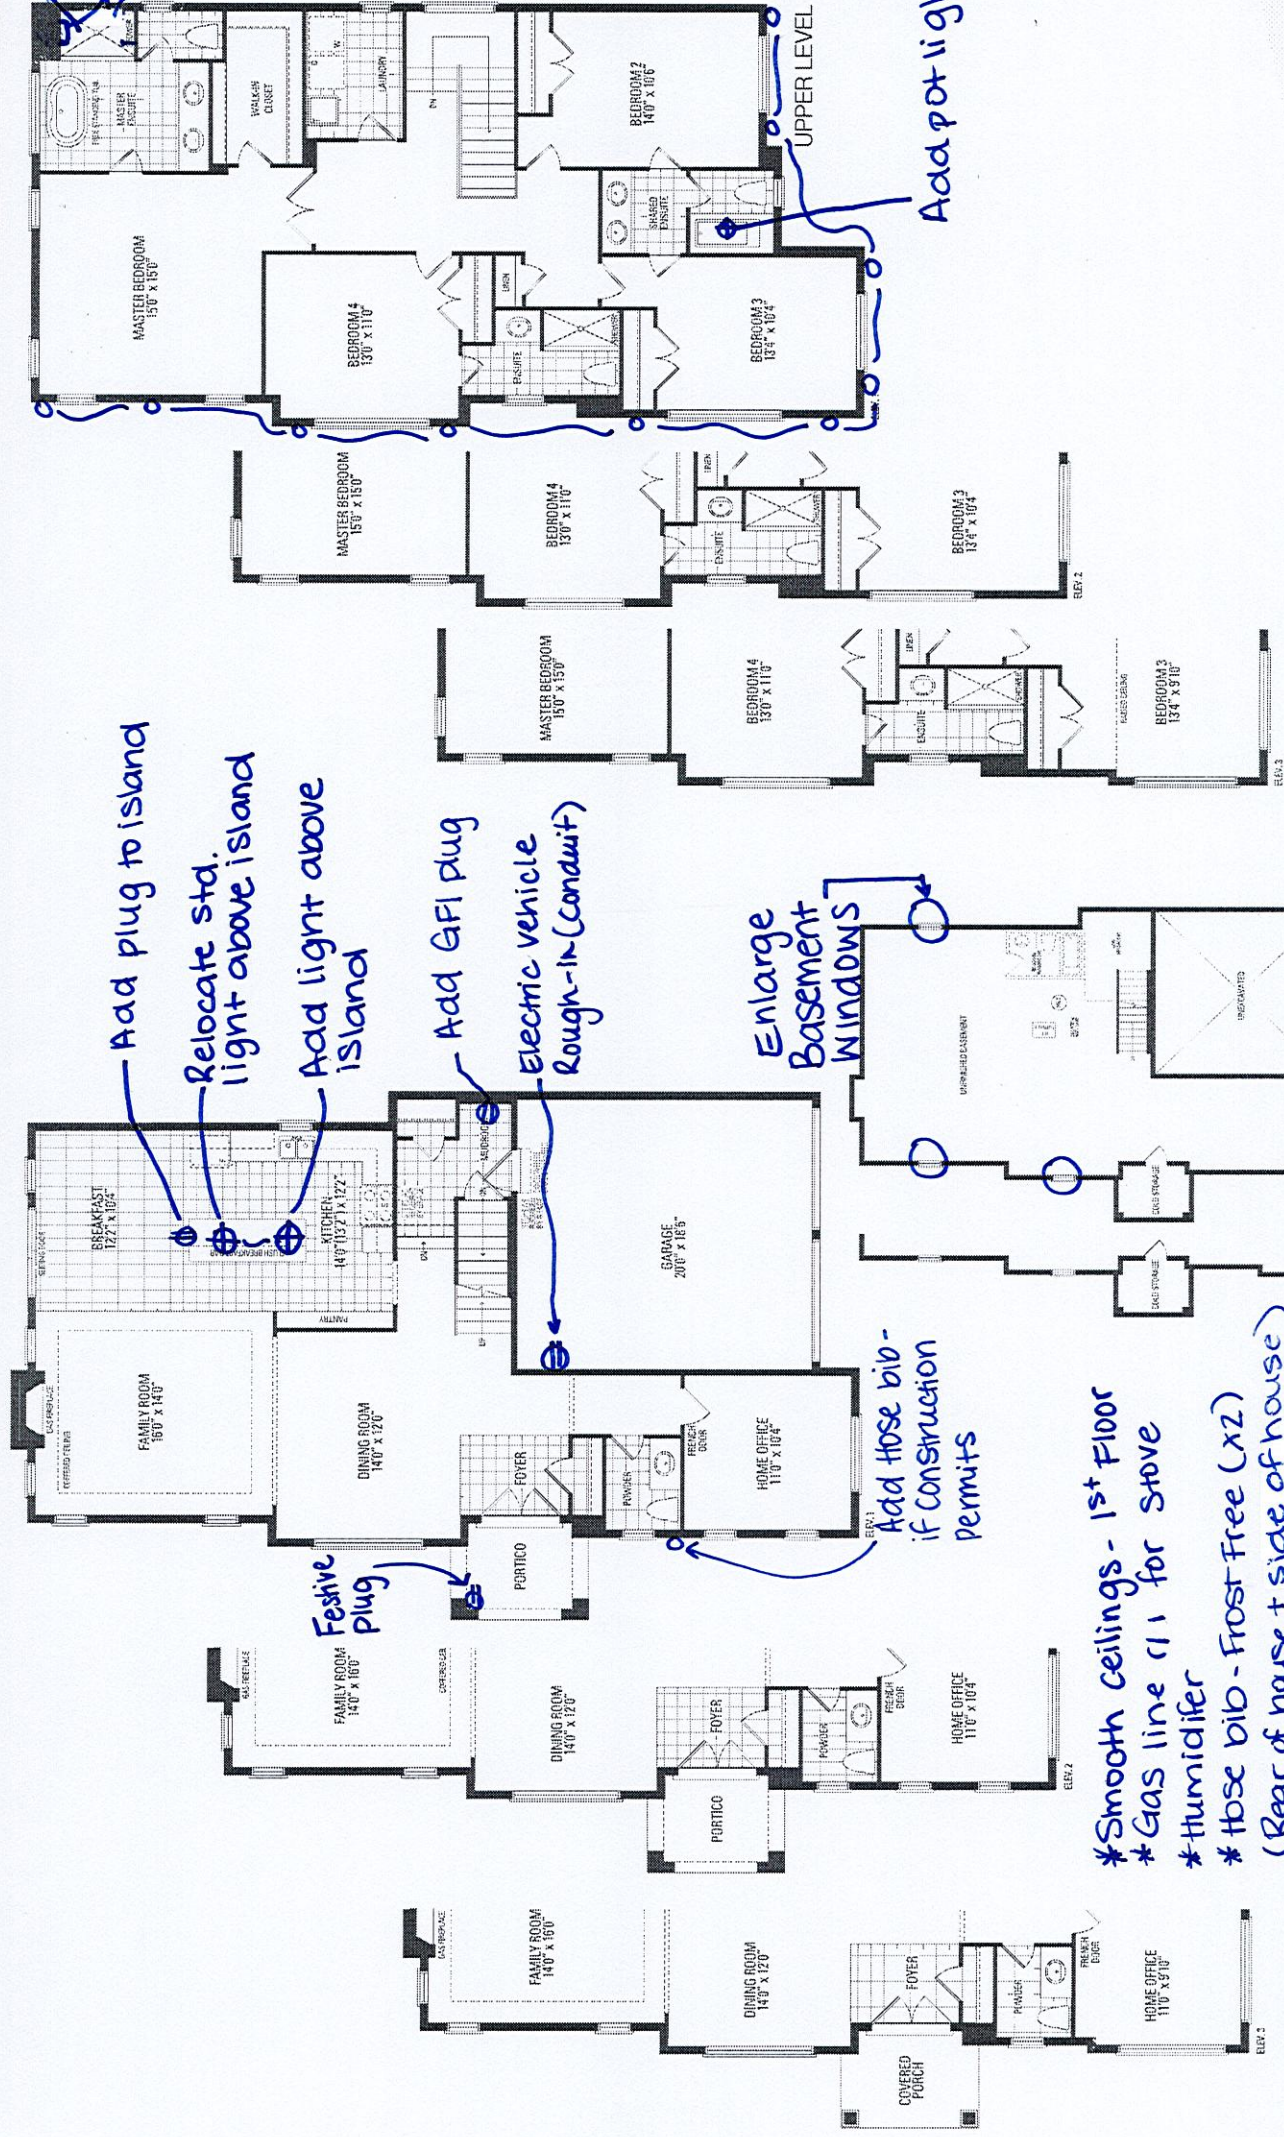

Add top
shampoo
Niche 14"x2"
on back wall
mosaic
Feat. Wall

10 pots on
1 switch

Add pot light

Add plug to island

Relocate std.
light above island

Add light above
island

Add GFI plug

Electric vehicle
Rough-in (Conduit)

Enlarge
Basement
Windows

Add hose bib -
if construction
permits

*Smooth ceilings - 1st Floor
*Gas line (1" for stove)
*Humidifier
*Hose bib - Frost Free (x2)
(Rear of house + side of house)

*10' ceiling - 1st Floor

*8'-6" concrete pour