
## LOT 065

TRINIGROUP

CAROL 12 ELEVATION 2

## REVISION:

- 1. ROOF OVER GARAGE DROPPED BY 24"
- 2. 10" PRECAST CONC. ARCHED HEADER WITH KEYSTONE OVER GARAGE DOORS AS PER SKETCH

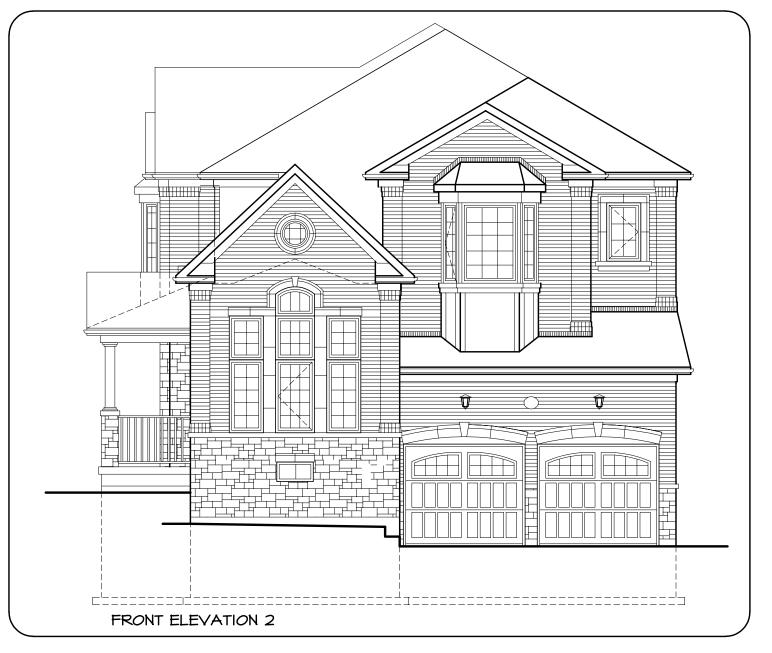

## FRONT ELEVATION

DISCLAIMERS: SKETCH NOT TO SCALE. DIMENSIONS, SPECIFICATIONS AND ARCHITECTURAL DETAILS SUBJECT TO MODIFICATION BY THE VENDOR. SKETCH IS ONLY FOR THE REGION PURPOSE OF ILLUSTRATING REVISIONS REQUESTED BY THE PURCHASER AND ALL REVISIONS ARE SUBJECT TO VENDOR'S FINAL APPROVAL. ONLY REVISIONS ACCEPTED IN WRITING BY THE PURCHASER AND VENDOR ON A PURCHASER'S EXTRA SHEET WILL BE INCORPORATED INTO THE PLANS FILED WITH THE MUNICIPALITY. E. & O.E.



PAGE No.

